

FILED DEC 4 2007

Nov. 7, 2007

T. 26-3-400700

NW COR. SEC. 3

FD. OK, 4 LIVE BT'S

NOTE: FENCE CORNER WITH
FENCES EXTENDING SOUTH
& WEST BEARS NBTW 10.5 FT.

T. 26-3-440700

NORTH 1/4 COR. SEC. 3

FD. OK, 3 LIVE BT'S


T. 26-3-500700

NE COR. SEC. 3


FD. OK, 4 LIVE BT'S

D.C.S.O.

J. P. F. S. FLAUSE

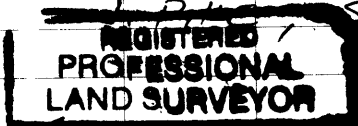

[Handwritten signature]

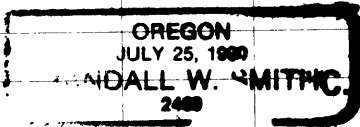

File No 67/24-45

[Handwritten signature] 6-3008

J.L. DARLING CORP TACOMA WA 98424-1017
www.RheintheRain.com

[Small logo]
ALL W/STAMPING PAPER