

GOVERNMENT CORNER RESTORATION FORM

FILED

Date: 12/10/07 By: SC

Township 26S Range 3W Sec. 35

County DOUGLAS

This survey consists of:

State OR

Date 12/5/07

No. 600140

Map: _____


Narrative: _____

Corner Rpt: 67/24-51

Corner Designation

DOUGLAS COUNTY
SURVEYOR

- Condition Report Only
- Not Found
- Renewed
- Unrecorded
- Surveyed In
- Referenced Out

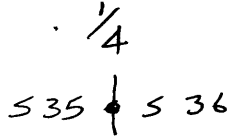


MONUMENT DETAIL

Previous Renewals 1981

Monument(s) Found: (Condition and Source)

3/4" DIA. ALUM CAP, PROPERLY MARKED
ON 2 1/2" O.D. ALUM POST, FIRMLY SET,
PROJECTS 6" ABOVE GROUND.

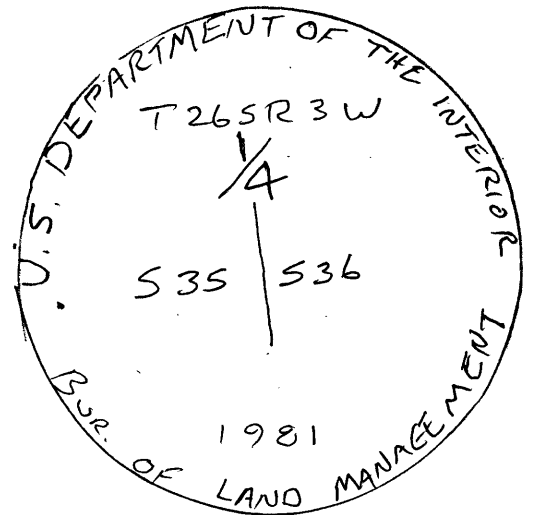

Accessories Found:

- 40" NOW INDETERMINATE DIA. X 2 FT TALL VERY ROTTED
FIR STUMP. EVIDENCE OF SAWN OPEN BLAZE. BEARS
S 56° E, 10.4 FT. (REC. S 45° E, 9.2 FT.) 83T
- 6" NOW 12" DIA. G. FIR, HEALED DOUBLE BLAZE
BEARS N 87° W 11.2 FT. (AGREES W/REC) 1981 BT
- 6" NOW 9" DIA UPROOTED WINDFALL D. FIR FULLY HEALED DOUBLE
BLAZE, ROOT HOLE AGREES WELL W/REC. (S 29 1/2° E, 5.6 FT)
1981 BT

C.S. File No 67/24-51

