

GOVERNMENT CORNER RESTORATION FORM

FILED

Date: 12/10/07 By: JC

Township 28S Range 4W Sec. 13

County DOUGLAS This survey consists of:

State OR Date 12/3/07

No. 640440 Narrative: \_\_\_\_\_

Corner Designation

Corner Rpt: 67/24-52


C 1/4 S 13

- DOUGLAS COUNTY
- Cond. Survey Report Only
- Not Found
- Renewed
- Unrecorded
- Surveyed In
- Referenced Out

Previous Renewals BLM 1965

Monument(s) Found: (Condition and Source)

3" D.I.A. BRASS CAP, PROPERLY  
 MARKED, FIRMLY SET ON 2 1/2" O.D.  
 IRON POST, PROJECTS 4" ABOVE  
 GROUND

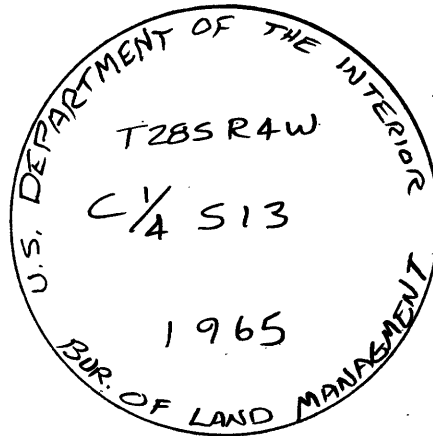

Accessories Found:

- 28" NOW 28" D.I.A. X 4 FT. TALL ROTTING FIR STUMP,  
 FULLY HEALED SINGLE BLAZE VS. BEARS S 39° W, 33.0 FT.  
 AGREES W/REC.
- 7" NOW 14" D.I.A. X 2 FT TALL SNAPPED OFF FIR STUMP,  
 TAG VISIBLE ON SNAPPED OFF TOP ALONG-SIDE. STUMP  
 BEARS S 19° E, 64.7 FT. AGREES W/REC.

C.S. File No 67/24-52

