

RENEWAL

Monument Detail

Monument Set (Procedure and Description)

THE LOCATION FOR THE MONUMENT IS DETERMINED BY MEASURING THE RECORD BEARING AND DISTANCE FROM THE FOUND MADRONE BEARING TREES. THE GOOD DISTANCE TO THE FIR STUMP BT COULD REASONABLY BE EXPLAINED BY THE GENERAL DIRECTION OF THE HILLSLIDE SLUMP.

AT THE ABOVE LOCATION IS SET A 2 3/8 INCH DIAMETER BRASS CAP (MARKED AS AT RIGHT) ON 1 1/2 INCH OD, 32 INCH LONG IRON PIPE. MONUMENT IS FIRMLY SET AND PROTRUDES 6 INCHES ABOVE GROUND

DOUGLAS CO. SURVEYORS OFFICE

T28S R6W


+
C1/4
1/2/08

New Accessories

AN 11 INCH D.B.H. DOUGLAS FIR SCRIBED "C1/4 S8 CS BT" ON A DOUBLE BLAZE BEARS N24°E, 178 FEET DISTANT.

A 15 INCH D.B.H. DOUGLAS FIR SCRIBED "C1/4 S8 CS BT" ON A DOUBLE BLAZE BEARS S86°E, 298 FEET DISTANT.

Sketch of Monument, Accessories, and General Area

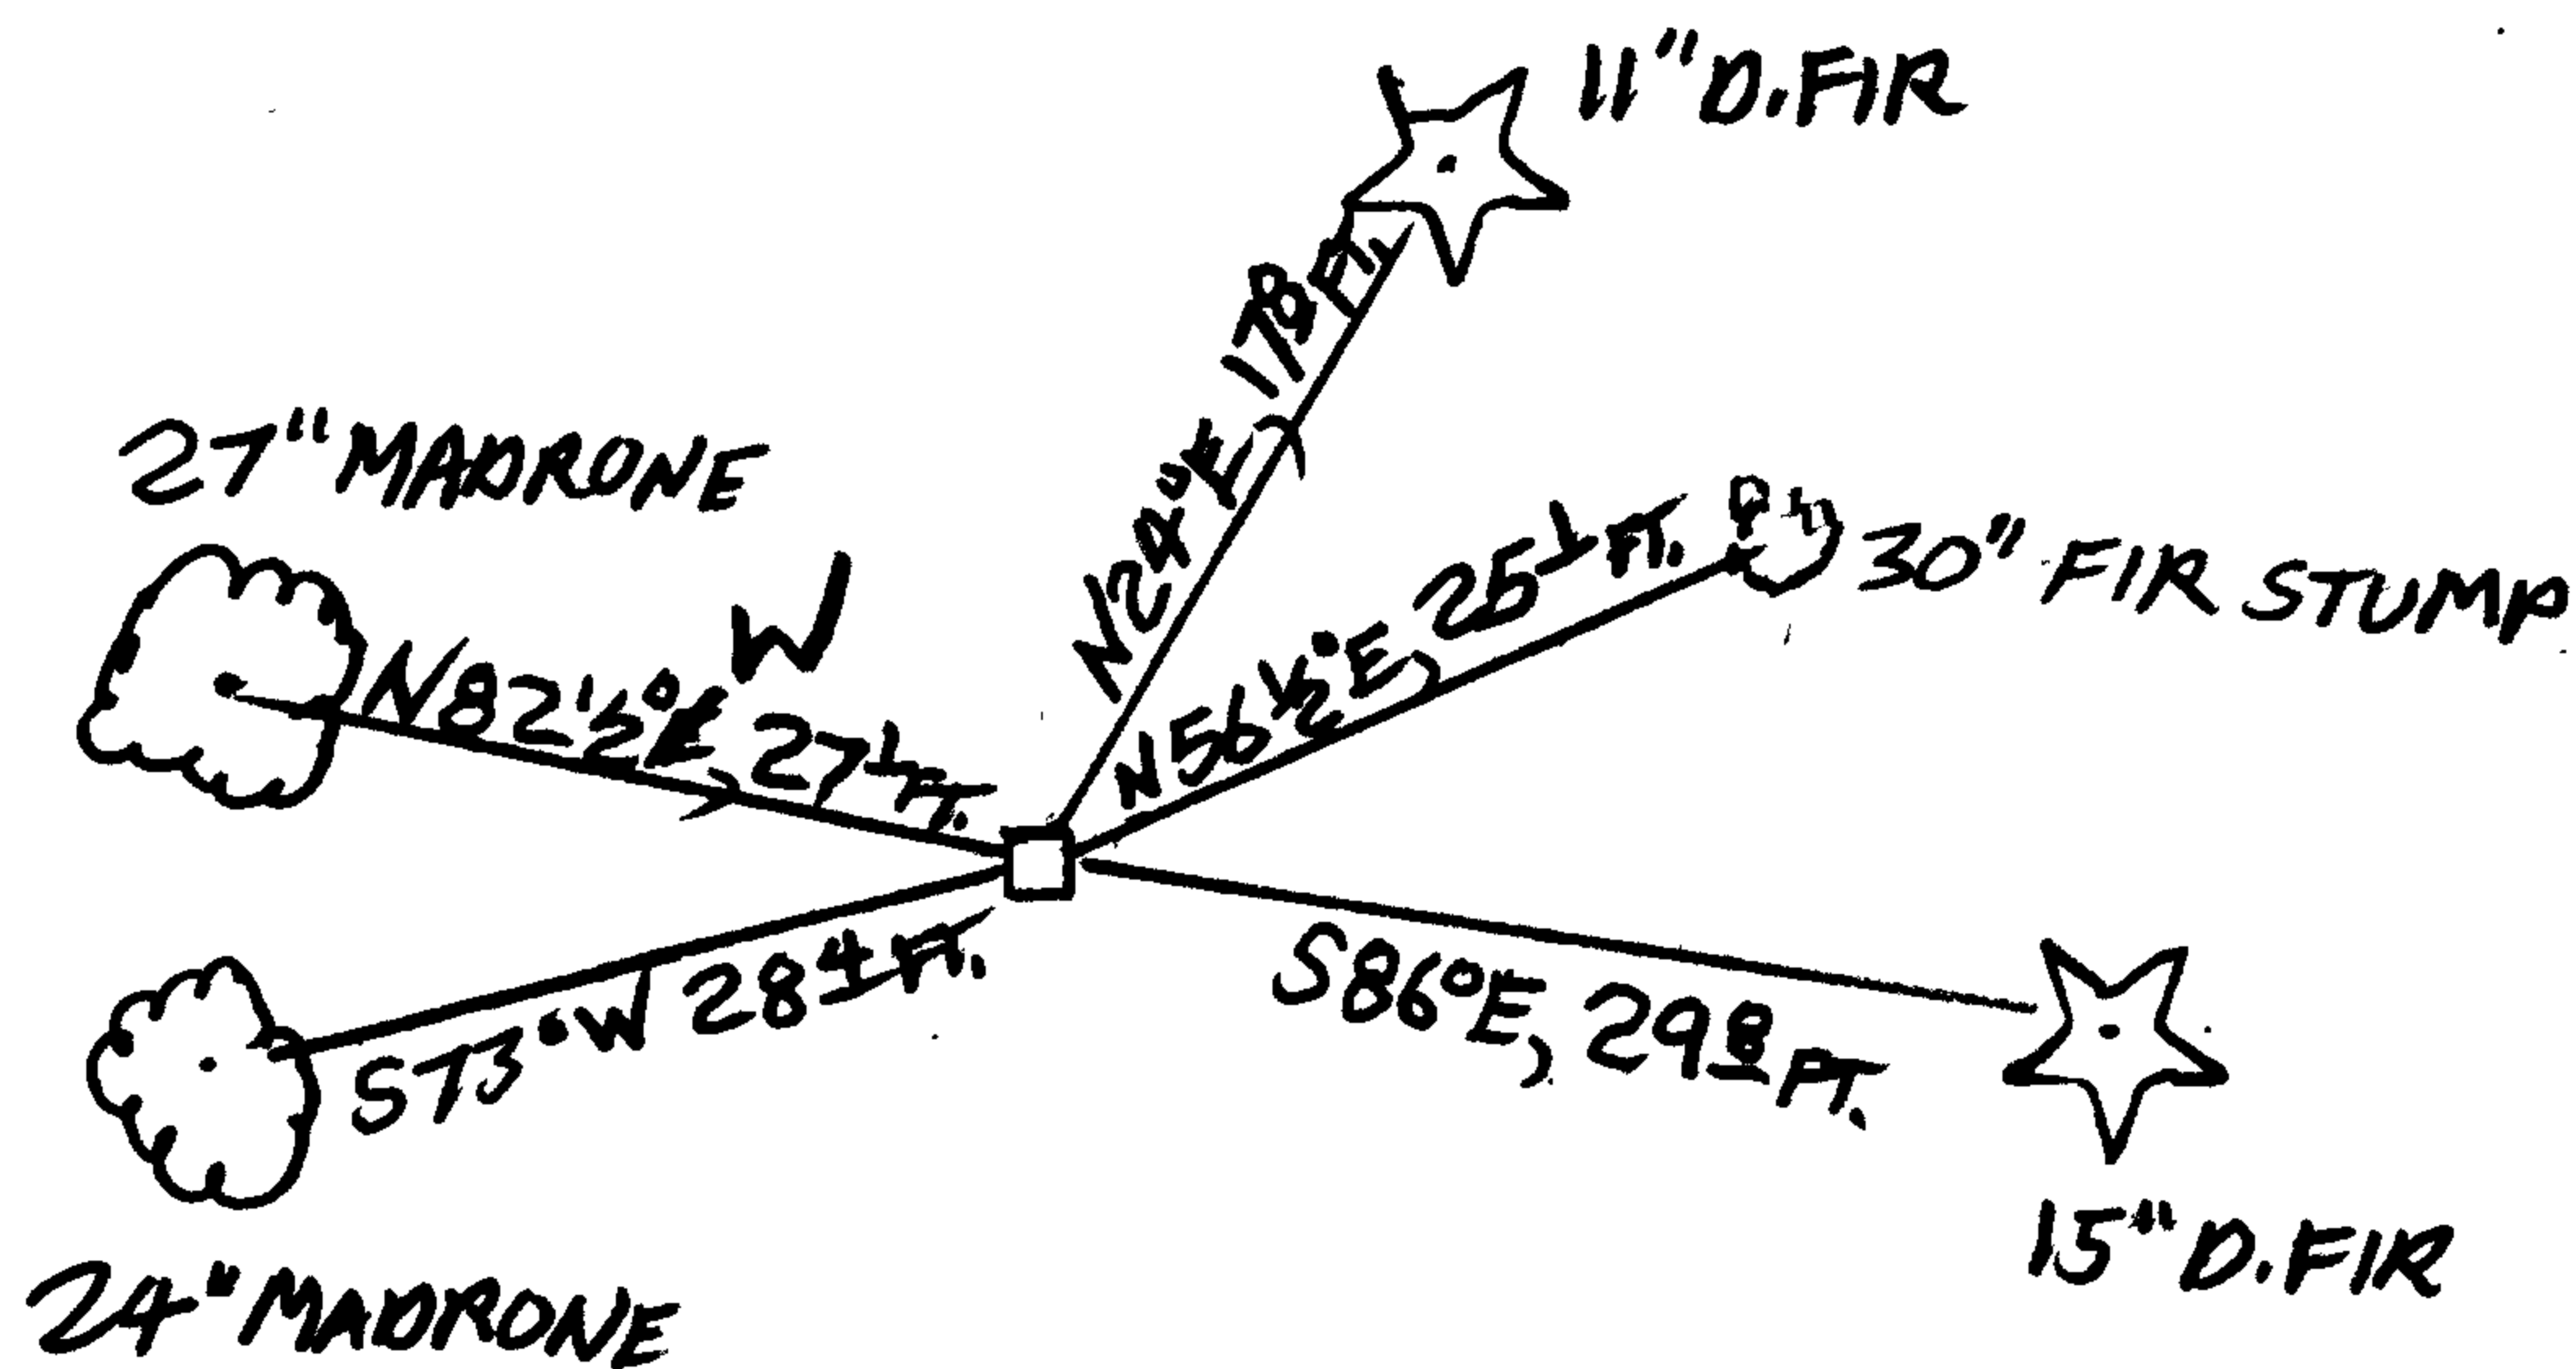

(NO SCALE)

Location & Comments

MONUMENT IS ON SLIGHT BENCH ON FAIRLY STEEP NORTHERLY FACING SLOPE. MONUMENT IS NEAR TOP OF AND ON NORTH SIDE OF RIDGE FORMING SOUTH SIDE OF HAPPY VALLEY

Comp. Declin. 16 1/4° E
Agency DCSO
Party Chief S.J. FLAUSE
Notekeeper Stephen John Flause
Witnesses KODY W. INDA, RAYMOND BROWN

Address

Surveyor's Seal

REGISTERED PROFESSIONAL LAND SURVEYOR

Handwritten signature of Randall W. Smith
Renewed 6-30-00

OREGON
JULY 25, 1900
RANDALL W. SMITH
2400