

FILED

GOVERNMENT CORNER RESTORATION FORM

Date: 2/8/2008 By: JR

Township 26S Range 3W Sec. 20 County DOUGLAS

This survey consists of:
Map: _____

State OR Date FEB 5, 2008 No. 240348

Narrative: _____
Corner Rpt: 67/25-7

Corner Designation

C 1/4 SEC. 20

DOUGLAS COUNTY

SURVEYOR


- Condition Report Only
- Not Found
- Renewed
- Unrecorded
- Surveyed In
- Referenced Out

Previous Renewals SET 1985

MONUMENT DETAIL

Monument(s) Found: (Condition and Source)

3/8" I.R. w/YELLOW PLASTIC CAP
 MARKED R.E. WARE LS 1005
 6" BELOW SURFACE

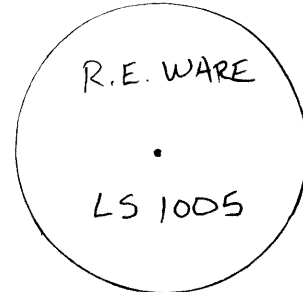

Accessories Found:

6" NOW 16" DIA X 8" TALL D. FIR STUMP, OPENED
 AND FOUND SCRIBE MARKS "BT", BEARS N 71°E, 113.4 FT.
 (AGREES W/REC.)

A ROOT HOLE IS FOUND NEAR REC. BRG & DIST. WHERE
 TRIPLE TRUNK OAK STOOD. (REC. S 2°E, 54.5 FT.)

C.S. File No 67/25-7

