

FILED

GOVERNMENT CORNER RESTORATION FORM

Date: 2/19/2008 By: JC

This survey consists of:

Township 29S Range 5W Sec. 33 County DOUGLAS

State GR Date FEB. 7, 2008 No. 340100

Narrative:  
Corner Rpt: 67/25-8

Corner Designation

SOUTH 1/4 COR SEC. 33 ONLY

DOUGLAS COUNTY  
SURVEYOR

Condition Report Only

Not Found

Renewed

Unrecorded

Surveyed In

Referenced Out

MONUMENT DETAIL

Previous Renewals

Monument(s) Found: (Condition and Source)

2 1/2" DIA. BRASS CAP (MARKED AS SHOWN) ON 1 1/4" O.D. IRON PIPE BC/IP HAD BEEN DISTURBED AND LEANED 0.8' WESTERLY

SEE BACK PAGE  
MON. DETAIL

Accessories Found:

ALL ACCESSORIES MISSING DUE TO EXCAVATION OF NEW SUBDIVISION LOTS TO NORTH.


RENEWAL

Monument Set (Procedure and Description)

Monument Detail

DUG DOWN & LOCATED PLUMB  
 POSITION OF BC/IP, REFERENCED THIS  
 POSITION, REMOVED, AND RESET BC/IP  
 AT REFERENCED POSITION.

STAMPED "RESET 2008" ON BC

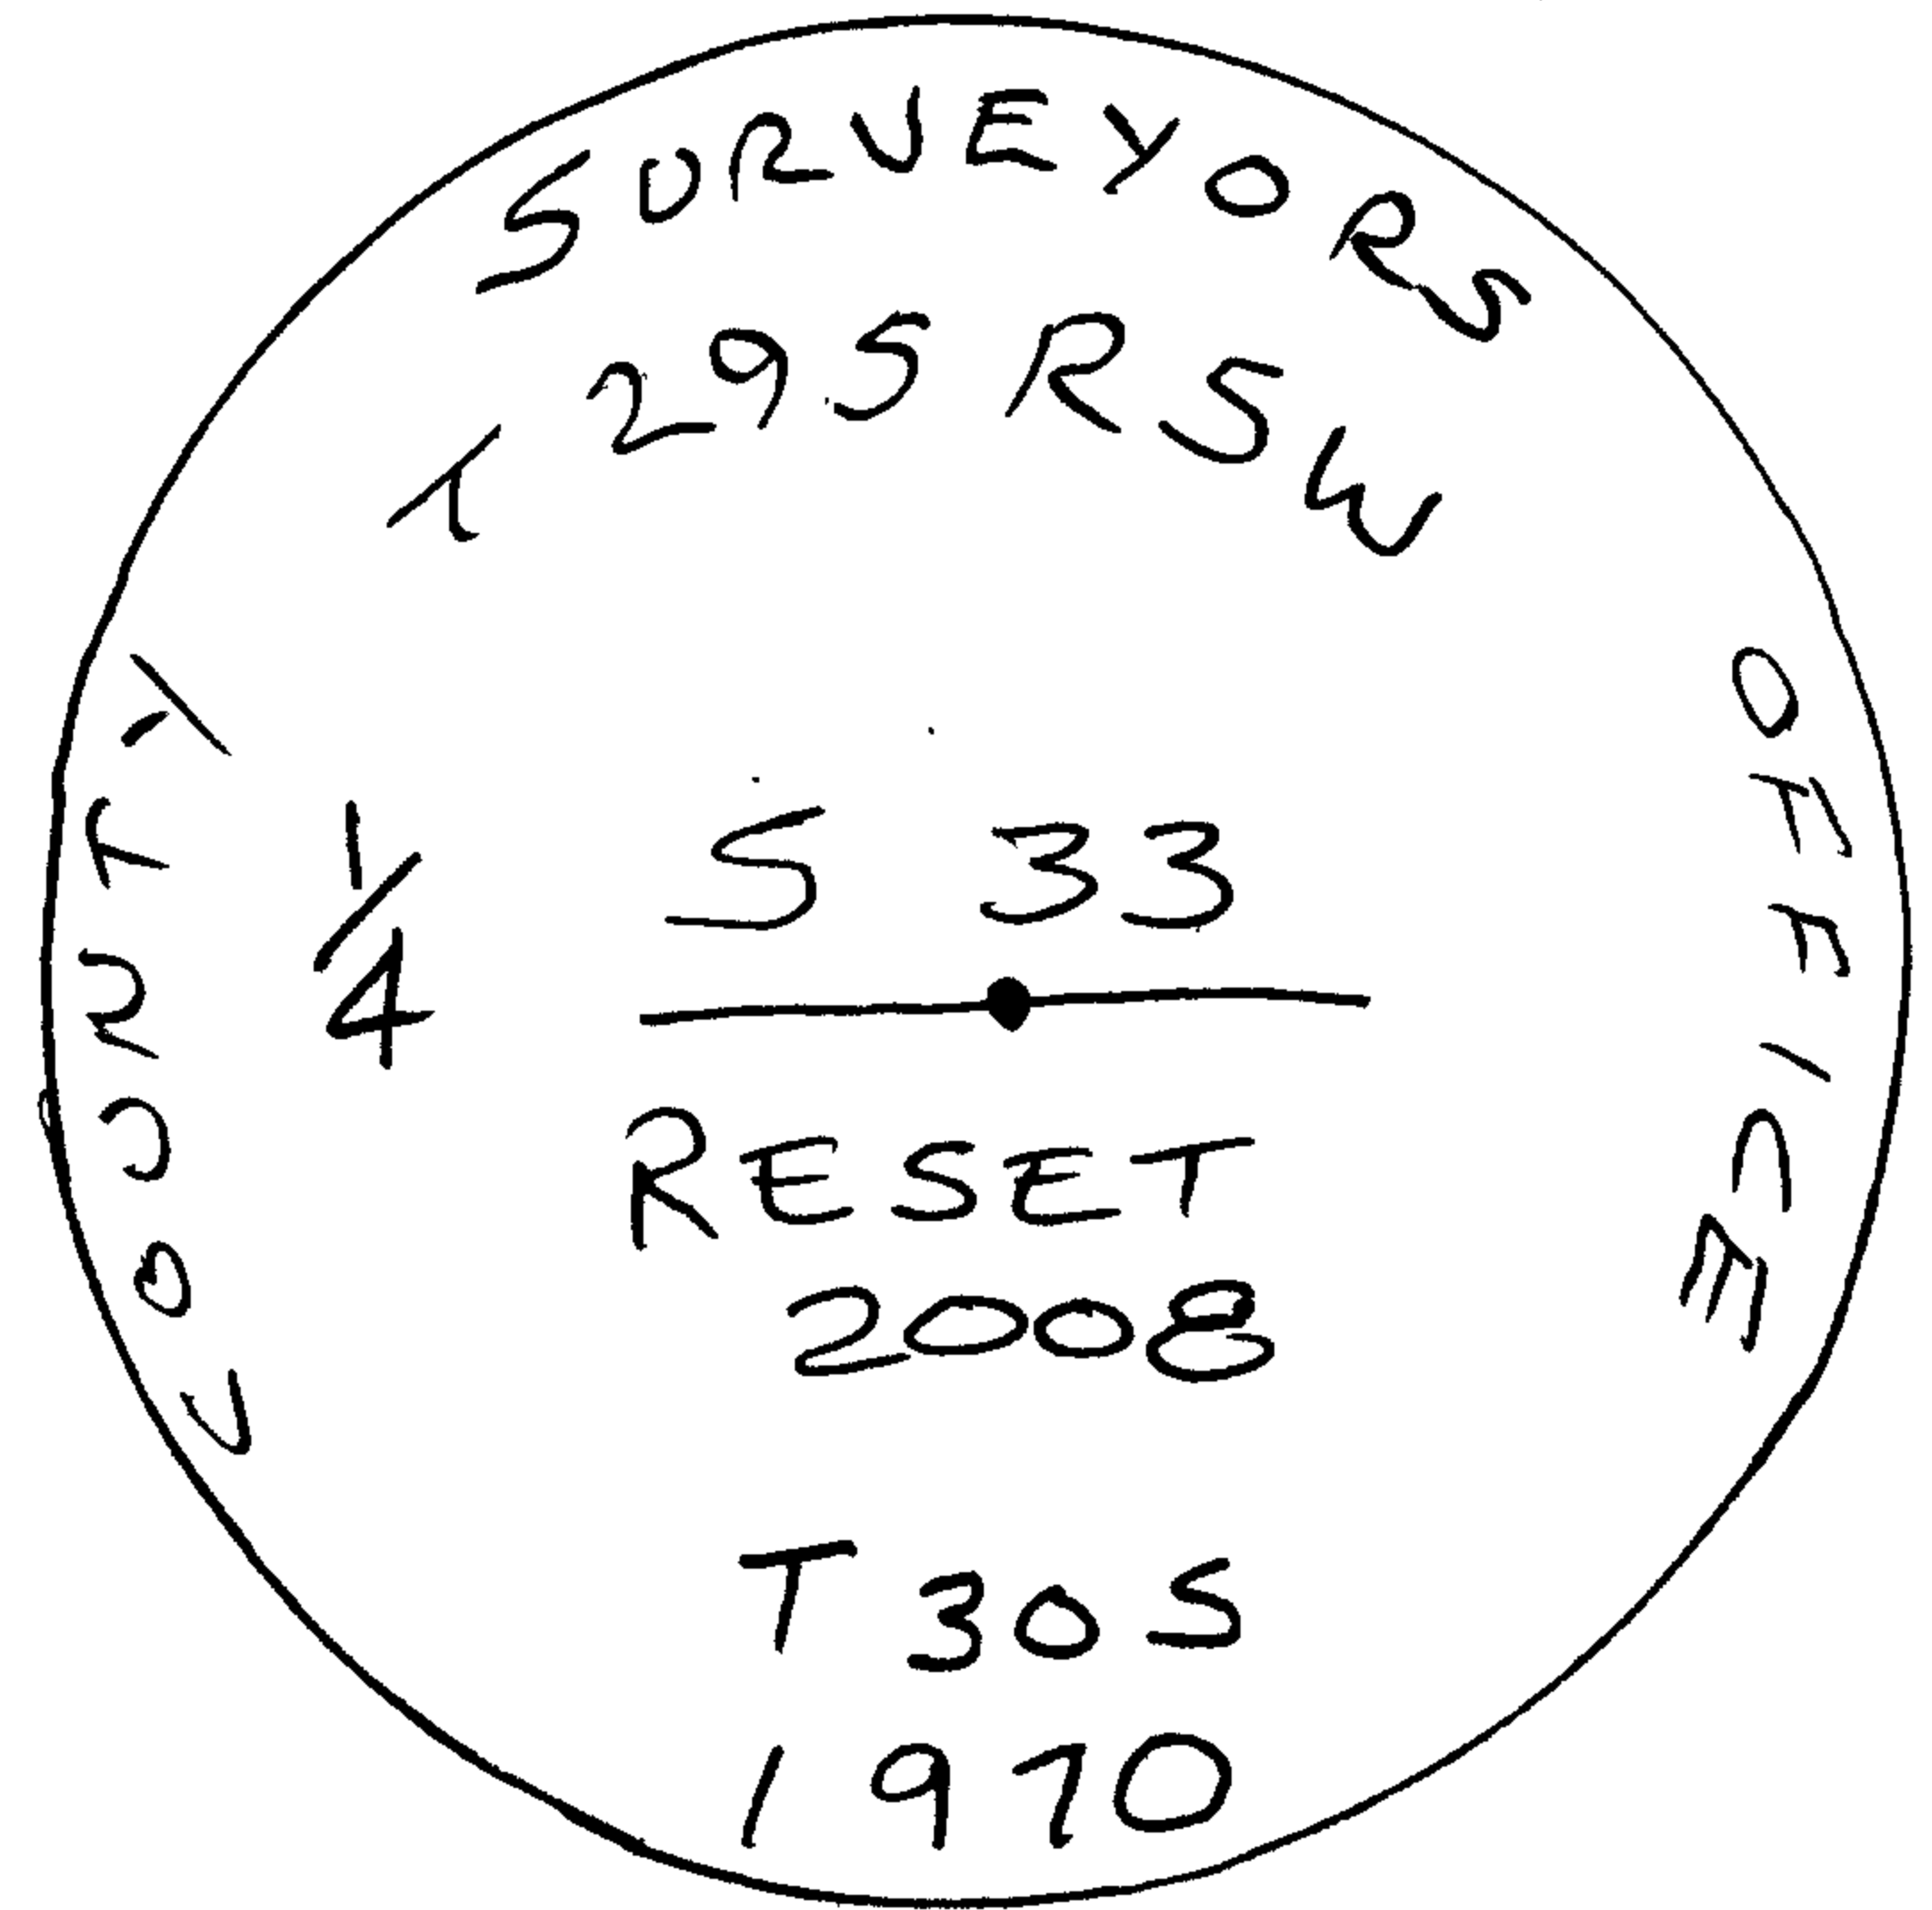

New Accessories

- 12" DIA. W. OAK, DOUBLE BLAZED & SCRIBED "1/4 S 33 <S> 13T"  
 BEARS S 82 1/4° E, 30.0 FT.
- BRASS CAP AT N 1/4 COR. SEC. 4 ONLY BEARS EASTERLY 97.87 FT. SEE M 39-45

*And* NO OTHER ACCESSORIES WERE CREATED AT THIS TIME BECAUSE BC/IP IS  
 SHOWING ~~NO~~ ~~BEING~~ ~~A~~ ~~BEING~~ ~~CORNER~~ IN VILLAGE VIEW SUBD. 17th. & P AND  
 WILL HAVE DIRECT TIES TO OTHER PROPERTY CORNERS IN SUBD.

Sketch of Monument, Accessories, and General Area


Location & Comments

\_\_\_\_\_  
 \_\_\_\_\_  
Comp. Declin. 16 1/4° E  
 Agency D.C.S.O.  
 Party Chief S. FLAUSE  
 Notekeeper J. PIKE  
 Witnesses \_\_\_\_\_

Address \_\_\_\_\_

Surveyor's Seal

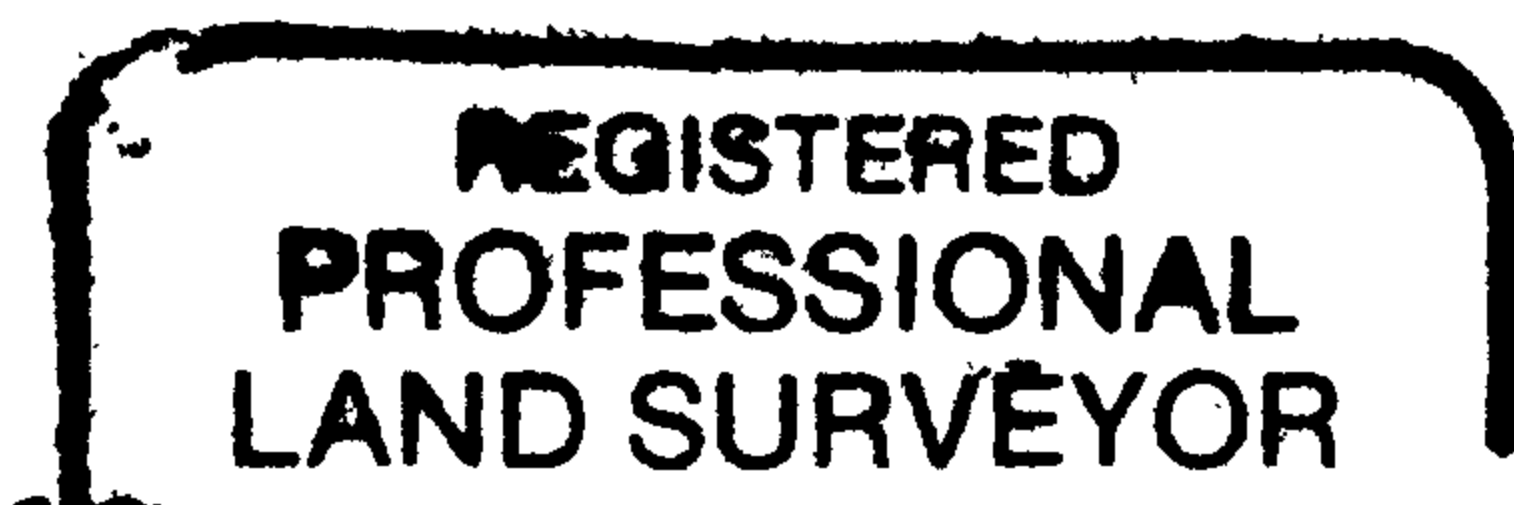

*Renewal 6-30-08*

