

FILED FEB 19 2008

FEB. 6, 2008

T. 26-3-100340 W 1/4 S. 19

FD. B.C./IP & ALL ACCESS.

OK AS PER NOV. 2000

D.C.S.O. RENEWAL.

FEB. 12, 2008

T. 26-3-140100 S 1/4 S. 31

FD. 1 1/2" IRON PIPE & ALL

ACCESSORIES OK AS PER

JULY 2001 M. SMALLEY

RENEWAL.

FEB. 12, 2008

T. 26-3-240200 1/4 <sup>529</sup>/<sub>530</sub>

FD. B.C./IP & ALL ACCESSORIES

AS PER DEC. 1994 D.C.S.O.

REN. NOTE: PARTIAL HEALED

BLAZE ON 6" ASH

(OVER) C.S. File No 67/25-12

(REC. S 7 1/2° E, 29.5 FT.)


REVEALS IT IS INDEED

SCRIBED "1/4 S 32 CS BT"


J. PIKE

S. FLAUS

D. C. S. O.

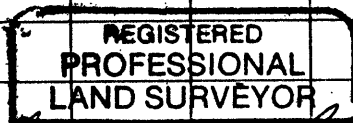

*Randall W. Smith*

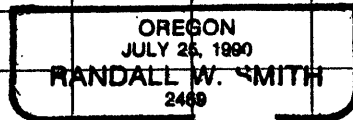

RENEWAL 6-30-08