

FILED

GOVERNMENT CORNER RESTORATION FORM

Date: 4-17-2008 By: JC

This survey consists of:

Township 265 Range 3 W Sec. 9

County DOUGLAS

State OR

Date FEB. 28, 2008

No. 340517

Narrative: \_\_\_\_\_

Corner Rpt: 67/25-25

Corner Designation

DOUGLAS COUNTY  
SURVEYOR

Condition Report Only

Not Found

Renewed

Unrecorded

Surveyed In

Referenced Out


MONUMENT DETAIL

Previous Renewals 1924, 1971

Monument(s) Found: (Condition and Source)

2 1/2" DIA. BRASS CAP ON 1 1/4" O.D.  
I.P. (MARKED AS SHOWN) PROJECTS  
11" ABOVE GROUND.  
NOTE - BC/IP IS SET INTO THE  
WOOD AT THE BASE OF A 42" DIA  
DOUBLE TOP D. FIR. TREE IS ON  
BANK OF RIVER COMPLETELY UNDER-  
MINED BY EROSION AND LEANS  
SOUTHERLY TOWARD RIVER.

PICTURE FILE: 100-1326  
100-1327

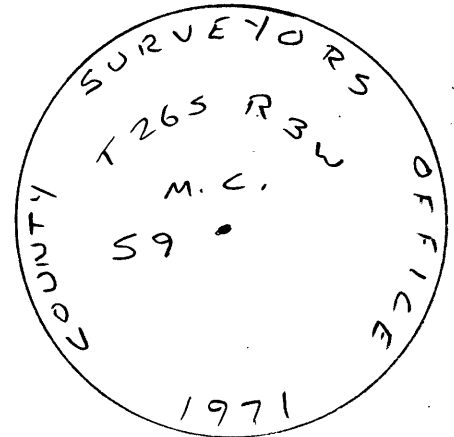

Accessories Found:

18" NOW 31" DIA. D. FIR OLD BLAZE VISIBLE  
BEARS N 13° W 33.7 FT. (REC. N 9° W 33.7 FT.) 1924 BT

C.S. File NO 67/25-25

