

GOVERNMENT CORNER RESTORATION FORM

FILED

Date: 5/22/08 By: X

Township T23S Range 7W Sec. 17

County DOUGLAS Map: _____

State OREGON Date MAY 15, 2008

No. 200400 Narrative: _____

Corner Designation

Corner Rpt: 67/25-49

DOUGLAS COUNTY SURVEYOR

- Condition Report Only
- Not Found
- Renewed
- Unrecorded
- Surveyed In
- Referenced Out

18 | 17
19 | 20

Previous Renewals 1960 DCSD, 1965 BLM, 1979 BLM
Monument(s) Found: (Condition and Source)

1960 BRASS CAP 2 1/2 INCHES IN DIAM. MARKED AS AT RIGHT ON A 1 1/2 INCH D.B. IRON PIPE FIRMLY SET AND PROTRUDING APPROX 15 INCHES ABOVE GROUND

COUNTY SURVEYORS OFFICE

T23S R7W
S18 | S17
S19 | S20
1960

Accessories Found:

REMAINS OF ONE ORIGINAL BT FOUND. A SHATTERED, ROTTEN FIR STUMP OF 30+ INCHES DIAMETER (MEASURED AT GROUND LEVEL) SHOWING EVIDENCE OF OLD BLAZE HEALING SCARS AND OLD AXE MARKS; BEARS S27°W, 19 1/2 FEET DISTANT AS PER RECORD.

FROM THE 1960 DCSD RENEWAL EVIDENCE OF TWO B.T.S FOUND. A 28" MAPLE NOW A SHATTERED, APPROXIMATELY 20 INCH D.B.H., MAPLE WITH UPPER PORTION AND SCRIBED LOWER TRUNK FALLEN FACE DOWN TOWARD CORNER; BEARS S65°W, 36 1/2 FEET DISTANT (AS PER RECORD). A 16" R. FIR NOW A 20 INCH DIAMETER, 1 1/2 FOOT TALL D. FIR STUMP WITH EVIDENCE OF A HEALED BLAZE AND PARTIAL REVERSE SCRIBING; BEARS S20°E, 38 1/2 FEET DISTANT (AS PER RECORD).

FROM THE 1965 BLM RENEWAL EVIDENCE OF TWO B.T.S FOUND. A FIR 4" DIAM. NOW A 2 1/4 INCH DIAMETER, 1 1/2 FOOT TALL D. FIR STUMP SHOWING EVIDENCE OF A FULLY HEALED DOUBLE BLAZE; BEARS S28 1/4°E, 17 1/2 FEET DISTANT (AS PER RECORD). A W. FIR 2 1/4" DIAM. NOW A 3 1/2 INCH D.B.H. WHITE FIR WITH A FULLY HEALED DOUBLE BLAZE BEARS N7°W, 77 1/2 FEET DISTANT (AS PER RECORD).

C.S. File No 67/25-49

RENEWAL

Monument Set (Procedure and Description)

Monument Detail

N/A


N/A

New Accessories

- AN 8 INCH D.B.H. MAPLE SCRIBED "T23S R7W S19 CS BT" ON A DOUBLE BLAZE; BEARS S53 3/4°W, 86 1/2 FEET DISTANT.
- A 12 INCH D.B.H. DOUGLAS FIR SCRIBED "T23S R7W S19 CS BT" ON A DOUBLE BLAZE; BEARS S66 1/2°W, 7 1/2 FEET DISTANT.
- A 13 INCH D.B.H. DOUGLAS FIR SCRIBED "T23S R7W S19 CS BT" ON A DOUBLE BLAZE; BEARS S83 1/2°W, 25 1/2 FEET DISTANT.

Sketch of Monument, Accessories, and General Area

Location & Comments

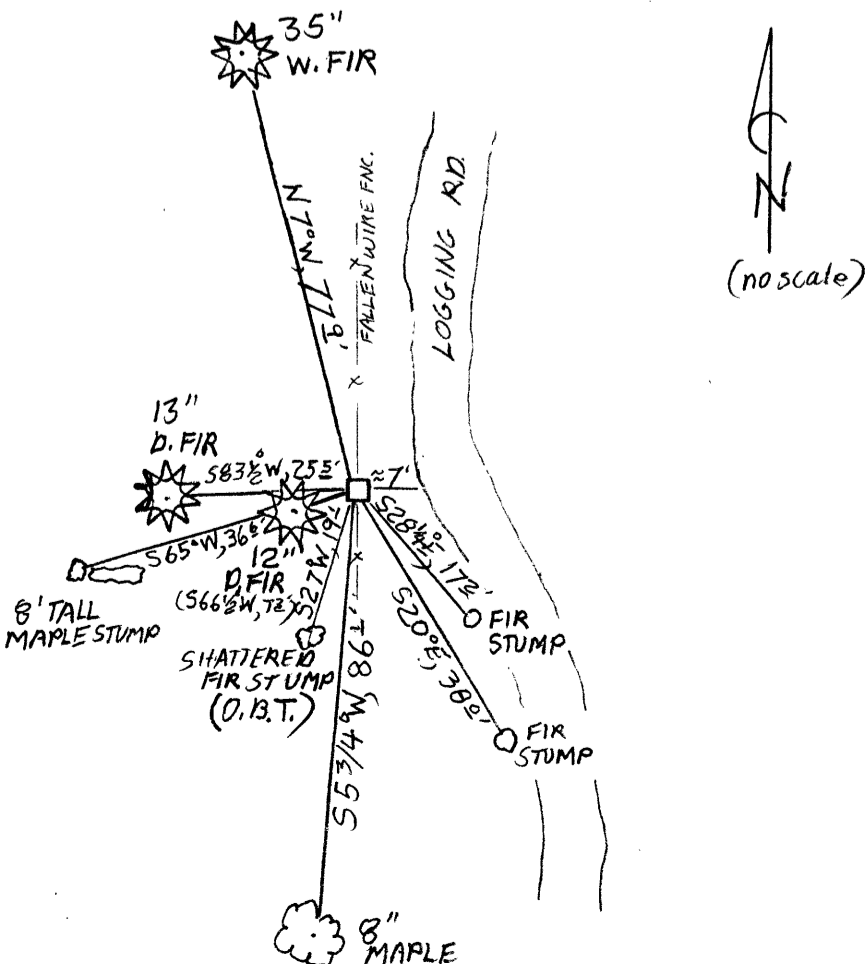

MONUMENT IS NEAR CREST OF A NE-SW RUNNING RIDGE AND JUST SOUTHERLY OF SADDLE IN RIDGE. MONUMENT IS JUST WEST OF TOP OF CUT-BANK OF A LOGGING RD. WHICH IS RUNNING GENERALLY NORTH-SOUTH LOCALLY. LARGE CLEAR-CUTS TO EAST AND NORTHEAST

Comp. Declin. 16 1/4°E
Agency DCSD
Party Chief STEPHEN JOHN FLAUSE
Notekeeper Stephen John Flause
Witnesses Kody Endle

Address

Surveyor's Seal

REGISTERED PROFESSIONAL LAND SURVEYOR

Handwritten signature
RENEWAL 6-30-08

OREGON JULY 25, 1990
RANDALL W. SMITH
2468