

GOVERNMENT CORNER RESTORATION FORM

FILED

Township 28S Range 5W Sec. 13

County DOUGLAS Date: 6-2-2008 By: JC
This survey consists of:

State OR Date 5/21/08

No. 700440 Map: _____

Corner Designation

Narrative: _____
Corner Rpt: CS 67/25-51

EAST $\frac{1}{4}$ S 13

DOUGLAS COUNTY SURVEYOR
Condition Report Only


- Not Found
- Renewed
- Unrecorded
- Surveyed In
- Referenced Out

Previous Renewals BLM 1974

MONUMENT DETAIL

Monument(s) Found: (Condition and Source)

3/4" DIA BRASS CAP, PROPERLY MARKED
ON 2 1/2" O.D. IRON PIPE. PROJECTS
9" ABOVE GROUND, FIRMLY SET.

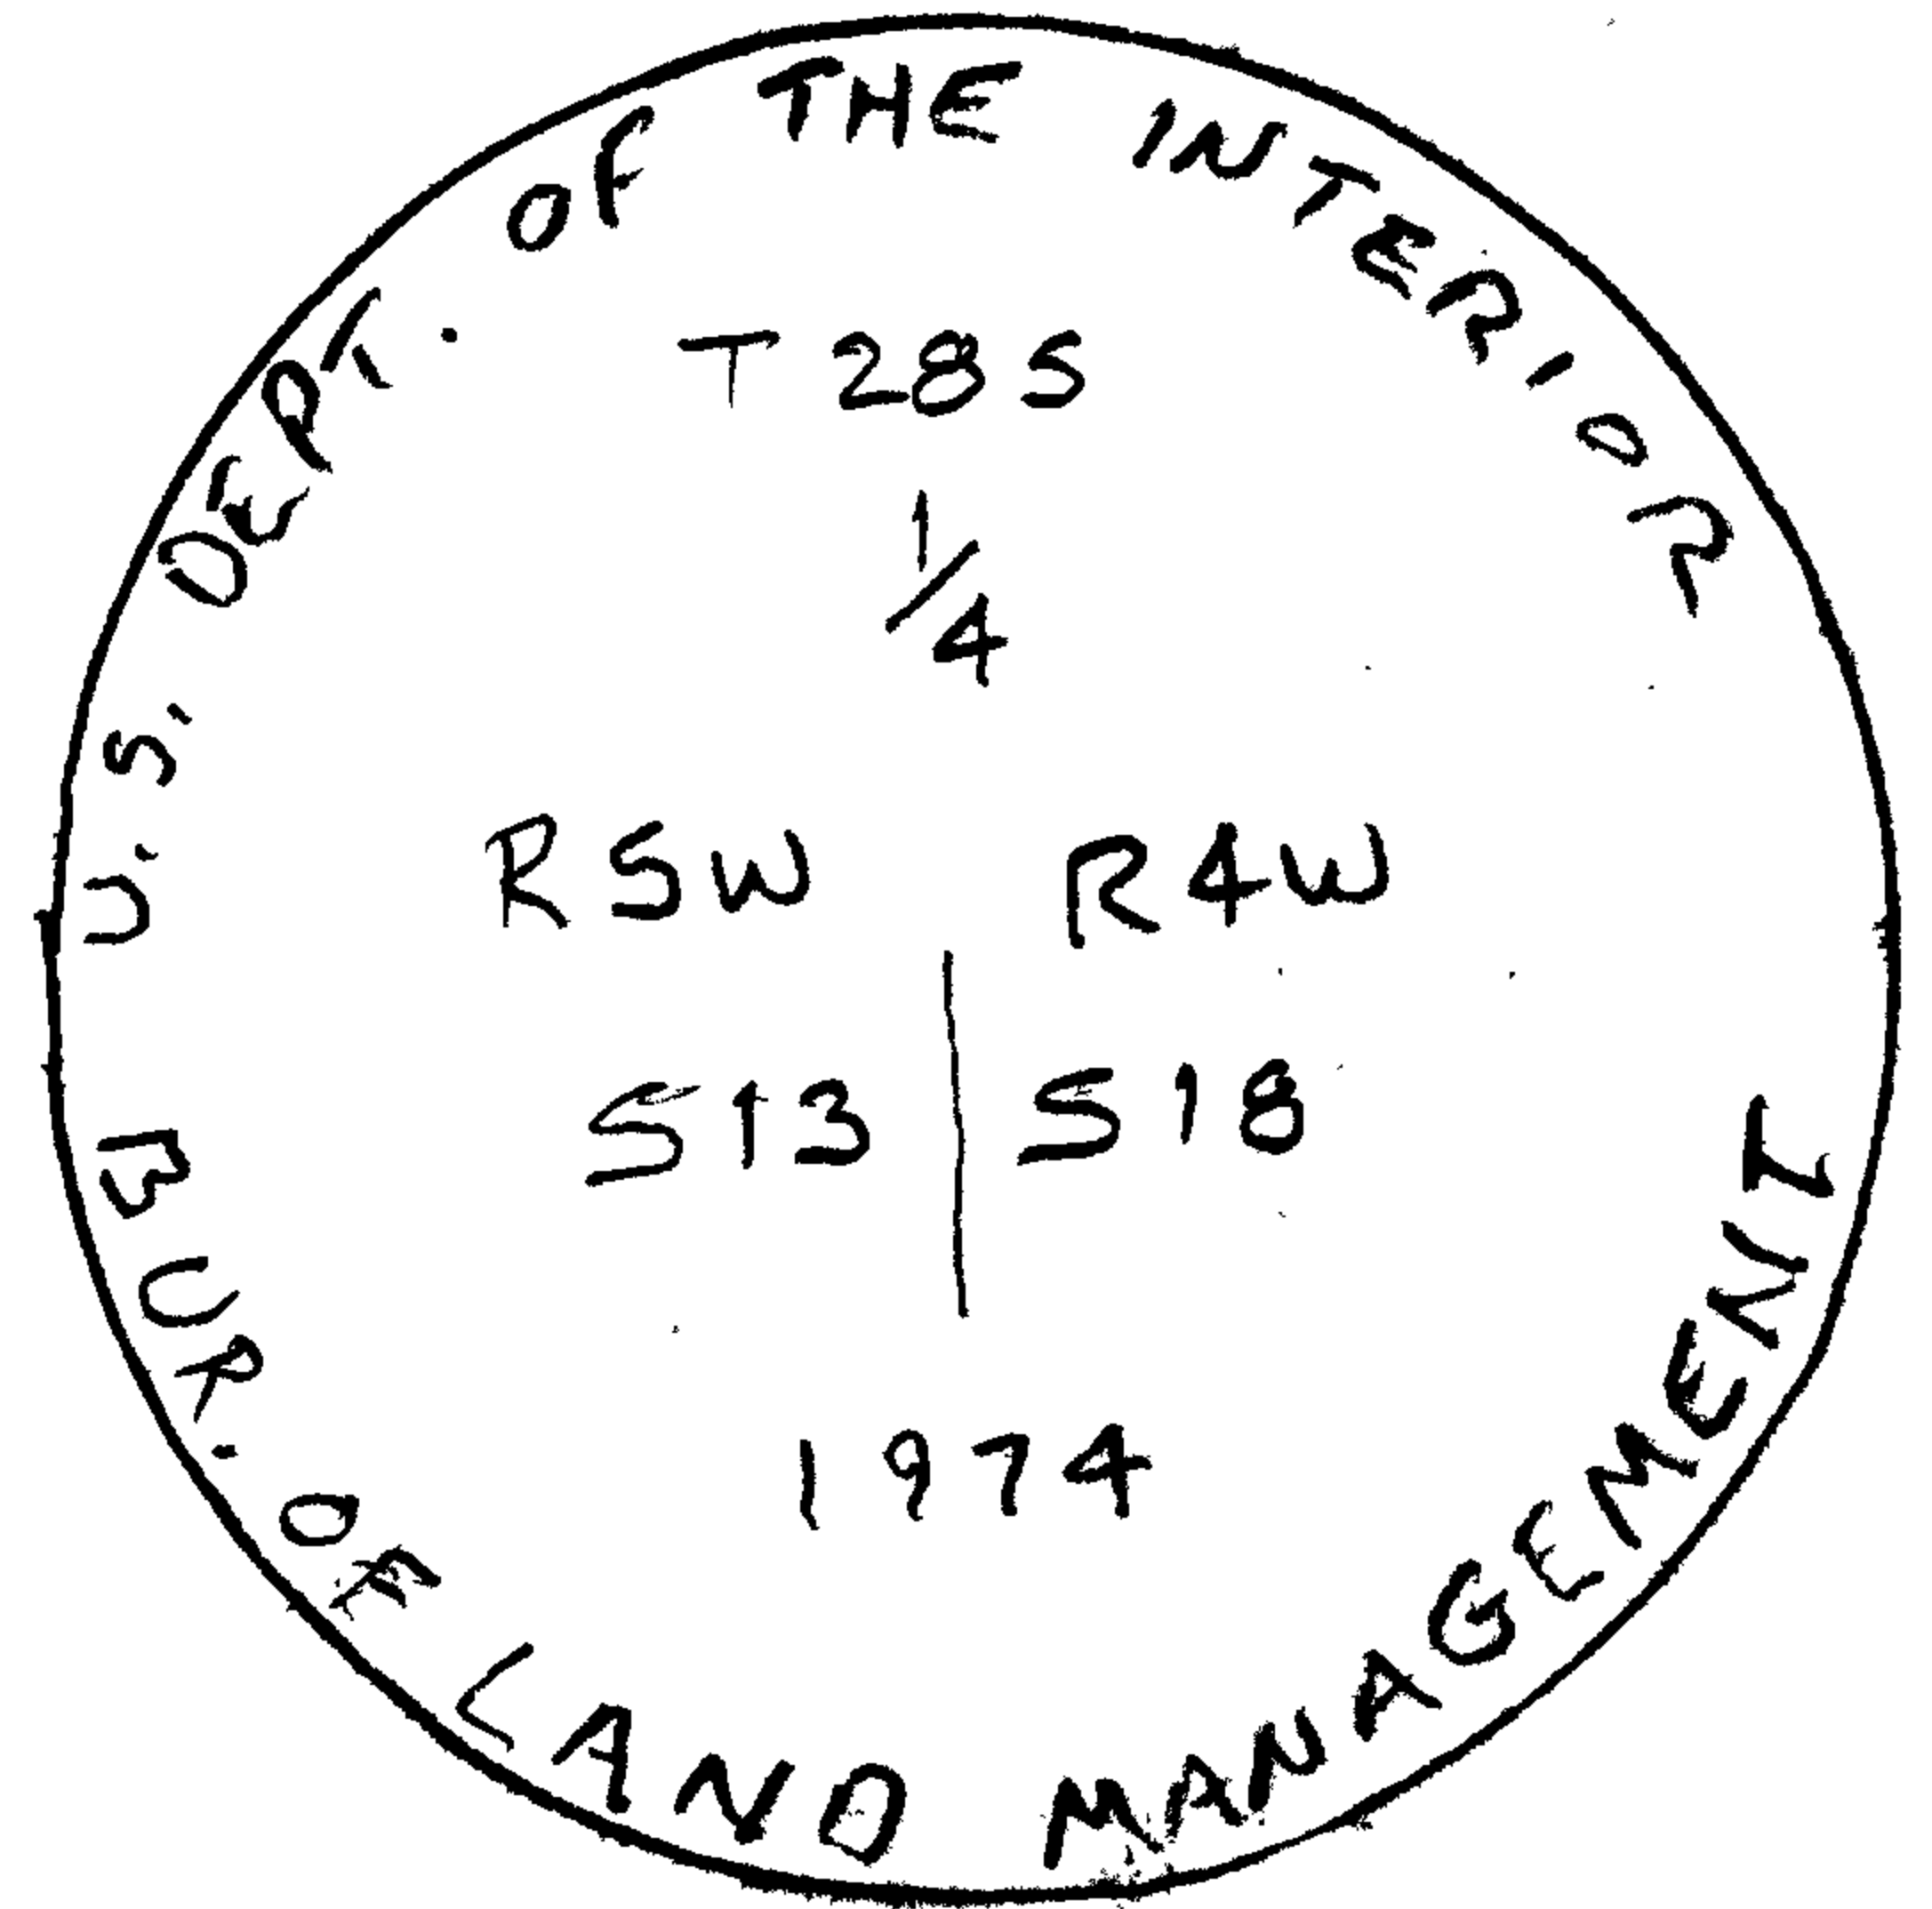

Accessories Found:

8" NOW 25" DIA. X 10" TALL D. FIR STUMP. PORTION
OF LOWER HEALED BLAZE VISIBLE, AS WELL AS CROSS-SECTION
OF FACE. BEARS N 24° E, 47.8 FT. (AGREES W/REC)

8" NOW 18" DIA. X 1 1/2 FT. TALL D. FIR STUMP. PORTION OF LOWER
HEALED BLAZE VISIBLE, AS WELL AS CROSS-SECTION OF FACE.
BEARS S 32 1/2° W, 20.5 FT. (AGREES W/REC)

C.S. File No 67/25-51

