

GOVERNMENT CORNER RESTORATION FORM

FILED

Date: 6-2-2008 By: JC

Township 24 S Range 2 W Sec. 27

County DOUGLAS This survey consists of:

State OR Date MAY 27, 2008

No. 440200 Narrative: _____

Corner Designation

Corner Rpt: C.S. 67/25-53

$\frac{1}{4}$ $\frac{S 27}{S 34}$


- DOUGLAS COUNTY
 Surveyor
 Conducted Only
 Not Found
 Renewed
 Unrecorded
 Surveyed In
 Referenced Out

Previous Renewals B.L.M. 1951

MONUMENT DETAIL

Monument(s) Found: (Condition and Source)

2 1/2" DIA. BRASS CAP MKD. AS PER RECORD, LEANED OVER APPROX S 60° W 1.7 FT.

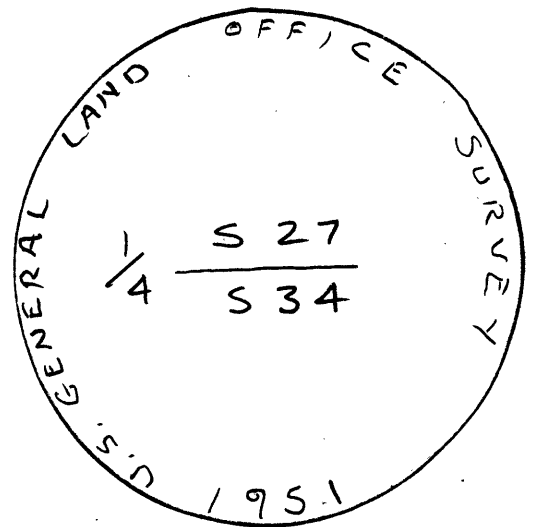

Accessories Found:

12" HEMLOCK NOW 1 FT. TALL STAB FROM CENTER OF TREE. BEARS S 55 1/2° E, 33.0 FT. (AGREES W/REC) 1951 BT

NO TRACE FOUND OF 1951 NE B.T.

RENEWAL

Monument Set (Procedure and Description)

Monument Detail

RETURNED BC/IP TO PLUMB POSITION
WITHOUT COMPLETELY REMOVING.


New Accessories

- DOUBLE TRUNK D. FIR, SOUTHERLY TRUNK IS 14" D.I.A. AND IS SCRIBED "1/4 S 27 CS BT" CENTER OF ROOT CROWN BEARS N 50 1/4° E, 29.6 FT.
- 9" DIA. HEMLOCK, DOUBLE BLAZED & SCRIBED "1/4 S 34 CS BT" BEARS S 65 1/2° E, 1.7 FT.
- 10" DIA. D. FIR, DOUBLE BLAZED & SCRIBED "1/4 S 39 CS BT" BEARS S 86 1/4° W, 11.8 FT.
- 20" DIA. D. FIR, DOUBLE BLAZED & SCRIBED "1/4 S 27 CS BT" BEARS N 12° W, 5.8 FT.

DOUBLE BLAZED *

Sketch of Monument, Accessories, and General Area

Location & Comments

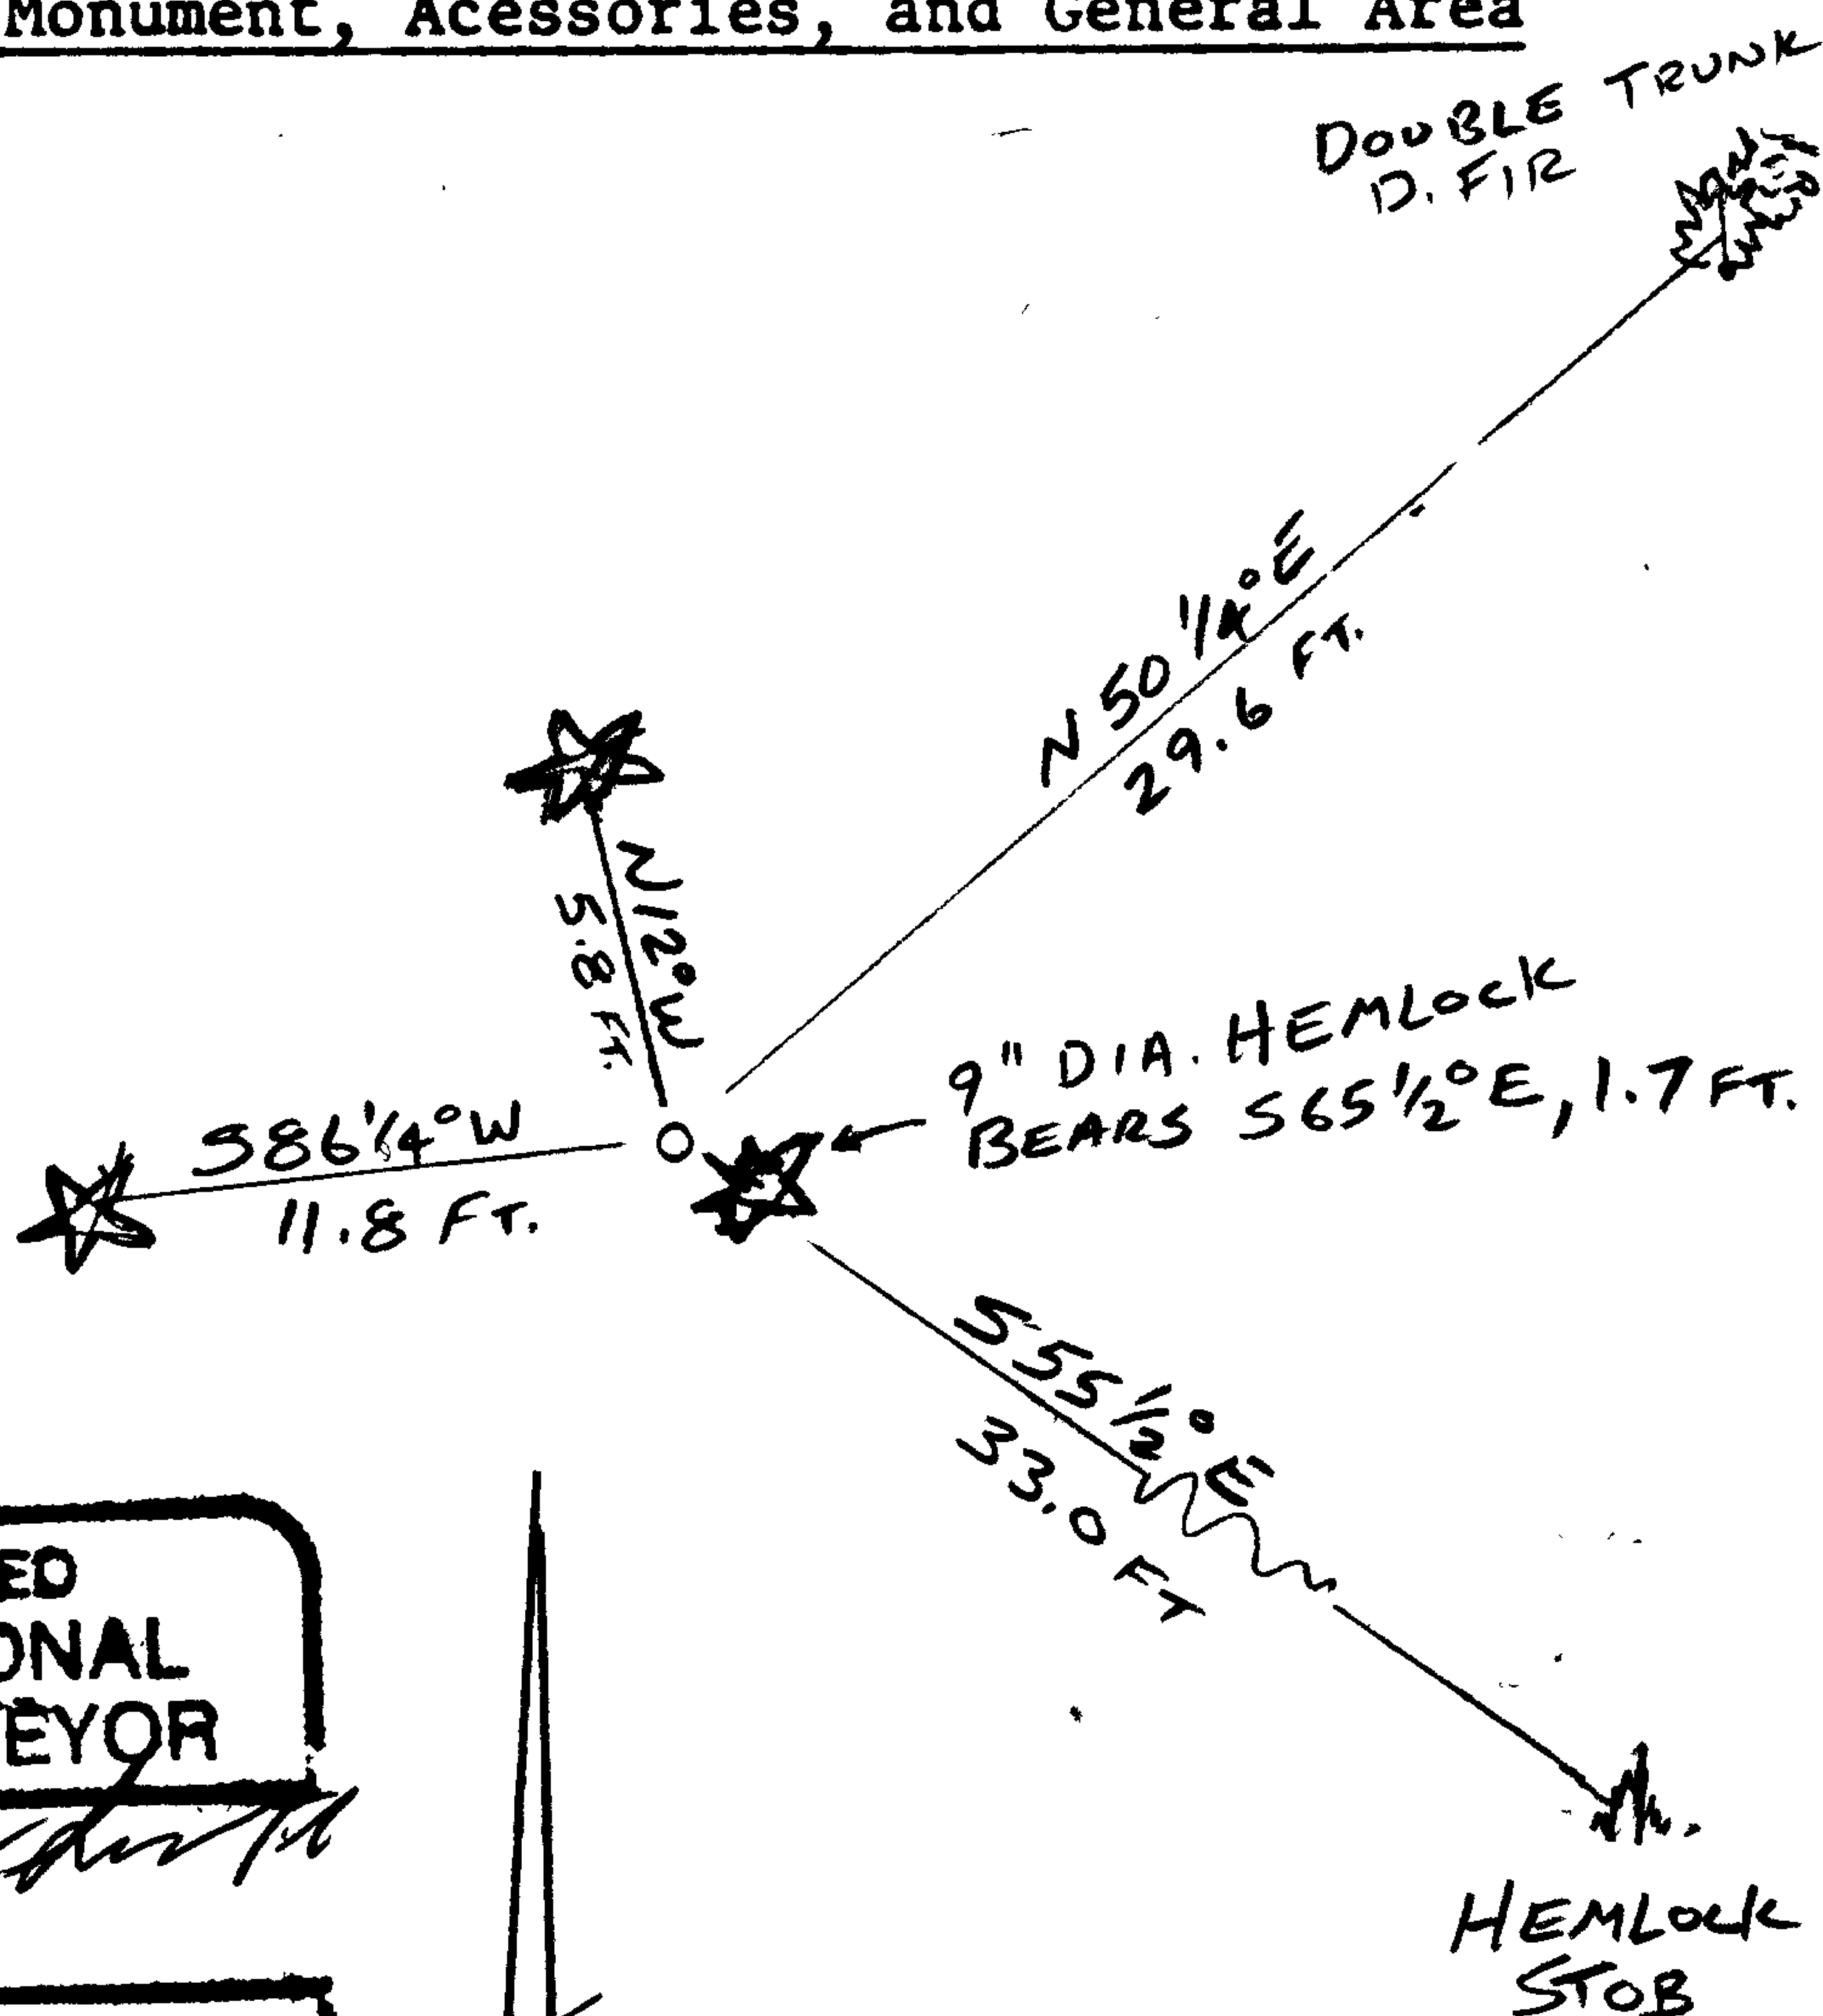

Comp. Declin. 16 1/4° E

Agency D. C. S. O.

Party Chief S. FLAUSE

Notekeeper J. PIKE

Witnesses _____

Address _____

REGISTERED
PROFESSIONAL
LAND SURVEYOR

OREGON
JULY 25, 1990
RANDALL W. SMITH
2400

RENEWAL 6-30-08

Surveyor's Seal

2400
RANDALL W. SMITH
JULY 25, 1990
OREGON