

GOVERNMENT CORNER RESTORATION FORM

FILED

Township 27 S Range 1 E Sec. 18

Date: 7/2/2008 By: JC  
County DOUGLAS This survey consists of:

State OR Date JUNE 23, 2008

No. 140400 Map: \_\_\_\_\_

Corner Designation \_\_\_\_\_

Narrative: \_\_\_\_\_

Corner Rpt: 67/25-58

WITNESS CORNER  
FOR 1/4 COR. SEC. 18/19


- DOUGLAS COUNTY SURVEYOR
- Condition Report Only
  - Not Found
  - Renewed
  - Unrecorded
  - Surveyed In
  - Referenced Out

MONUMENT DETAIL

Previous Renewals \_\_\_\_\_

Monument(s) Found: (Condition and Source)

2 1/2 IN. DIA BRASS CAP MARKED  
AS PER RECORD ON 1 IN. O.D  
IRON PIPE PROTECTS 1 FT ABOVE  
GROUND FIRMLY SET.  
NOTE: CAP IS ORIENTED TO EAST

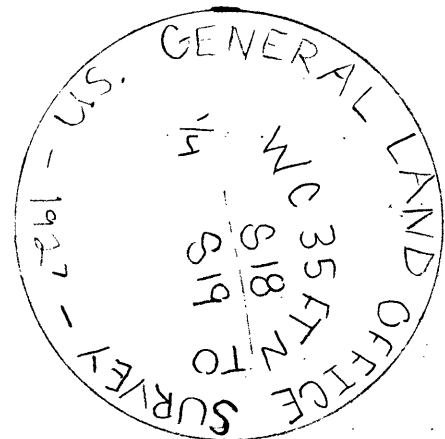

Accessories Found:

39 IN. NOW 43 IN. DIA D.FIR FULLY HEALED DOUBLE BLAZE  
BEARS S44°W 14.8 FT (REC. S44°W 13.8 FT) 1969 BT

34 IN. NOW 35 IN DIA HEMLOCK PARTIALLY HEALED DOUBLE  
BLAZE SCRIBING VISIBLE BEARS S 21° E 34.0 FT (AGREES W/ REC)  
1969 BT

1916 HEMLOCK STUMP NOT LOOKED FOR

