

FILED

GOVERNMENT CORNER RESTORATION FORM

Date: 1-15-2009 By: J

Township 29S Range 5W Sec. 7

County DOUGLAS This survey consists of:

State OR Date 1-8-2009

No. 037010 Narrative:

Corner Rpt: 67/28-2

Corner Designation

NE
DLC
37

DOUGLAS COUNTY

- Condition Report Only
- Not Found
- Renewed
- Unrecorded
- Surveyed In
- Referenced Out

MONUMENT DETAIL

Previous Renewals

Monument(s) Found: (Condition and Source)

FD 1969 2 1/2 BRASS CAP ON
A 1 1/2" O.D. IRON PIPE LEANING
SOUTHERLY PROTRUDING 2 1/2" OUT OF
GROUND IN A LOOSE MOUNT OF
STONE

BRASS CAP WHEN PLUMB IS
ORIENTATED NW'LY,

BC/IP WHEN REMOVED MEAS.
35" LONG, FD 3/4" X 30"
LONG IRON ROD UNDER BC/IP

FD 1921 1 1/2" I.D. BRASS TUBE
3" UNDER GROUND (RECORDED
AS 2" IN 1921)

Accessories Found:

MEAS. TAKEN FROM 1921 BRASS TUBE
9" DIA W. OAK NOW ROOT HOLE BEARS
SIRYOW 89.8 FT (AGREES WITH REC) 0BT

30" DIA, W. OAK NOW ROOT HOLE BEARS
580°E, 73.7 FT (AGREES WITH REC) 1921 BT

ENG. NO.
2128
NE 1 COR.
DLC # 37
NOV. 1969

NOV 1969

Monument Set (Procedure and Description)

1969 BC/IP REFERENCED AND SET
LOWER BC NOW PROTRUDES
10" OUT OF GROUND AND 5"
ABOVE A 2 FT DIA. MOUND OF
STONE. 3/4" I.R. IS ALONG
NORTH SIDE OF BC/IP

MARKS ADDED TO BRASS CAP
"RM ↑ NORTH 238 FT DCSO 2009"

1969 BC/IP BEARS SOUTH 23.8 FT
FROM 1921 BRASS PIPE

5/8" BY 30" LONG IRON ROD WITH
DCSS/ALUM CAP MARKED AS SHOWN
IS SET IN CENTER OF BRASS PIPE,
PROTRUDES 5 IN OUT OF GROUND.


TAKEN FROM 1921 BRASS PIPE

New Accessories

27" DIA. W. OAK DOUBLE BLAZED AND SCRIBED
NE DLC 37 CS BT ON A DOUBLE BLAZE
BEARS S 31° W, 112.7 FT.

36" DIA. W. OAK DOUBLE BLAZED AND SCRIBED
NE DLC 37 CS BT ON A DOUBLE BLAZE N 38 1/2° W
BEARS 115.8 FT.

Sketch of Monument, Accessories, and General Area

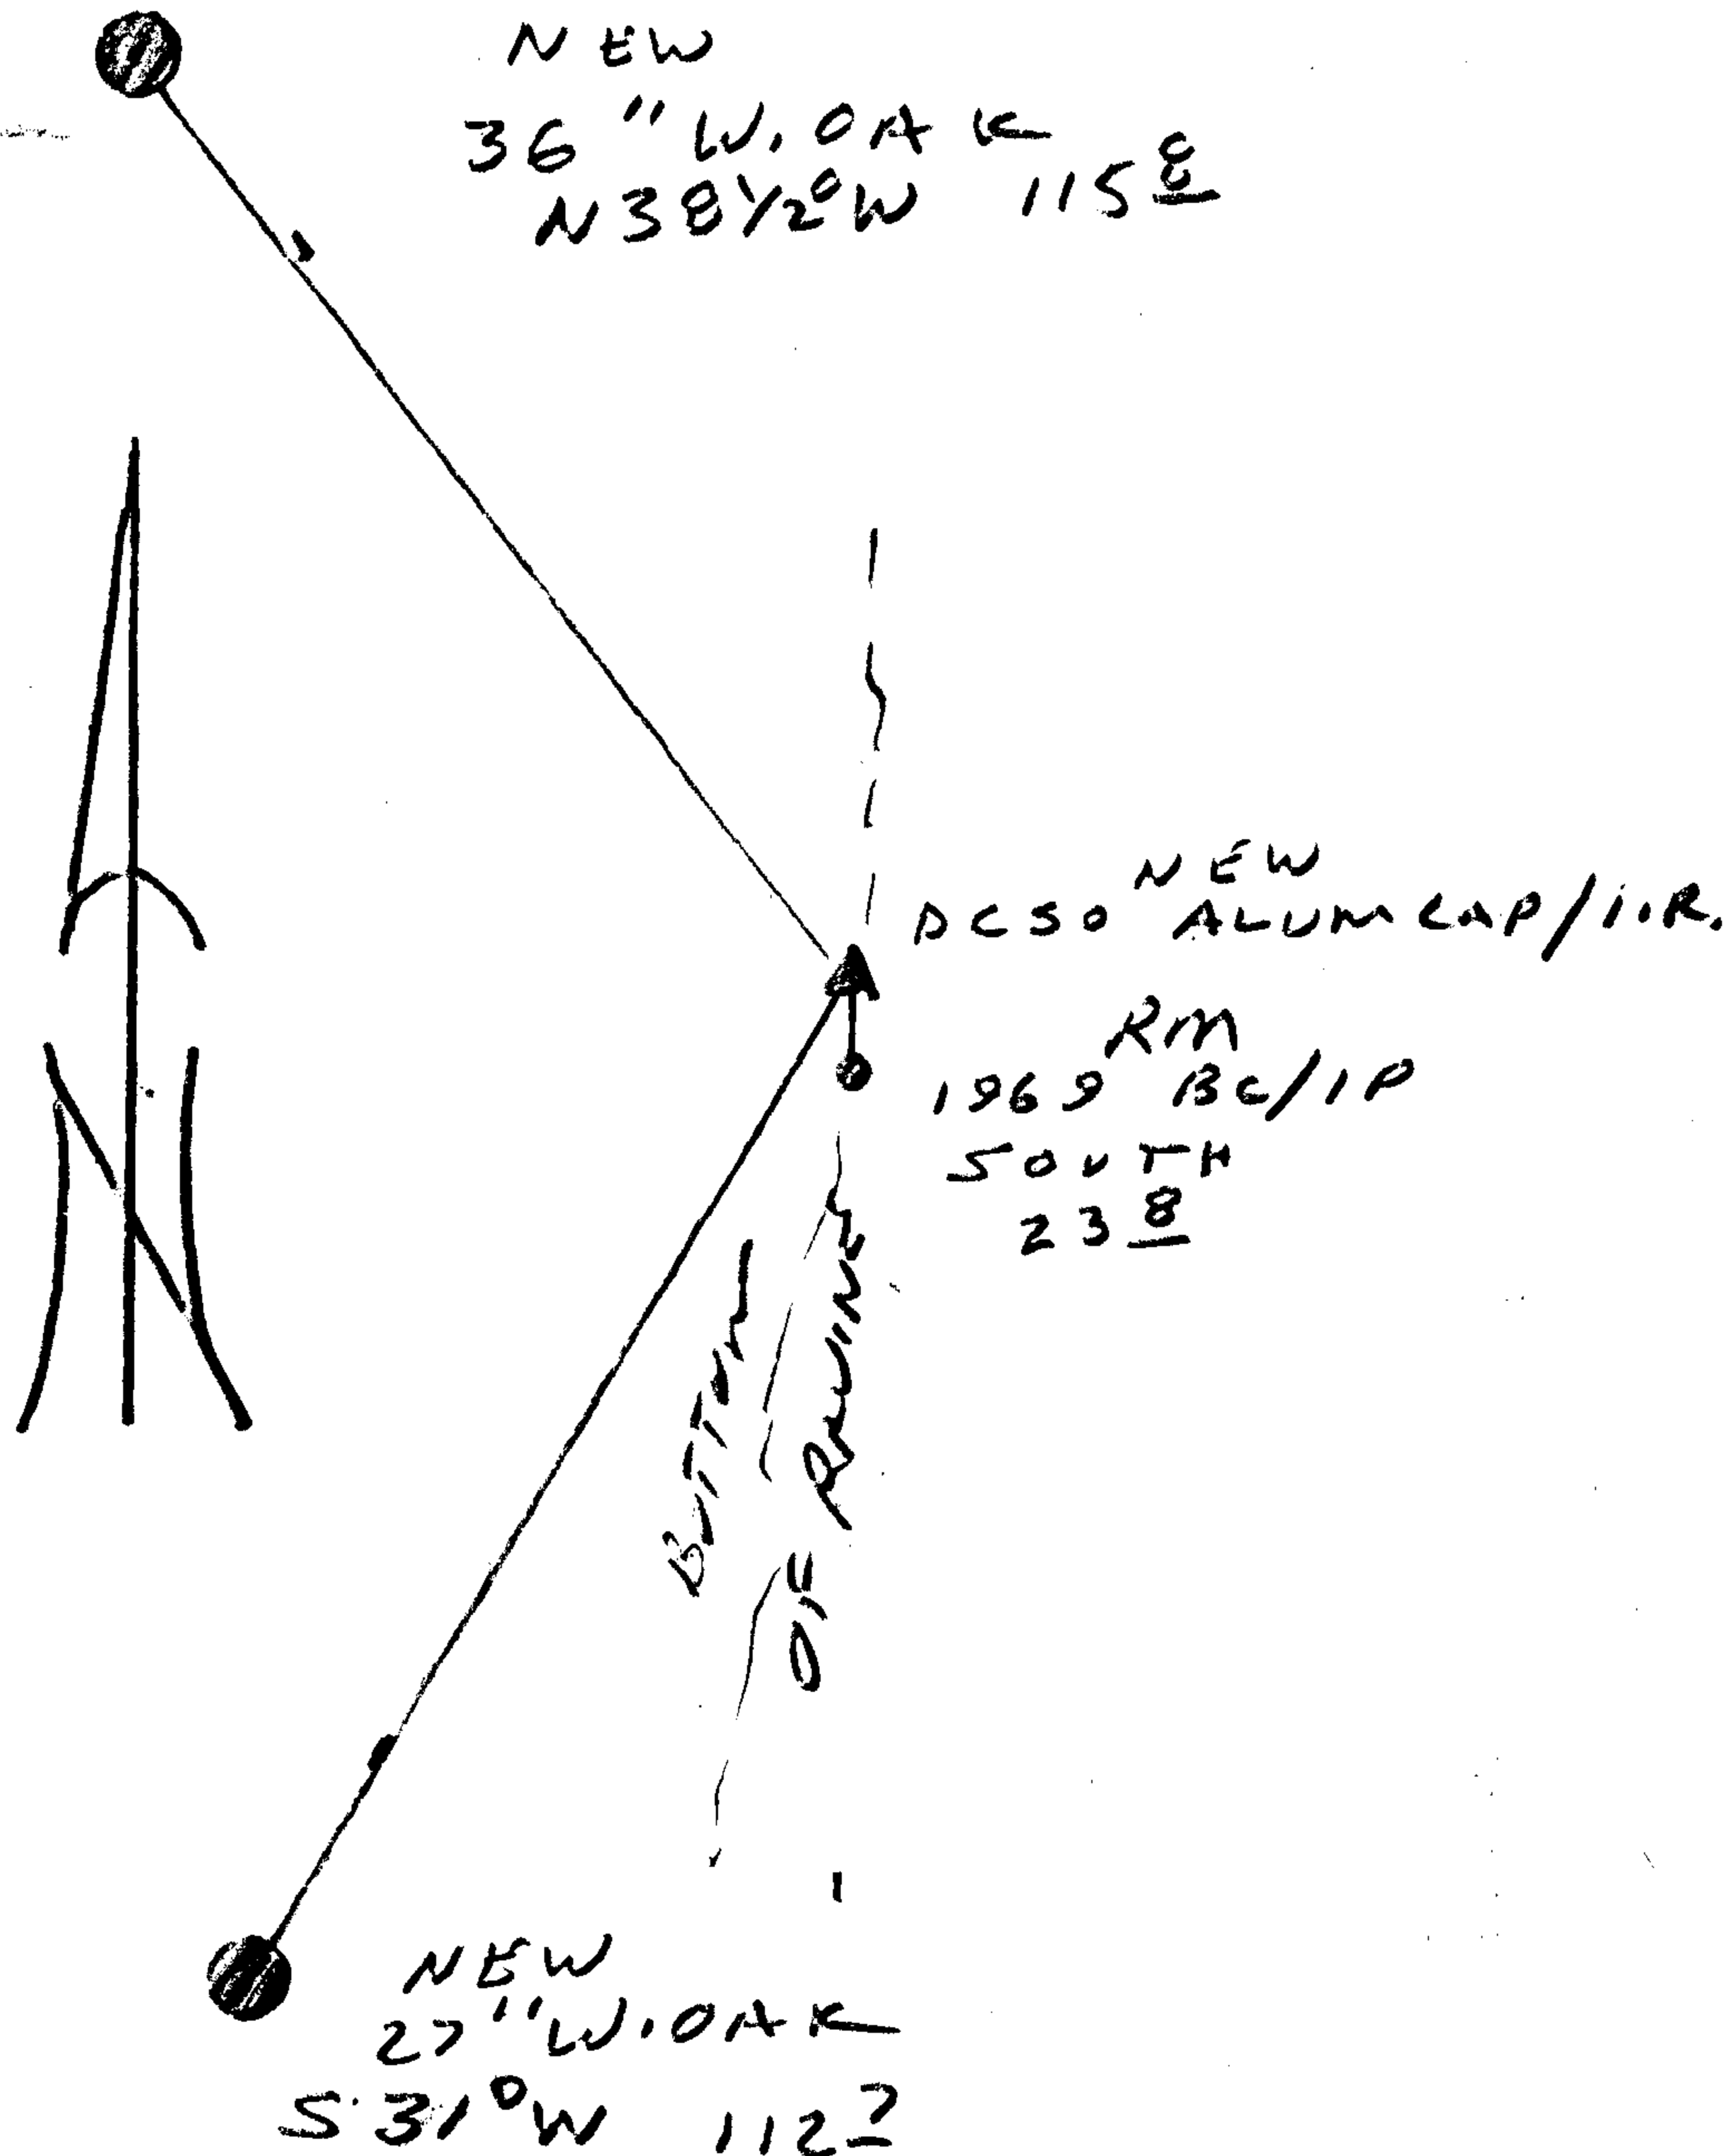

ENG. NO.
2128
RM
N.E. COR
NORTH
238 FT
DLC #37
DCSO
2009
NOV 1969

DOUGLAS CO,
NE
37
2
SURVEYOR

Location & Comments

CORNER I.E.C AT BOTTOM
OF SMALL RAVINE

Comp. Declin. 16 1/2° W
Agency DCSO
Party Chief RANDY SMITH
Notekeeper RAND. SMITH
Witnesses STEVE FLAIR

Address

REGISTERED
PROFESSIONAL'S Seal
LAND SURVEYOR

Randy Smith

OREGON
JULY 25, 1999
RANDALL W. SMITH
2489

6-30-2010