



RENEWAL

Monument Set (Procedure and Description)

Monument Detail


5/8" X 30" LONG IRON ROD  
 WITH DCSD ALUM CAP IS  
 SET PLUMB IN CENTER OF  
 FD IRON PIPE, PROTRUDING 5"  
 OUT OF GROUND

DOUGLAS CO.  
 NW  
 38  
 2009  
 SURVEYOR

New Accessories

41" W. OAK DOUBLE BLAZED AND SCRIBED "NW DLE 38 CS BT"  
 BEARS S 82° W, 278.3 FT,  
 34" W. OAK DOUBLE BLAZED AND SCRIBED "NW DLE 58 CS BT"  
 BEARS N 6 1/2° E 245.3 FT

Sketch of Monument, Accessories, and General Area

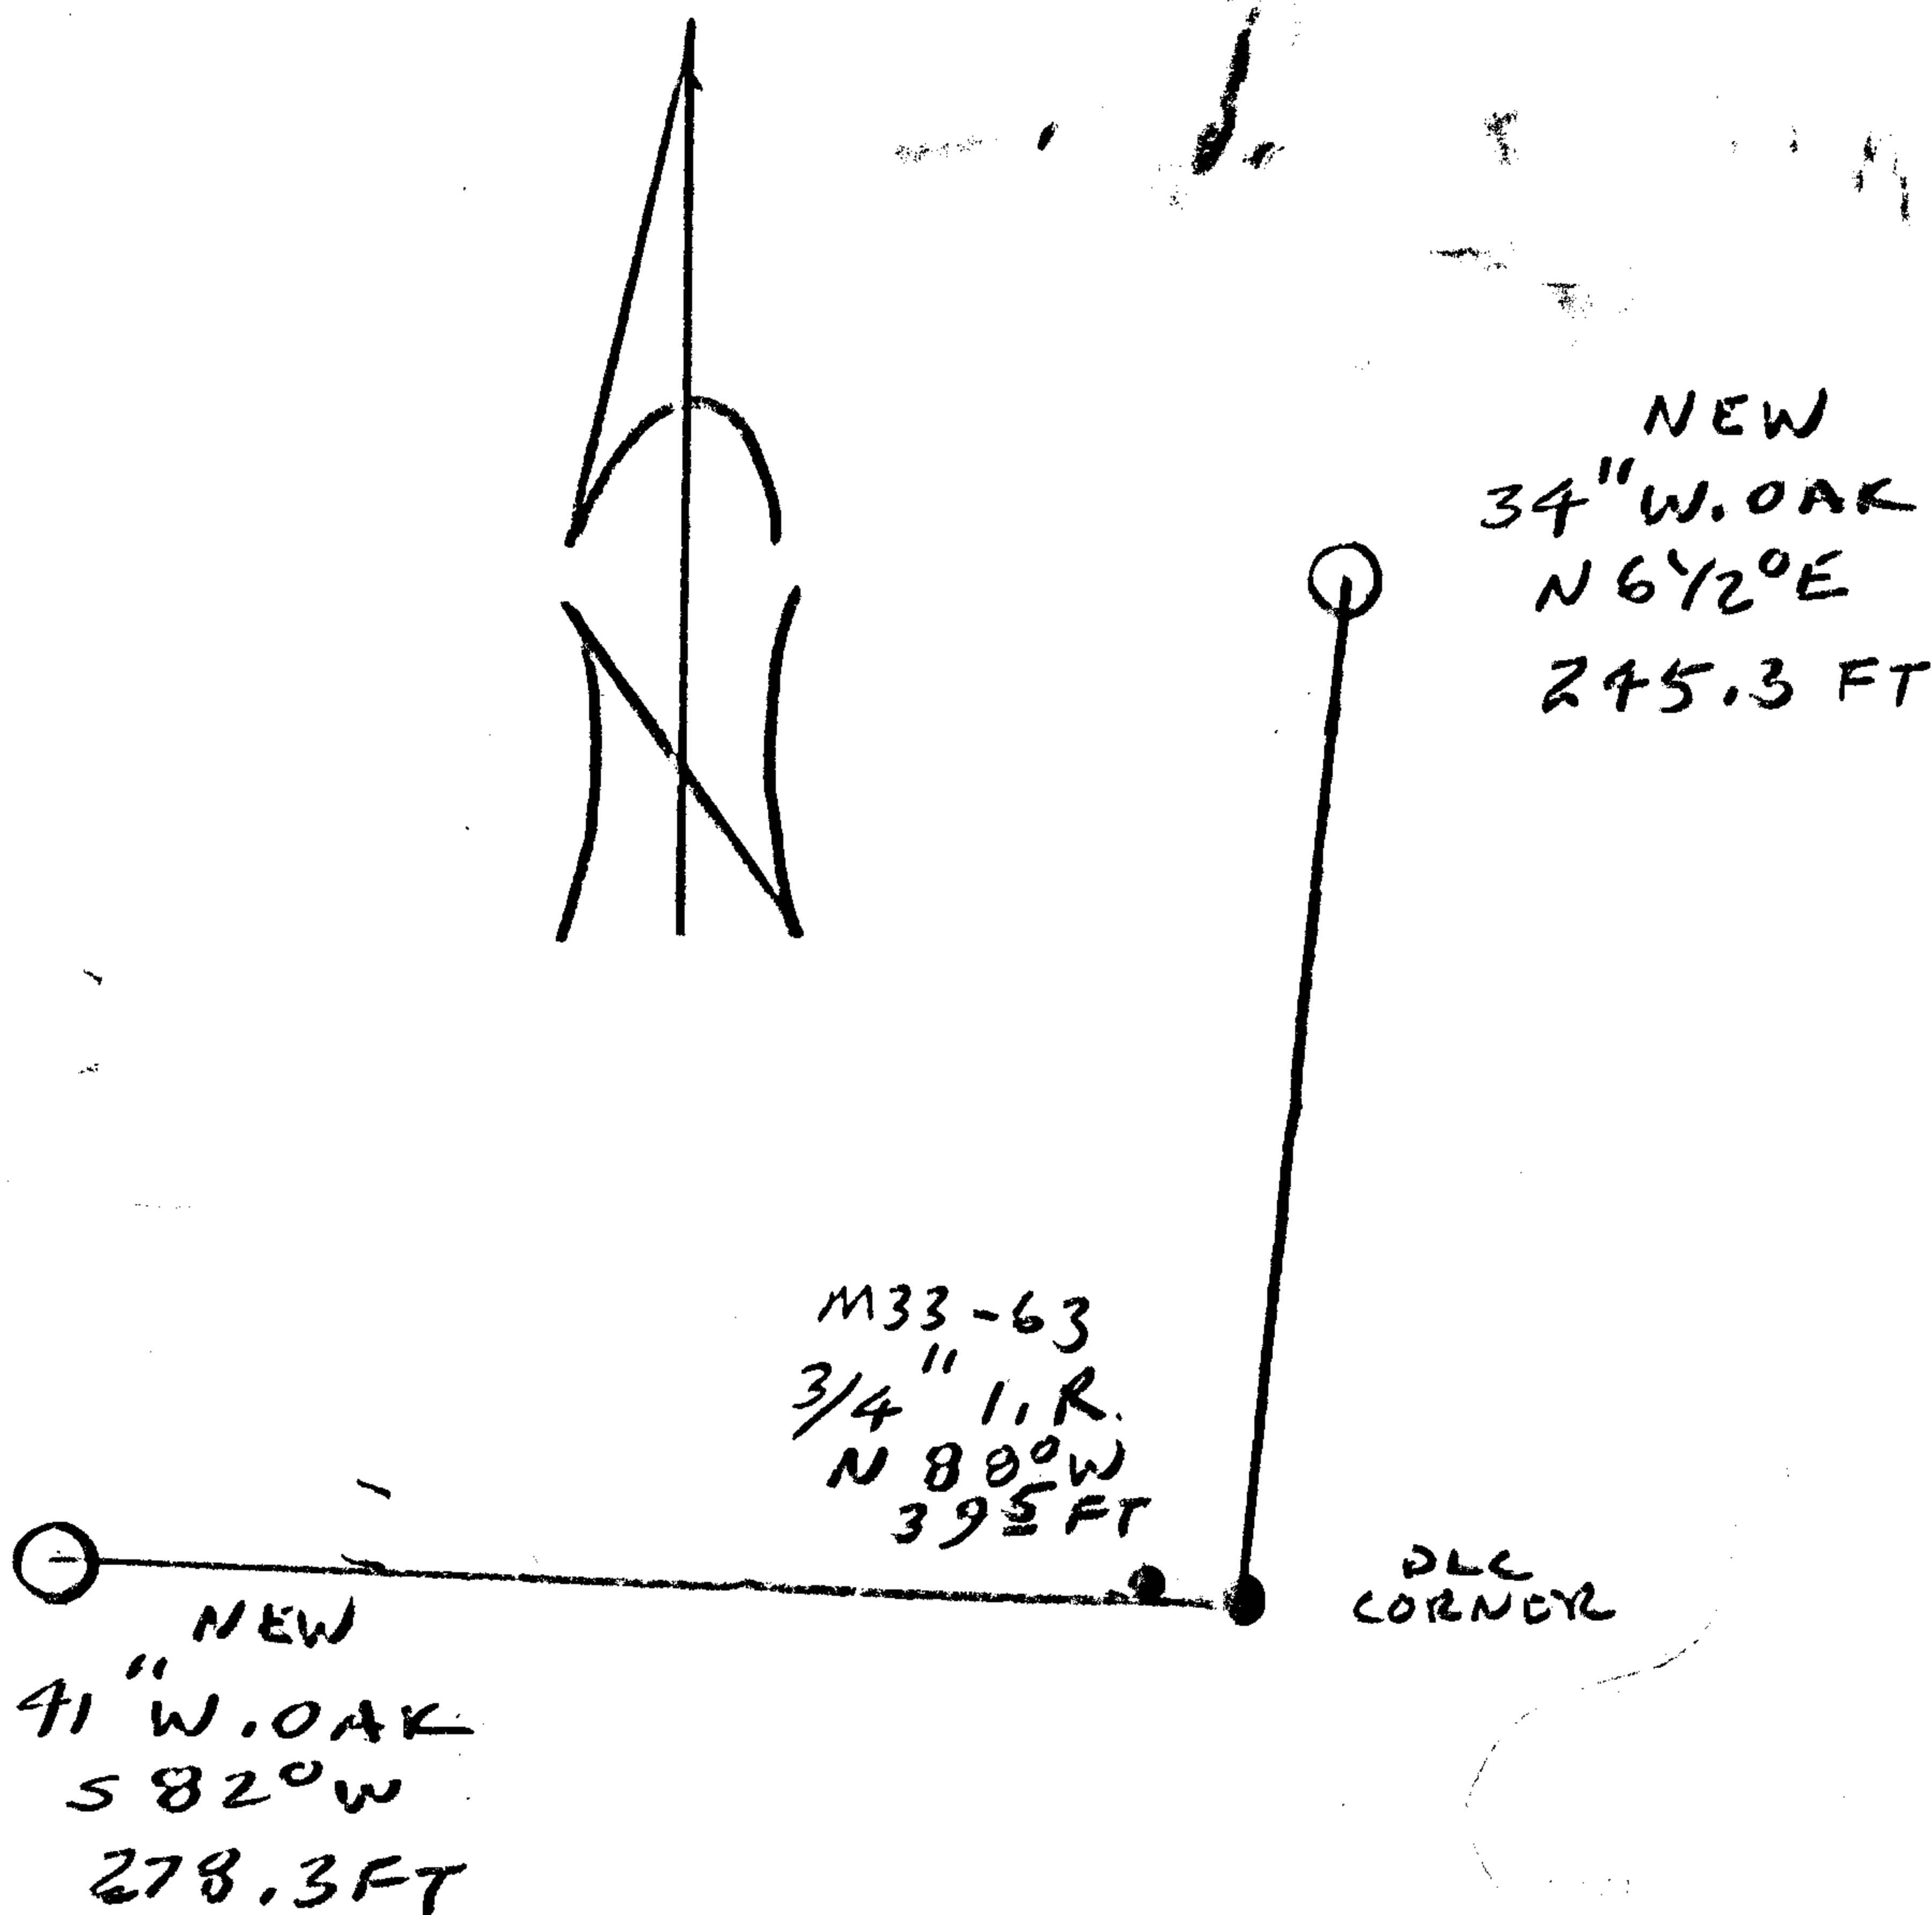

Location & Comments

Comp. Declin. N 1/2° W  
 Agency DCSD  
 Party Chief RANDY SMITH  
 Notekeeper RANDY SMITH  
 Witnesses

Address

Surveyor's Seal

REGISTERED  
 PROFESSIONAL  
 LAND SURVEYOR

*Randall W. Smith*  
 6-30-2010

OREGON  
 JULY 25, 1990  
 RANDALL W. SMITH  
 2100