

GOVERNMENT CORNER RESTORATION FORM

Date: 1-15-09 By: JC

This survey consists of:

Township 30 S Range 4 W Sec. 30

County DOUGLAS Map:

State OR

Date 1-15-09

No. 100240

Narrative:

Corner Rpt: 67/28-4

Corner Designation

1/4 S 25 | S 30

DOUGLAS COUNTY

SURVEYOR

Condition Report Only

Not Found

Renewed

Unrecorded

Surveyed In

Referenced Out

Previous Renewals 1889, 1950 CS 40/281, 1950 CS 40/296

MONUMENT DETAIL

Monument(s) Found: (Condition and Source)

1963 DC 50

~~FD 9" x 9" x 9" STONE FLUSH WITH GROUND~~

FD 29" LONG 1 1/4" DIA AXLE WITH 6" FLANGE. OUT OF GROUND NO POSITION

FD 3/4" DIA x 29" LONG IRON ROD FD OUT OF GROUND NO POSITION. SOURCE UNKNOWN

N/A

Accessories Found:

5" NOW 16" DIA. W. OAK WITH A FULLY HEALED DOUBLE BLAZE BEARS S 4 1/2° W, 162.0 FT (REC S 45° W, 162.0 FT) 1963

16" NOW 19" DIA. DEAD B. OAK WITH FULLY HEALED BLAZE W/ OPEN AND FINE GOOD SCRAPING "BT" BEARS S 27° E, 258.0 FT (REC. S 23° E, 258.0 FT) 1963

29" NOW DOWN AND ROTTING W/ OAK ALONG WESTERLY EDGE OF DIRT ROAD. NO POSITION DETERMINABLE. REC S 1/2° W 264 FT IS REASONABLE. CRT.

RENEWAL

Monument Set (Procedure and Description)

Monument Detail

CORNER POSITION DETERMINED AT THE INTERSECTION OF RECORD DISTANCES AS DESCRIBED ON THE FRONT.

2 1/2 DIA BRASS MARKED AS SHOWN ON A 1 1/2" DIA. BY 32" LONG IRON PIPE IS SET AT ALL CORNER POSITION WITH AXIUM SET ALONG NORTH EDGE OF BC/IP FLANGE DOWN. BC/IP PROVIDES 6" OUT OF GROUND

DOUGLAS COUNTY SURVEYORS
 T 30 S
 R 1/4 R
 5 S25 S30 4
 W W
 2009
 OFFICE


New Accessories

18" DIA. DIFIR DOUBLE BLAZED AND SCRIBED "S30 1/4 CS BT"
 BEARS S 22 1/2° E, 249.8 FT

CHISELED 3 1/2" + IN WEST FACE OF 8' X 3' EXPOSED
 ROCK OUT CROP BEARS N 69 1/2° E, 24.4 FT

3/4 X 29" LONG IRON ROD PROTRUDES 4" OUT OF GROUND SET
 IN N-S FENCE LINE BEARS N 13° E 10 FT

Sketch of Monument, Accessories, and General Area

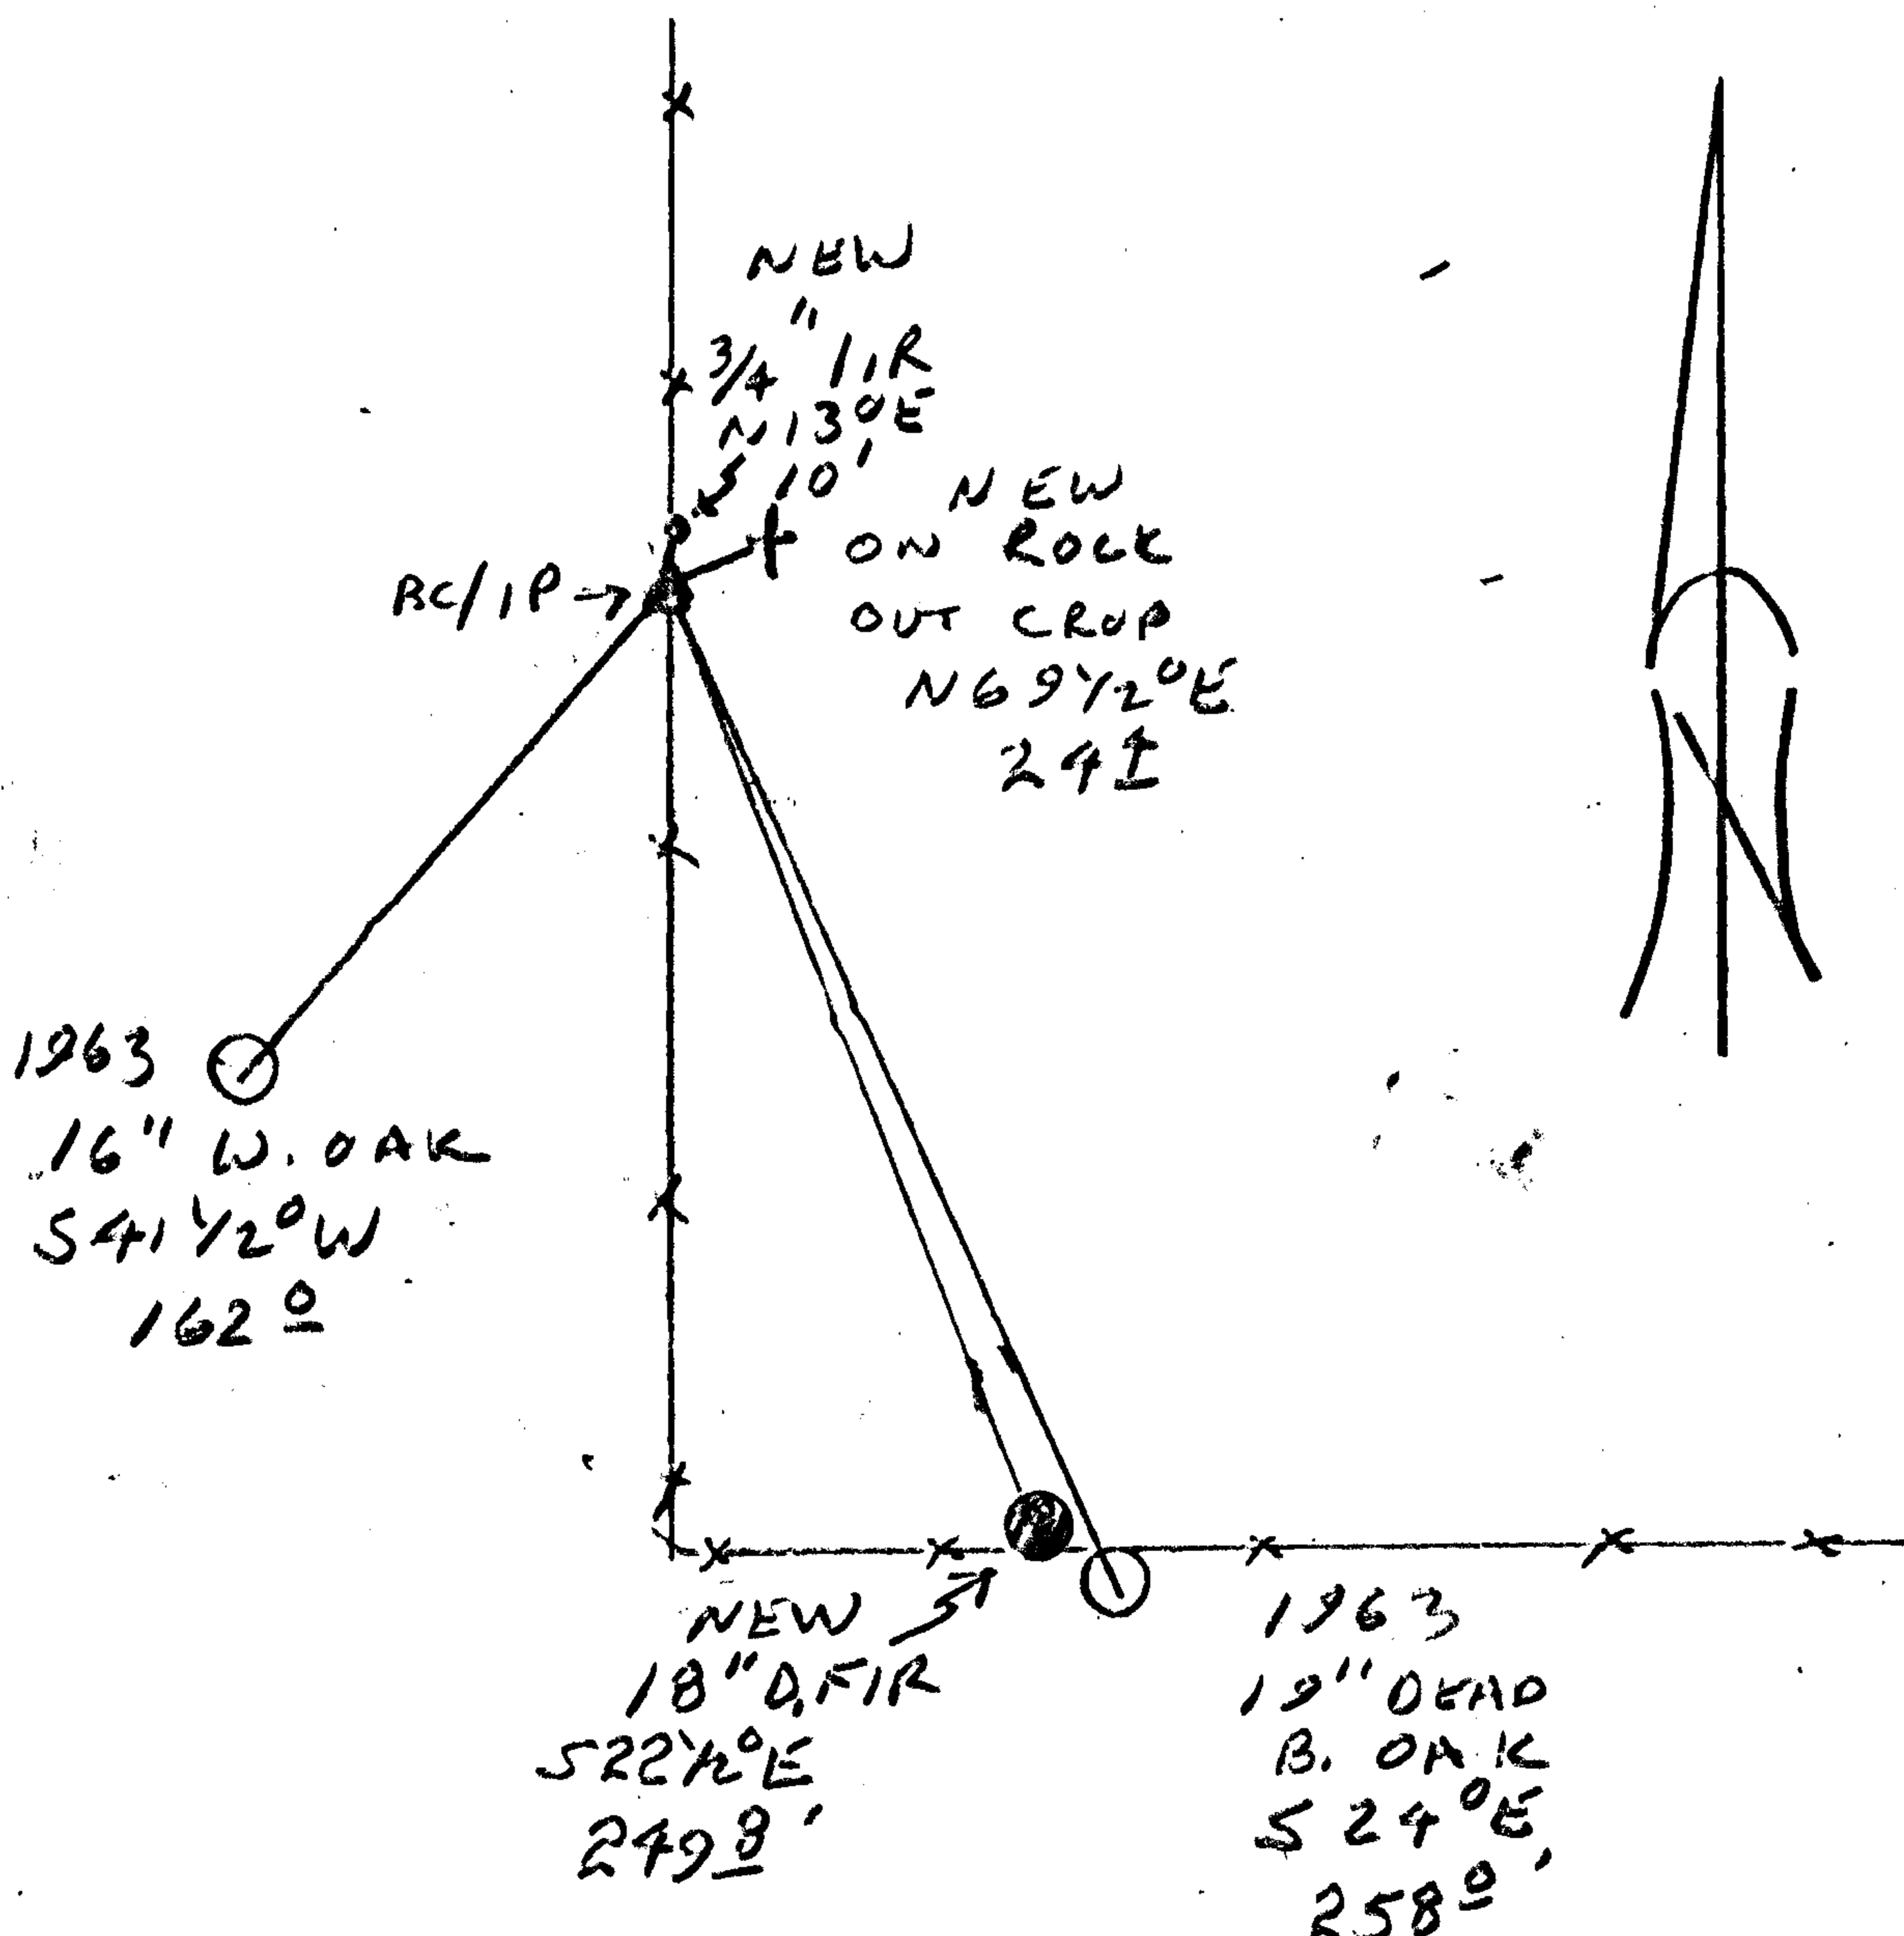

Location & Comments

CORNER LIES 3 FT WEST OF A NEW N-S FENCE LINE

FD REMAINTS OF OLD DOWN ROTTEN FENCE POSTS RUNNING NORTH OF CORNER THAT AVERAGE 4 FT WEST OF NEW FENCE LINE

Comp. Declin. 16 1/2° E
 Agency DCSG
 Party Chief RANDY SMITH
 Notekeeper RANDY SMITH
 Witnesses STEVE FLAHERTY

Address

REGISTERED PROFESSIONAL LAND SURVEYOR Seal

Randall W. Smith

OREGON
 JULY 25, 1990
 RANDALL W. SMITH
 2489

RENEWAL 6-30-2010