

FILED

GOVERNMENT CORNER RESTORATION FORM

Date: 1-21-2009 By: JC

Township 22S Range 10W Sec. 17 County DOUGLAS

This survey consists of:
Map: _____

State OR Date JAN. 14, 2009 No. 240500

Narrative: _____

Corner Rpt: 67/28-9

Corner Designation

N 1/4 COR SEC. 17

DOUGLAS COUNTY

Condition Report Only

Not Found

Renewed

Unrecorded

Surveyed In


Referenced Out

MONUMENT DETAIL

Previous Renewals 1974

Monument(s) Found: (Condition and Source)

3" DIA BRASS CAP (MARKED AS SHOWN) 9" BELOW SURFACE OF GROUND. CAP LEANS SLIGHTLY WESTWARD 1974

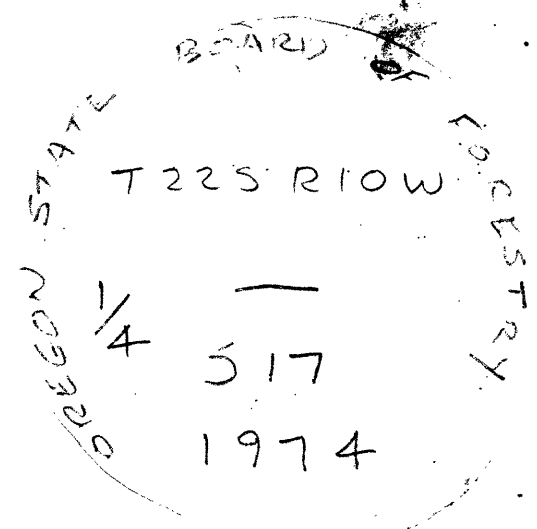

Accessories Found:

BOTH WILLOW TREES GONE (1974 REN.)

5/8" IRON ROD WITH 1 1/2" DIA. ALUM. CAP MKD. "BUNTING A.P. A 8 WA OR 7858"

BEARS S 89° 47' 14" E, 367.38 FT. SEE M64-62 (1977 MONUMENT)

C.S. File No 67/28-9

