

FILED FEB 9 2009

PI # 500 500

2-4-2009

T235 R4W

S10	S11
S15	S14


FD OK

BLEM BL/IP FD LEARNING
 WE RETURN IT TO PLUMB
 POSITION NOW PROTRUDES
 2" OUT OF GROUND.
 WE ADD TAG'S TO BT'S

RANDY SMITH

STEVE FLAUSÉ

REGISTERED
 PROFESSIONAL
 LAND SURVEYOR

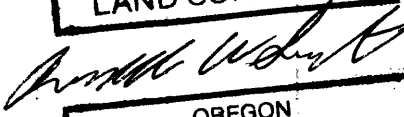

OREGON
 JULY 25, 1990
 RANDALL W. SMITH
 2488

RENEWAL 6-30-2010

C.S. File No 67/28-13