

GOVERNMENT CORNER RESTORATION FORM

Date: 2/25/2009 By: J

Township 29S Range 8W Sec. 8

County DOUGLAS This survey consists of:

State OR Date 2-17-2009

No. 300500 Nonative: _____

Corner Designation

Corner Rpt: 67/28-16

58 | 59

517 | 516

DOUGLAS COUNTY

- Condition Report Only
- Not Found
- Renewed
- Unrecorded
- Surveyed In
- Referenced Out

Previous Renewals

Monument(s) Found: (Condition and Source)

2 1/2" BRASS CAP ON A 1 1/2" DIA
BY 36" LONG IRON PIPE, FOUND
OUT OF GROUND. (1958)

COUNTY SURVEYORS OFFICE
T 29S R 8W
58 | 59

517 | 516
1958

Accessories Found:

8" NOW 25" DIA. D. FIR WITH A FULLY HEALED DOUBLE
BLAZE, BEARS S67°W, 47.2 FT (REL S68Y4°W, 47.2 FT)
(1958)

12" NOW 24" DIA. T. CEDAR WITH A FULLY HEALED DOUBLE
BLAZE, BEARS N10Y2°W, 60.1 FT (REL N11Y2°W, 60.1 FT)
(1958)

20" NOW 27" DIA T. CEDAR WITH A FULLY HEALED DOUBLE
BLAZE, BEARS N49°E, 47.5 FT (AGREES WITH REL.)
(1955)

13" NOW 17" DIA D. FIR WITH A FULLY HEALED SINGLE
BLAZE, BEARS S56Y4°E, 35.0 FT (AGREES WITH REL.)
(1995)

RENEWAL

Monument Set (Procedure and Description)

SET FOUND 1958 BY IP AT POSITION AS DETERMINED FROM BEARING TREES NOW PROTRUDING 7" OUT OF GROUND. WE ADD STAMPING TO BRASS CAP "RESET 2009".


Monument Detail

N/A

New Accessories

N/A

Sketch of Monument, Accessories, and General Area

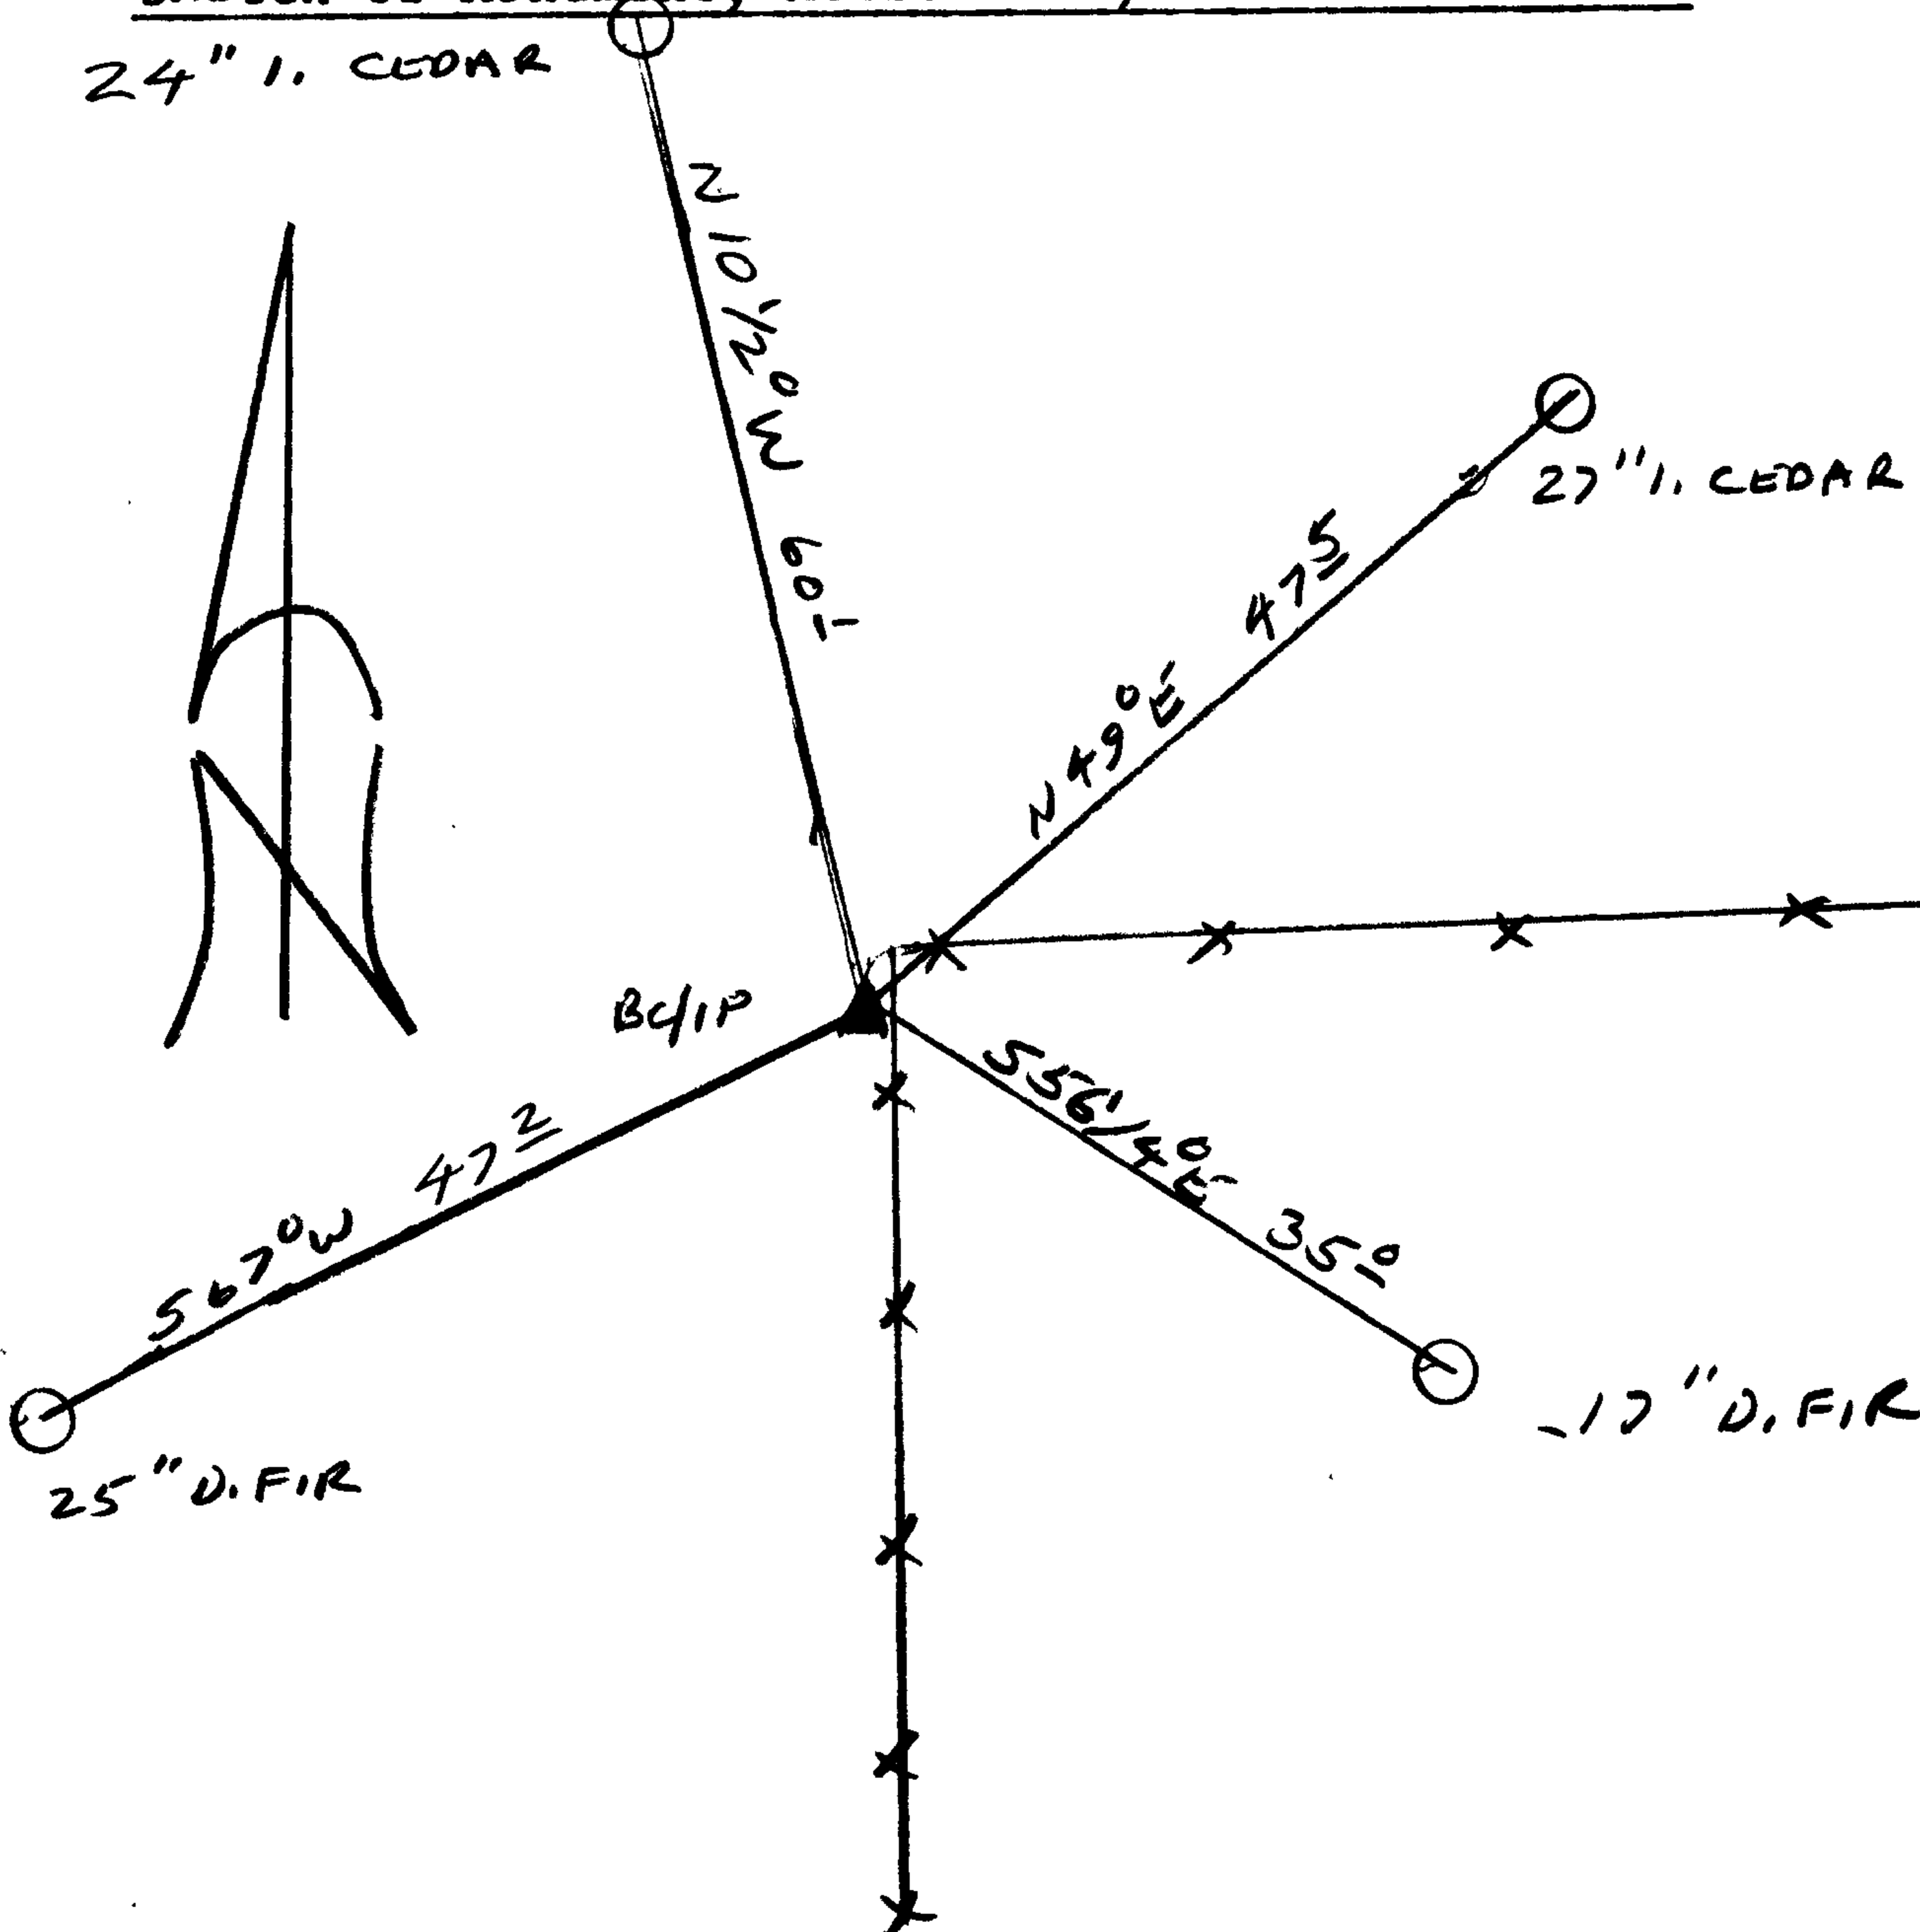

Location & Comments

CORNER LIES 3 FT SOUTH AND 1 FT WEST OF A FENCE CORNER WITH FENCE LINES RUNNING EAST AND SOUTH

Comp. Declin. 16 1/2° E
Agency DCSO
Party Chief RANDY SMITH
Notekeeper RANDY SMITH
Witnesses STEVE FLAUS

Address

REGISTERED Surveyor's Seal
PROFESSIONAL
LAND SURVEYOR

Randall W. Smith

OREGON
JULY 25, 1990
RANDALL W. SMITH
2489

RENEWAL 6-30-2010