

RENEWAL

Monument Set (Procedure and Description)

2 1/2" BRASS CAP ON A 1 1/2" X 32" LONG IRON PIPE IS SET AT A POSITION DETERMINED FROM OBT'S. PROTRUDES 8" OUT OF GROUND

Monument Detail


DOUGLAS COUNTY SURVEYOR
T 32 S
S 11 R
1/4 514 W
2009

New Accessories

15" D. FIR DOUBLE BLAZED AND SCRIBED "1/4 S 14 CS BT" BEARS S 88° E, 51.5 FT.

11" MAPLE DOUBLE BLAZED AND SCRIBED "1/4 S 11 CS BT" ROOT CROWN BEARS N 15° E 24.0 FT

Sketch of Monument, Accessories, and General Area

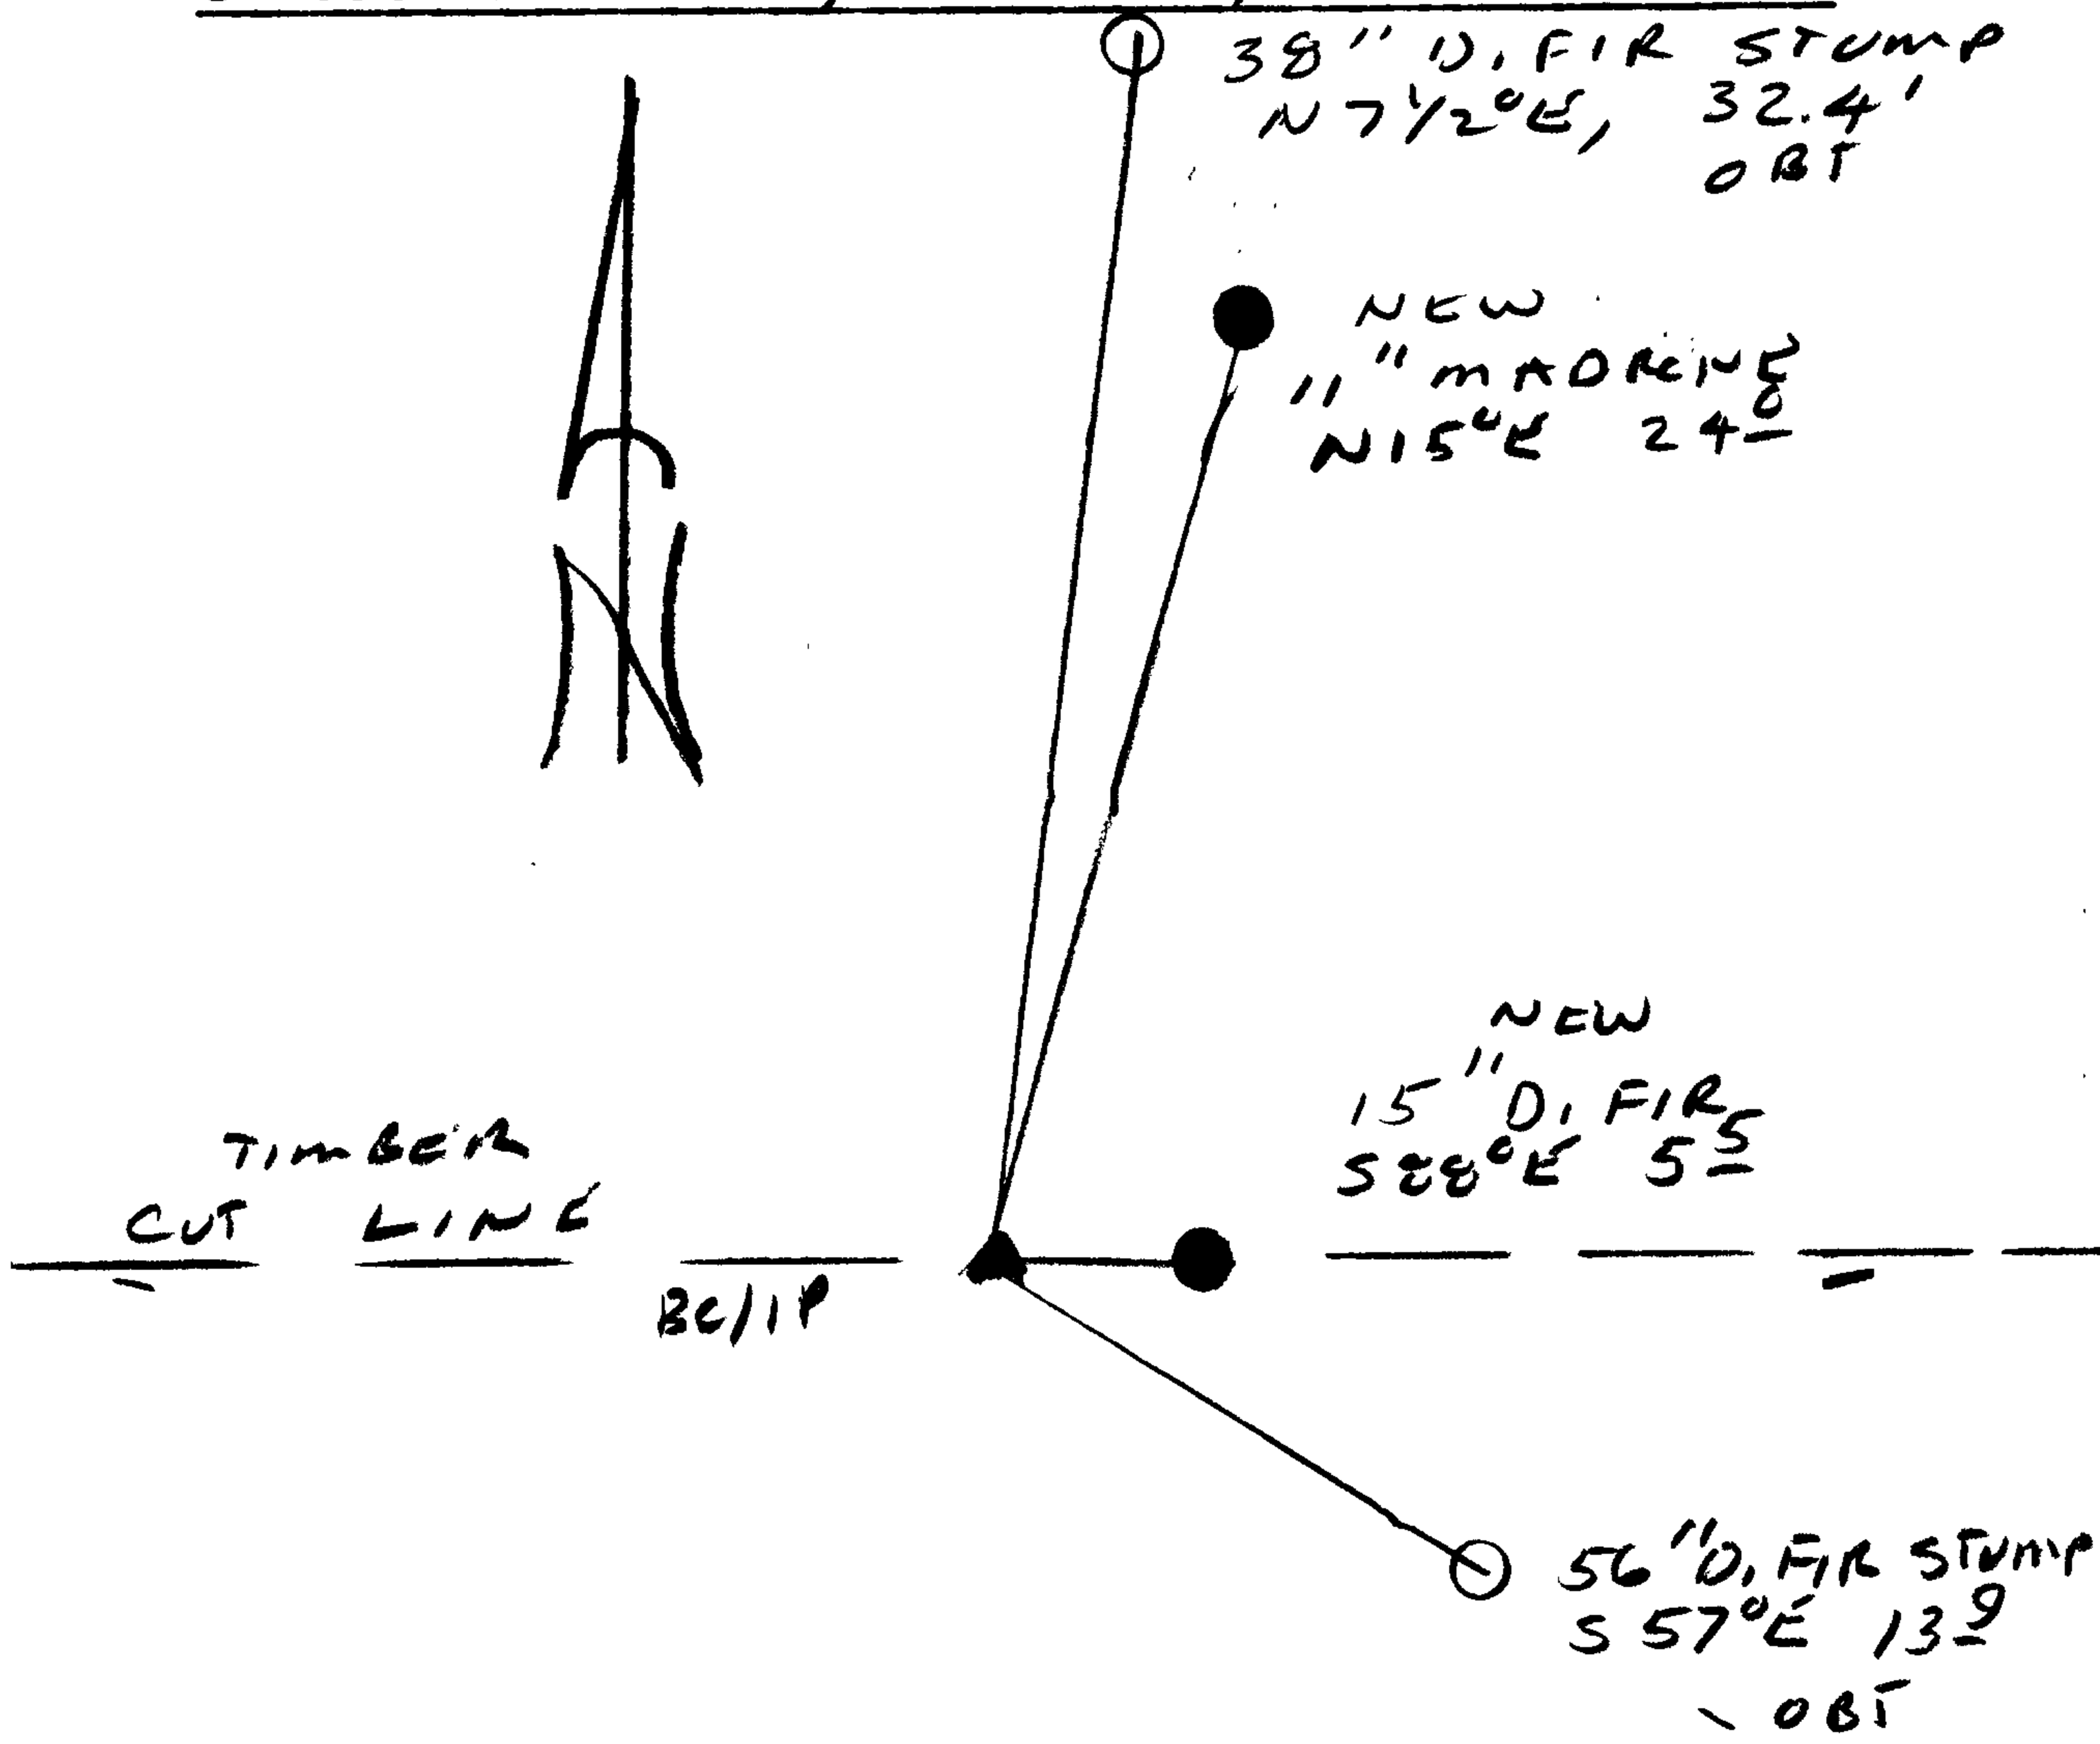

Location & Comments

CORNER LINE ON STEEP WEST SLOPE ON AN E-W CUT LINE NUMBER CLEAR CUT SOUTH OF LINE

Comp. Declin. 16 1/2° E
Agency DCSO
Party Chief RANDY SMITH
Notekeeper RANDY SMITH
Witnesses STEVE FLAISE

Address

REGISTERED Surveyor's Seal
PROFESSIONAL
LAND SURVEYOR

Randall W. Smith

OREGON
JULY 25, 1960
RANDALL W. SMITH
2409

RENEWAL 6-30-2010

CLEAR CUT
CS 67/28-18