

RENEWAL

Monument Set (Procedure and Description)

5/8" By 30" LONG I.R. WITH
 1/2" DIA ALUM CAP, PLUMB
 OVER TOP OF FD. BLM BELIP.
 PROTRUDES 6" OUT OF GROUND

Monument Detail

DOUGLAS CO. SURVEYOR


7	8
18	17

New Accessories

6" DIA D. FIR DOUBLE BLAZED AND SCRIBED "X CS BT"
 BEARS N57 1/2° W, 6.2 FT

8" DIA. D. FIR DOUBLE BLAZED AND SCRIBED "T225 R9WS18 CS BT"
 BEARS S55 1/2° W 9.9 FT

Sketch of Monument, Accessories, and General Area

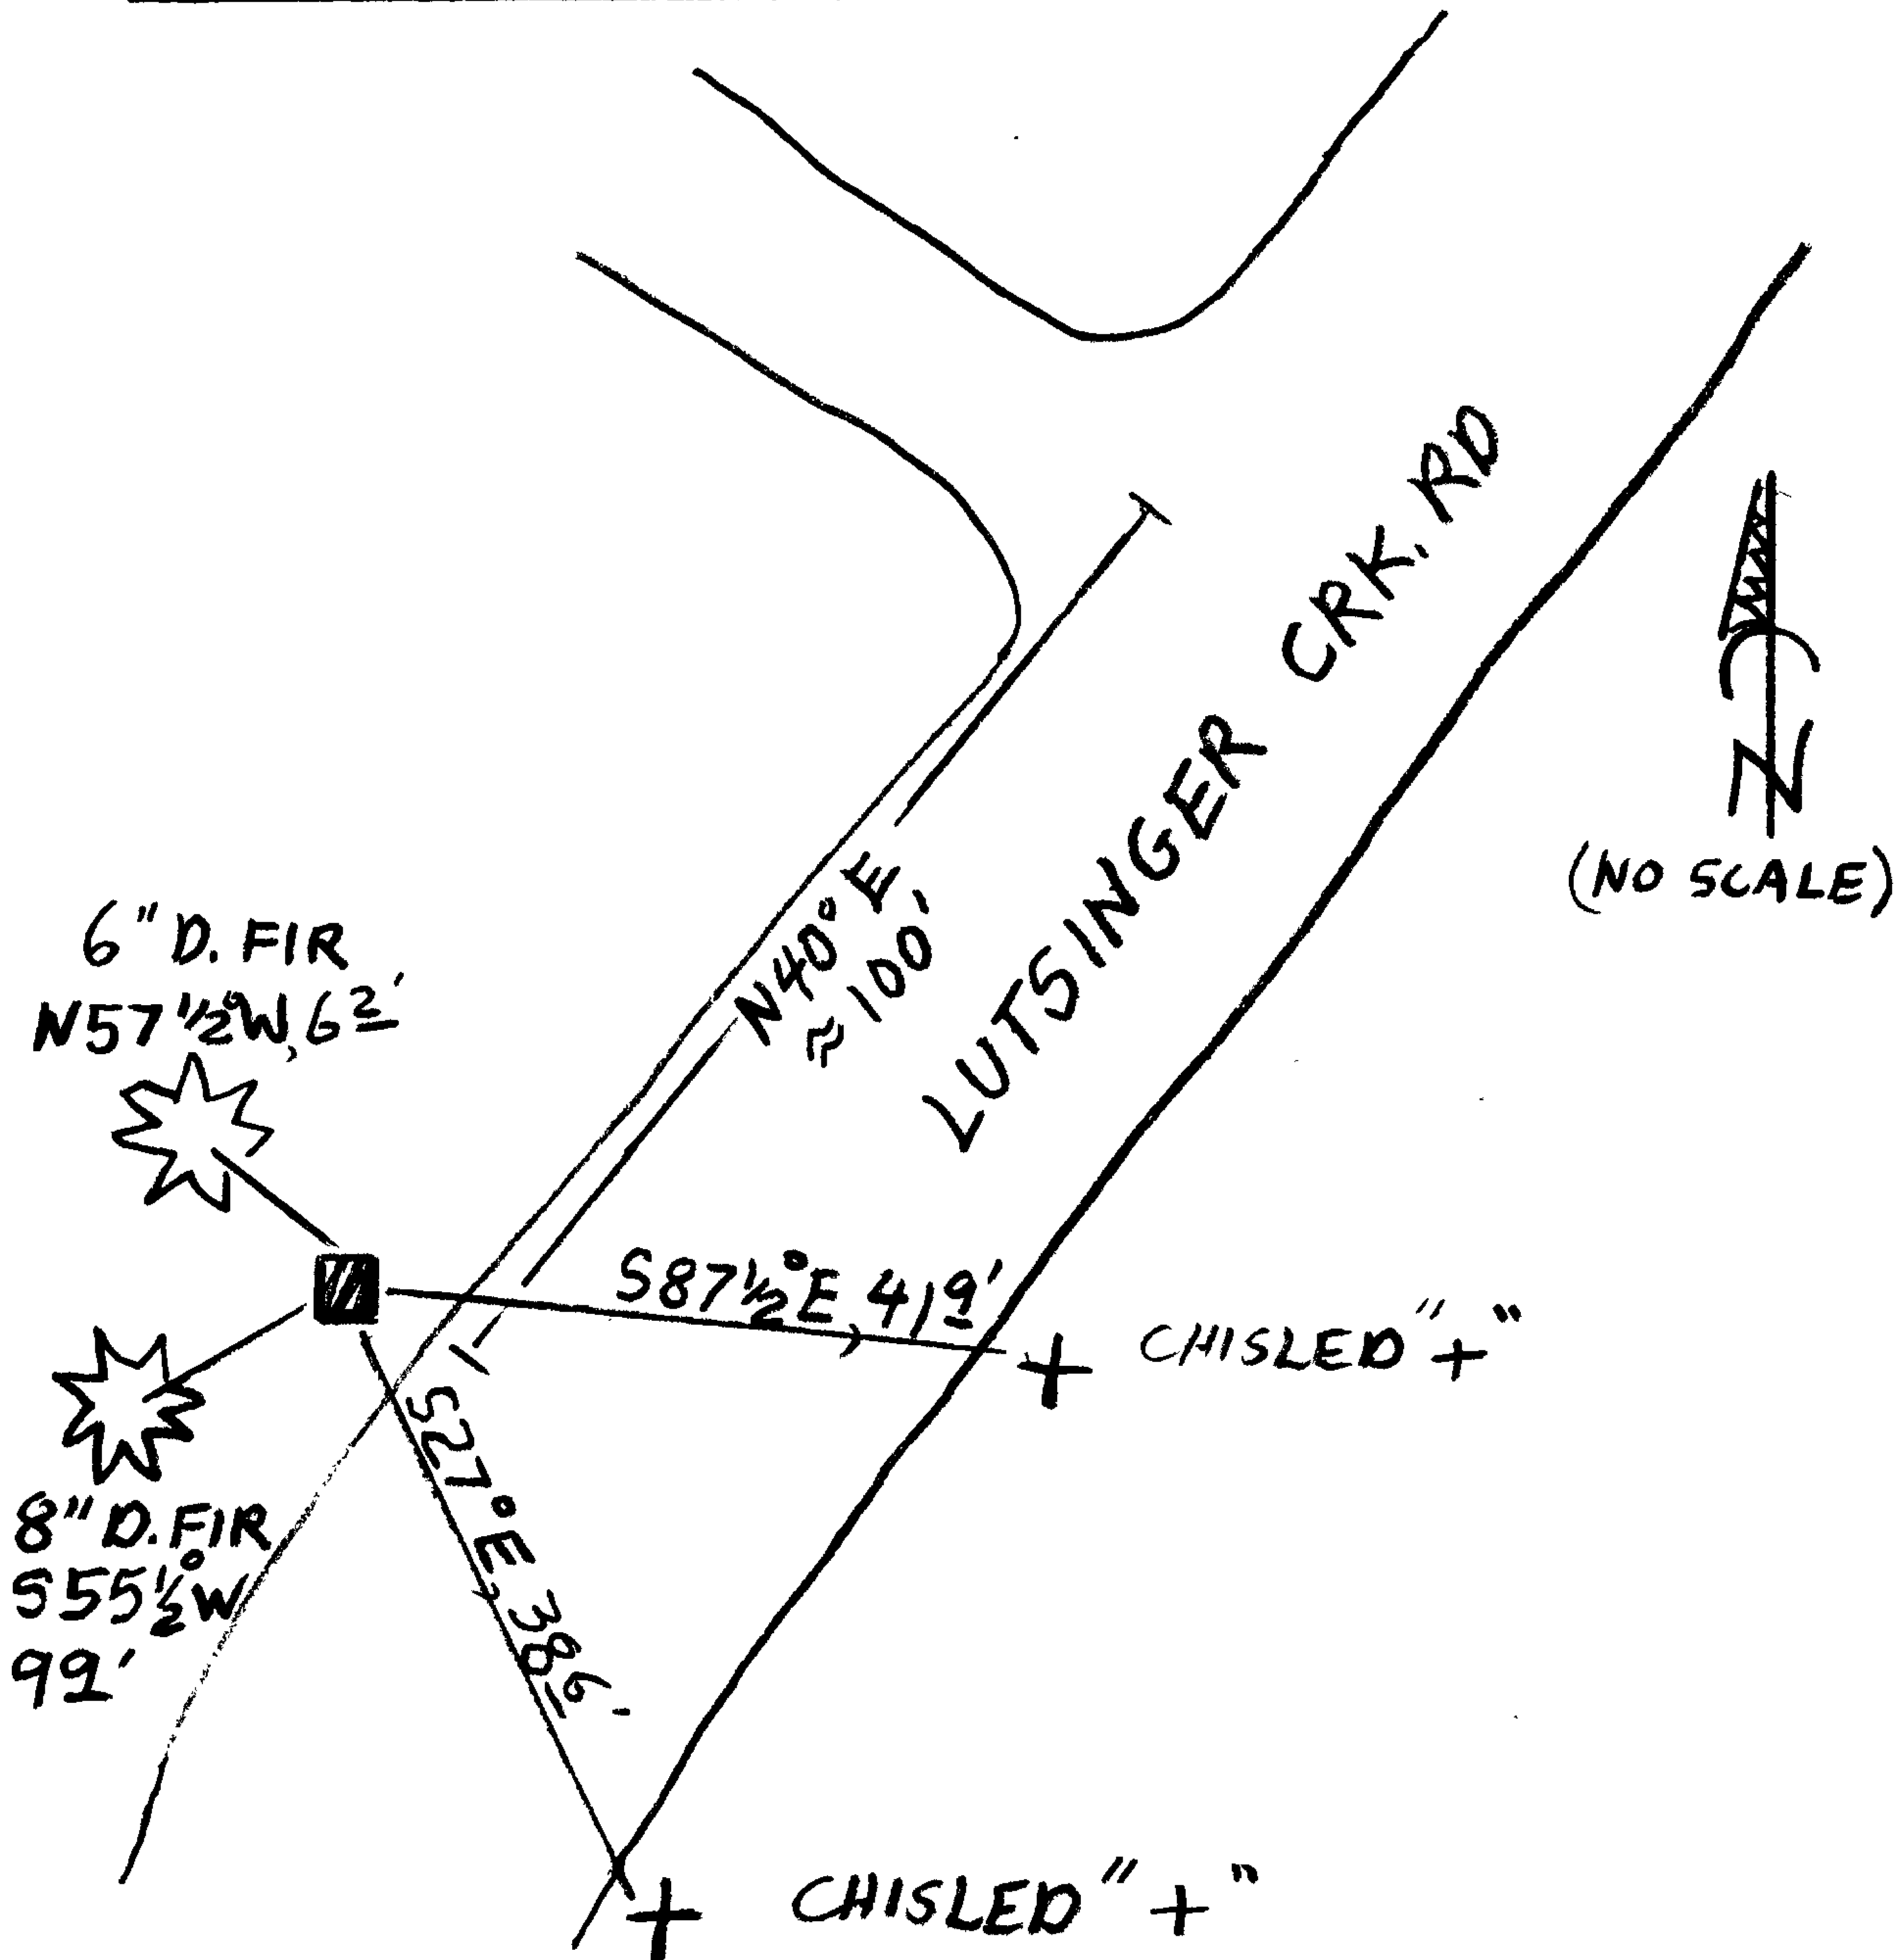

Location & Comments

Comp. Declin. 16 1/2° E
 Agency DCSO
 Party Chief STEVE FLAUSE
 Notekeeper STEVE FLAUSE
 Witnesses BILL BOHME

Address

Surveyor's Seal

REGISTERED
 PROFESSIONAL
 LAND SURVEYOR

Randall W. Smith
 RONDATE 6-30-2011

OREGON
 JULY 25, 1990
 RANDALL W. SMITH
 2400