

GOVERNMENT CORNER RESTORATION FORM

Date: 10/26/2010 By: JC

Township 29S Range 05W Sec. 26 County DOUGLAS

This survey consists of

State OREGON Date FEB. 24, 2010 No. 560200

Map:

Narrative:

Corner Rpt: 67/31-13

Corner Designation

E 1/16 526
535

DOUGLAS COUNTY SURVEYOR

Condition Report Only

Not Found

Renewed

Unrecorded

Surveyed In

Referenced Out

MONUMENT DETAIL

Previous Renewals NONE

Monument(s) Found: (Condition and Source)

A 2 1/2 INCH DIAM. BRASS CAP (MARKED AS AT RIGHT) ON A IRON PIPE FIRMLY SET AND PROTRUDING APPROX. 15 INCHES ABOVE GROUND. MONUMENT LEANS APPROX. 0.6 FT NORTHERLY FROM PLUMB. (MEASUREMENTS TO ACCESSORIES ARE TAKEN FROM PLUMB POSITION)

COUNTY SURVEYORS OFFICE

T29S R5W

526
535 E 1/16

1969

Accessories Found:

REMAINS OF TWO O.B.T.'S FOUND
A 28" D. FIR, NOW A DEAD 23 INCH D.B.H., APPROX. 35 FOOT TALL, D. FIR SNAG WITH A SINGLE BARK BLAZE MARKED "E 1/16 535 CS" (LOWER BLAZE WITH BT NOT SEEN); BEARS S 66° W, 338 FEET DISTANT, AS PER RECORD.

A 12" D. FIR, NOW A 12 INCH D.B.H., 6 FOOT TALL ROTTEN FIR STUB WITH AN UNHEALED UPPER BLAZE MARKED "E 1/16 526 CS" AND A ROTTED-OUT LOWER BLAZE; BEARS N 81° E, 29² FEET DISTANT (RECORD N 83° E, 29²)

RENEWAL

Monument Set (Procedure and Description)

Monument Detail


MONUMENT IS RETURNED TO PLUMB POSITION.

N/A

New Accessories

A 9 INCH D.B.H. DOUGLAS FIR SCRIBED "E 1/16 S 26 CS 13T" ON A DOUBLE BLAZE; BEARS N 62 1/2° E, 19° FEET DISTANT.
AN 8 INCH D.B.H. MADRONE SCRIBED "E 1/16 S 35 CS 13T"; BEARS S 55° E, 3° FEET DISTANT.

Sketch of Monument, Accessories, and General Area

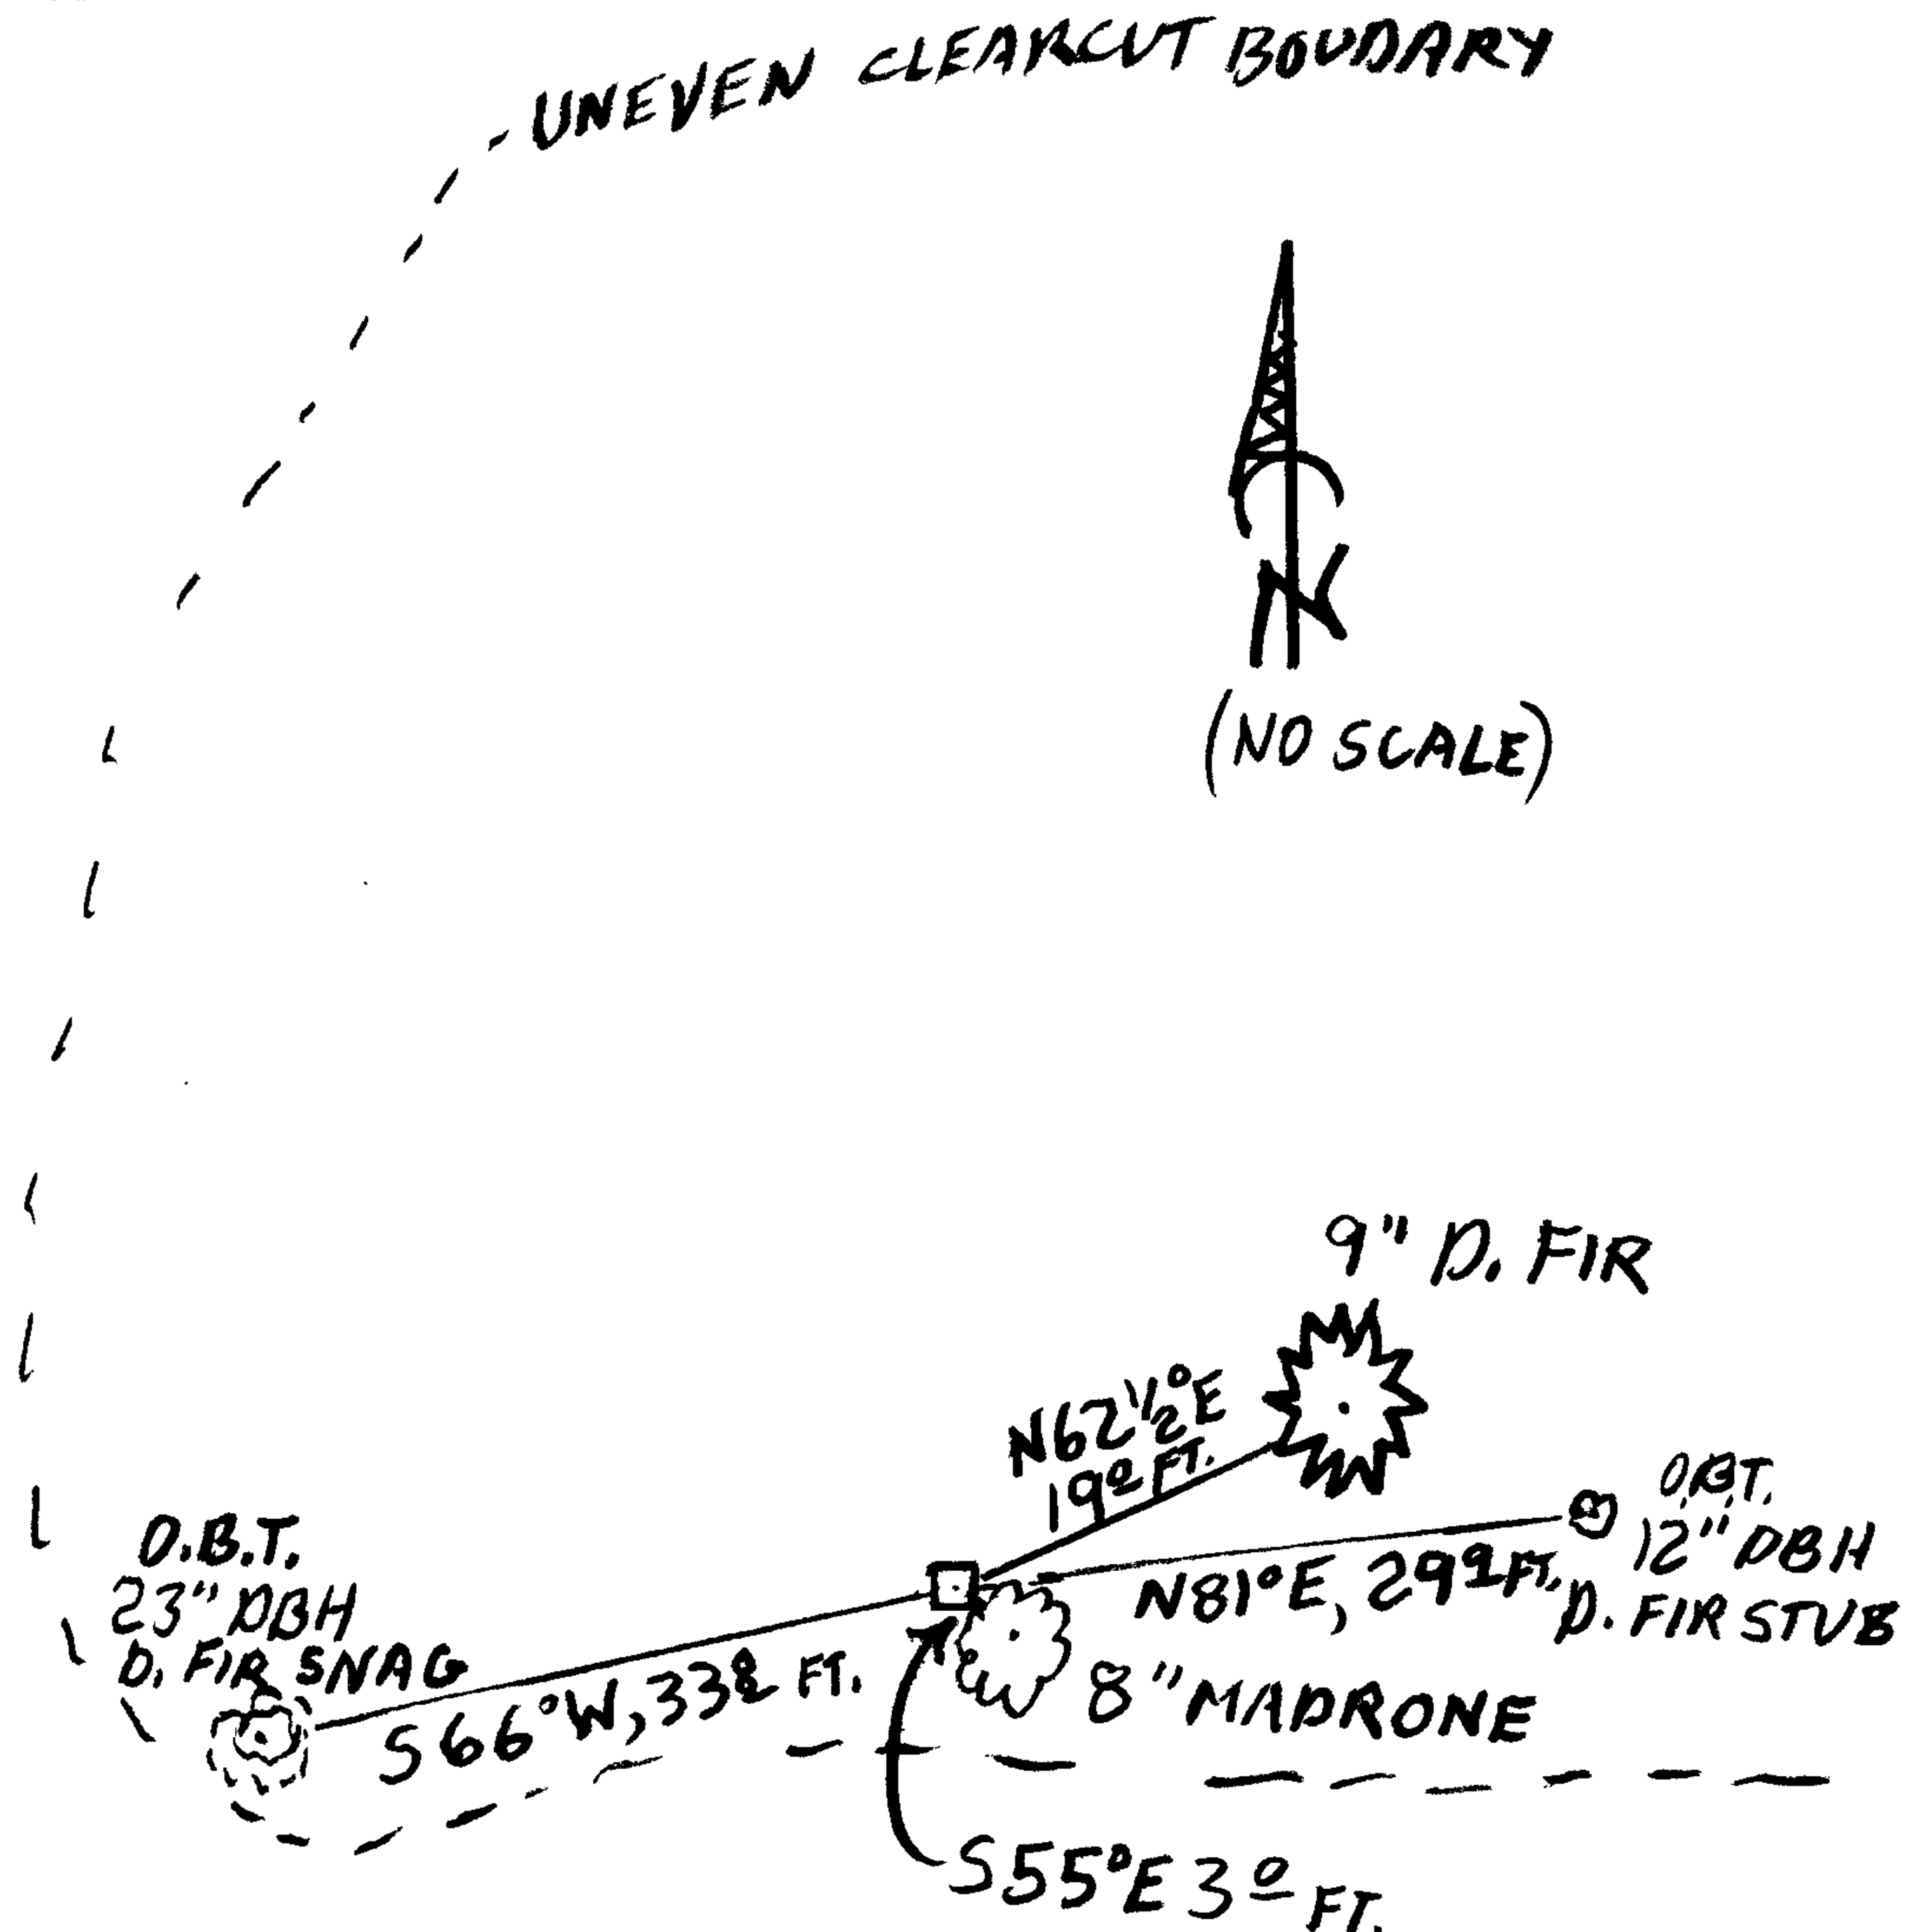

Location & Comments

MONUMENT IS IN SW CORNER OF OLDER CLEARCUT ON MODERATE NORTH SLOPE JUST EAST FROM SUBSTANTIAL NORTH RUNNING DRAW.

Comp. Declin. 16° E
Agency DCSD
Party Chief STEPHEN JOHN FLAUSE
Notekeeper Stephen John Flause
Witnesses JON EVERETT

Address

Surveyor's Seal

REGISTERED PROFESSIONAL LAND SURVEYOR

OREGON JULY 25, 1999 RANDALL W. SMITH 2488

RENEWAL 6-30-2012