

RENEWAL

Monument Set (Procedure and Description)

Monument Detail

DUE TO AGREEMENT OF BEARING AND DISTANCE TO FOUND O.B.T. WITH RECORD, AND AGREEMENT OF DISTANCES MEASURED TO ALL OTHER FOUND B.T.S WITH RECORD, A NEW MONUMENT IS SET FOR THE CORNER AT POSITION INDICATED BY ACCESSORIES FOUND.

NEW MONUMENT IS A 2 3/8 INCH DIAMETER BRASS CAP (MARKED AS AT RIGHT) ON A 1 3/8 INCH OD. BY 30 INCH LONG IRON PIPE FIRMLY SET PROTRUDING 8 INCHES ABOVE THE GROUND.

DOUGLAS COUNTY SURVEYOR

1/4
T24S | RBW
527 —•— 526

2010



New Accessories

A 12 INCH D.B.H. MADRONE, DOUBLE BLAZED AND SCRIBED "1/4 S26 CS BT", BEARS N27°E 27 3/4 FEET DISTANT.

NEAR THE TOP OF A 4 FOOT WIDE BY 4 FOOT TALL, SHALLOW, SANDSTONE OUTCROP IS MARKED A "+" WHICH MEASURES 6 INCHES BY 6 INCHES AND BEARS N81 1/2°E 10 1/2 FEET DISTANT.

Sketch of Monument, Accessories, and General Area

Location & Comments

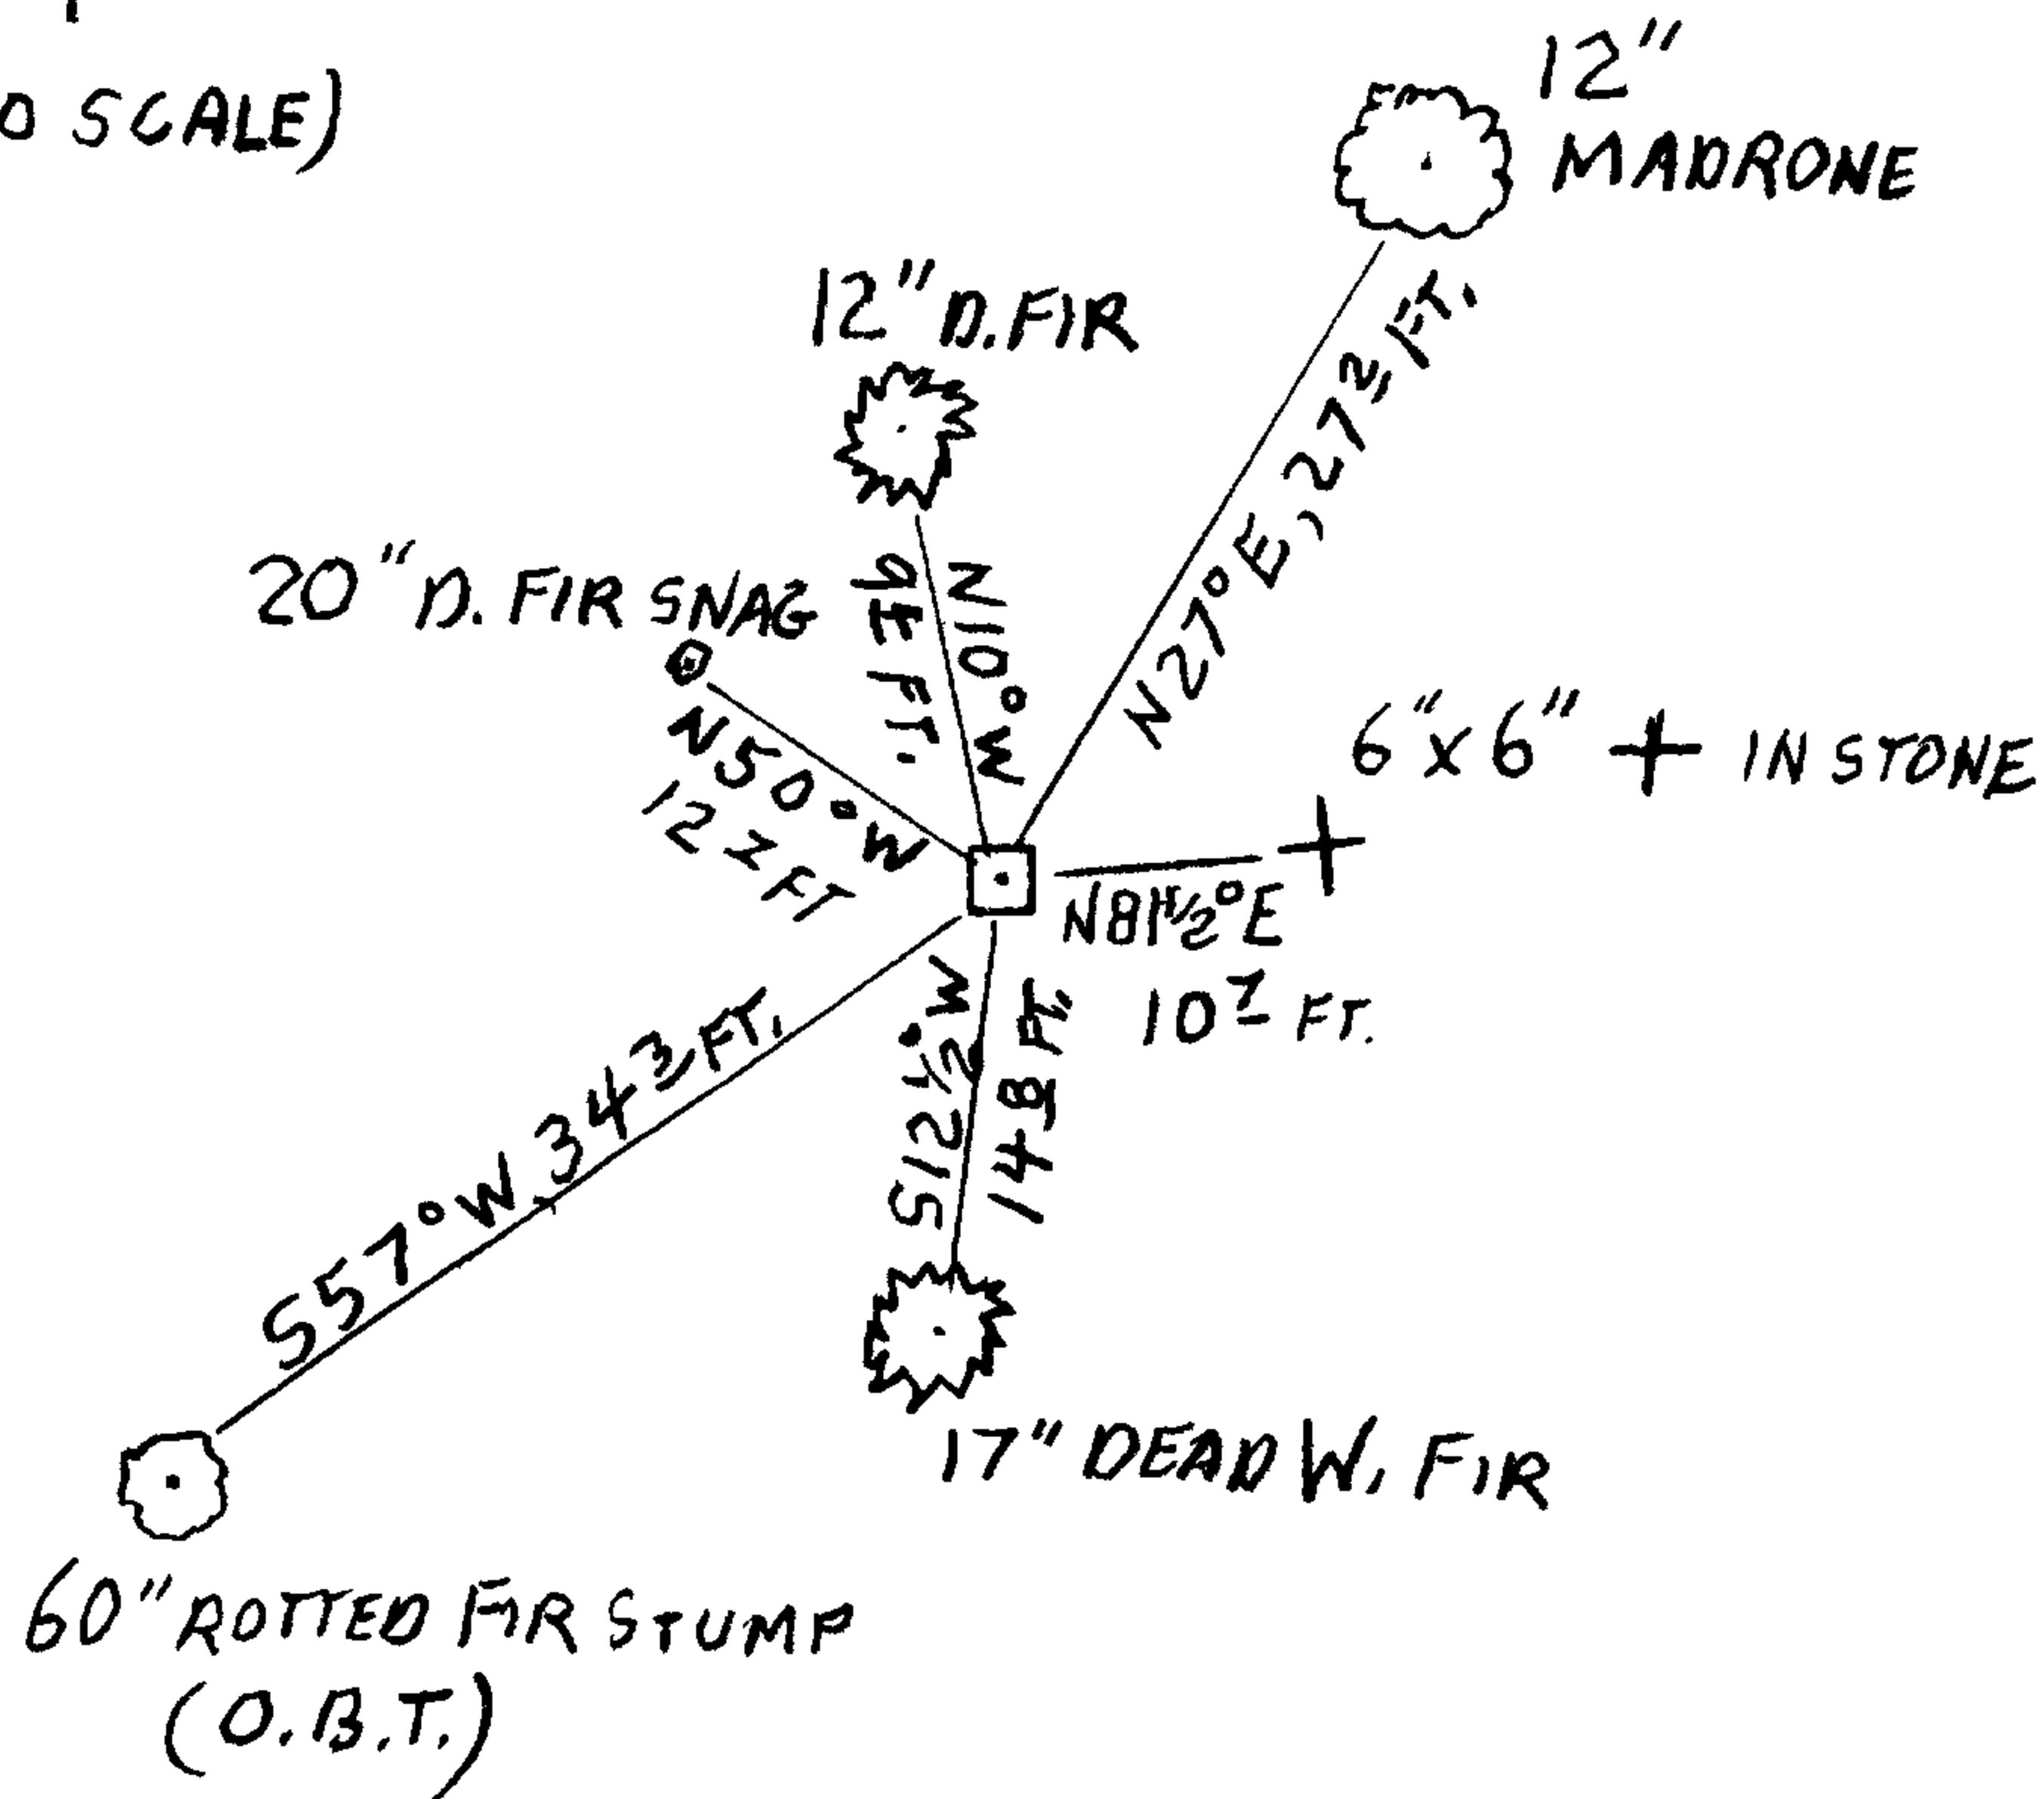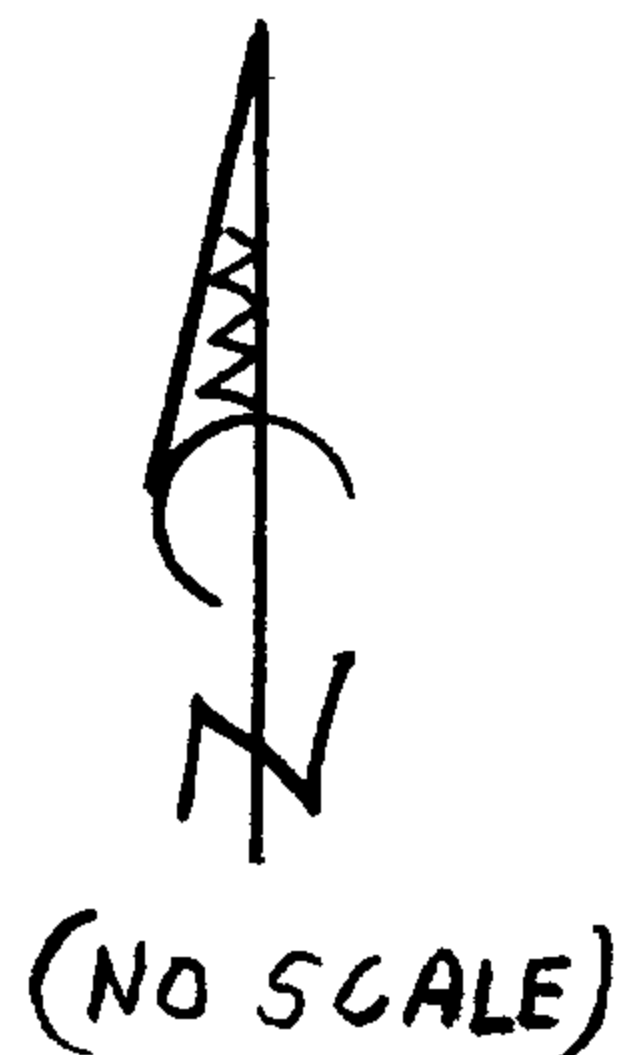

MONUMENT IS NEAR TOP OF STEEP EAST FACING SLOPE AT WESTERLY EDGE OLD GROWTH FOREST WHICH ABUTS OLDER REPROD. FOREST.

Comp. Declin. 16°E
Agency D.C.S.O.
Party Chief S. J. FLAUSE
Notekeeper Stephen John Flause
Witnesses GARRETT MCGRAW

Address

Surveyor's Seal
REGISTERED
PROFESSIONAL
LAND SURVEYOR

Randall W. Smith
6-30-2012

OREGON
JULY 25, 1900
RANDALL W. SMITH
2489