

GOVERNMENT CORNER RESTORATION FORM

Date: 4-6-2011 By: JC

Township 29 S Range 06 W Sec. 24

County DOUGLAS

This survey consists of:

State OREGON

Date MARCH 1, 2011

No. 640300

Narrative: CS 67/33-18
Corner Rpt: CS 67/33-18

Corner Designation

1/4 524
525

DOUGLAS COUNTY SURVEYOR

- Condition Report Only
- Not Found
- Renewed
- Unrecorded
- Surveyed In
- Referenced Out

Previous Renewals 1950, 1957, 1964

Monument(s) Found: (Condition and Source)

FOUND A 2 INCH I.P. W/ 2 1/2 INCH DCSO
P.I.C. DATED 1957 PROTRUDING 16" BENEATH
AN EAST - WEST FENCE LINE.

MONUMENT DETAIL

COUNTY SURVEYORS OFFICE

T29S R6W

1/4 S 24
25

1957

Accessories Found:

ORIGINAL BT. WAS 8" DIA. LAUREL NOW 29 INCH, BEARS S. 30° E. 6⁶ FEET
(AS PER REC.) WITH PREVIOUS REPLAZE NOW REHEALED
NO EVIDENCE OF ORIGINAL 10 INCH BT

FROM 1950 RENEWAL A 11 INCH LAUREL NOW 27 INCH, BEARS N. 43° W.
12 FEET DIST. BLAZE NOT EVIDENT

FROM 1957 RENEWAL 10 INCH FIR NOW 12 INCH, 7 FOOT HIGH
STUMP F.H. DB., BEARS N. 56° E. 33¹ FEET DIST (AS PER RECORD)
NO EVIDENCE OF 15 INCH FIR.

FROM 1964 RENEWAL NO EVIDENCE OF 14 INCH D. FIR FOUND.

RENEWAL

Monument Set (Procedure and Description)

Monument Detail

N/A

N/A

New Accessories


A 11 INCH D.B.H. W. OAK SCRIBED "1/4 S24 CS" "BT" ON DOUBLE BLAZE, BEARS N. 72 1/4° E, 47⁸ FEET DIST.

A 12 INCH D.B.H. D. FIR SCRIBED "1/4 S25 CS" "BT" ON DOUBLE BLAZE, S 28 1/2° W, 57² FEET DIST.

Sketch of Monument, Accessories, and General Area

Location & Comments

MONUMENT IS ON A FLAT BENCH WITH A CONIFER AND DECIDUOUS FOREST

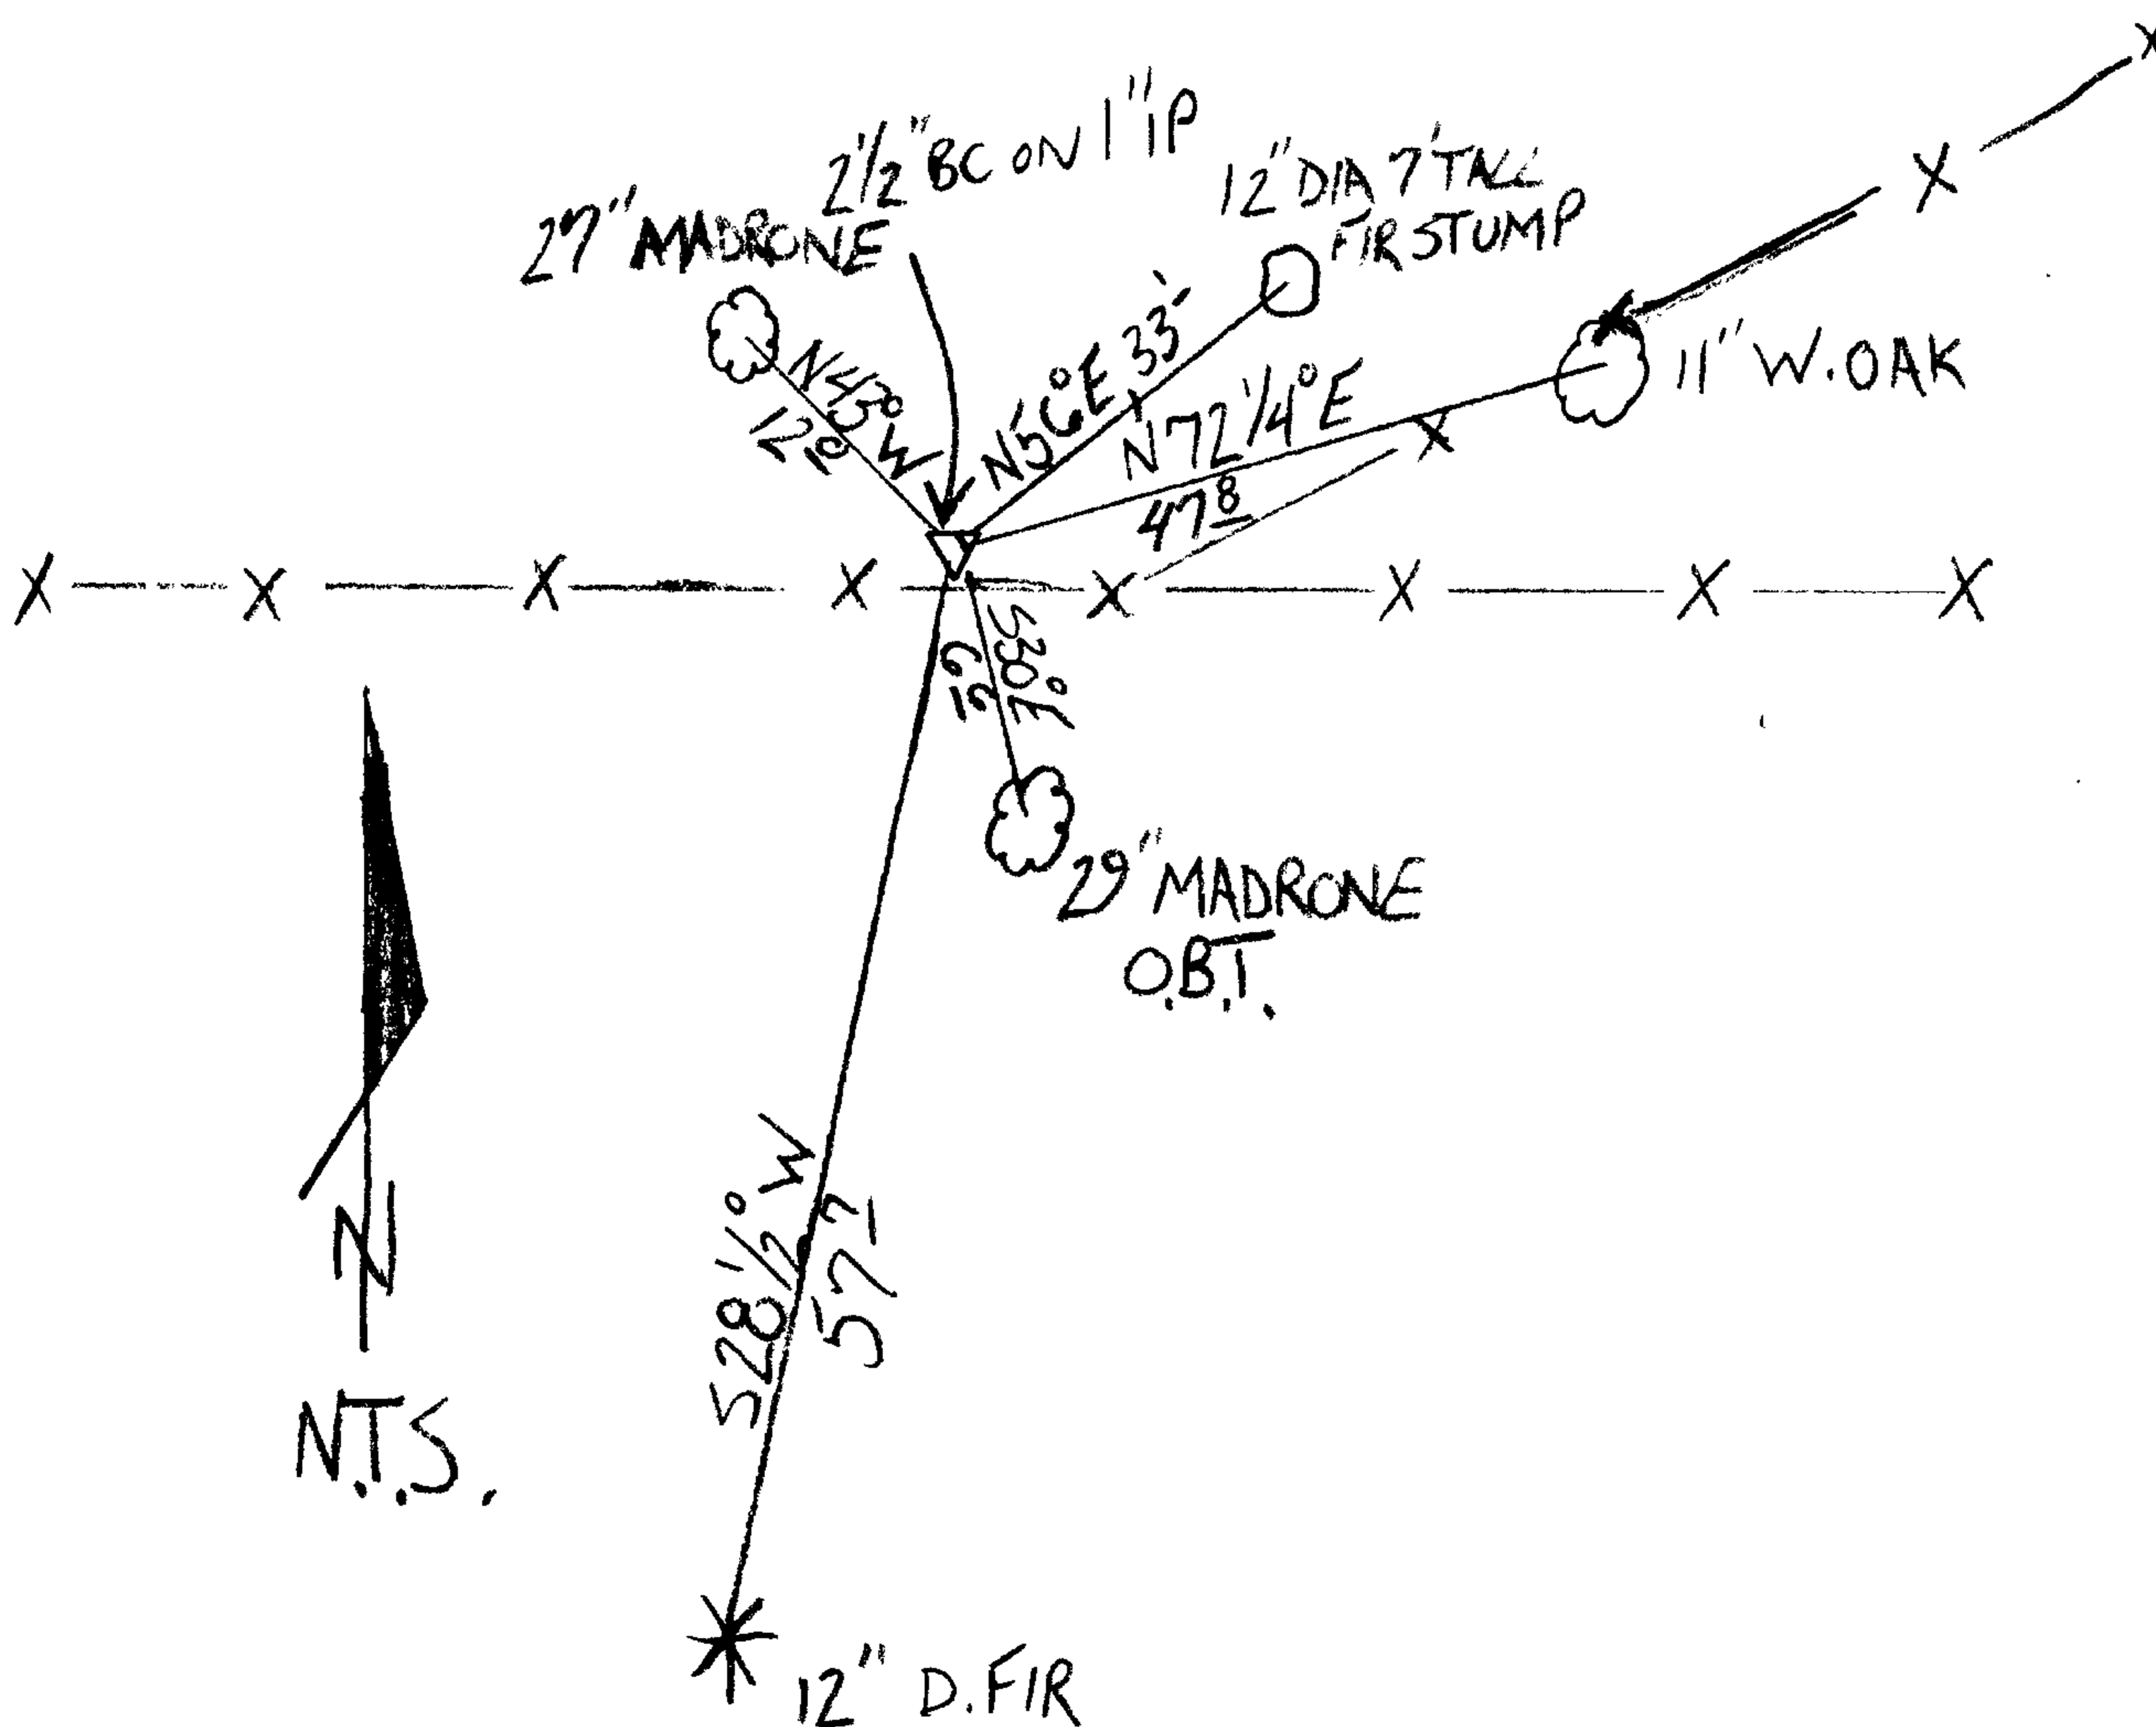

Comp. Declin. 15 3/4° E.
Agency DCSO
Party Chief STEPHEN JOHN FLAUSE
Notekeeper Michael S. Koch
Witnesses Mike S. Koch, Garretta McGraw

Address

Surveyor's Seal

REGISTERED PROFESSIONAL LAND SURVEYOR

Renewed Report
RENEWAL 6-30-2012

OREGON
JULY 25, 1990
RANDALL W. SMITH
2400