

GOVERNMENT CORNER RESTORATION FORM

FILED

Township 27S Range 07W Sec. 4

County DOUGLAS Date: 5/31/2011 By: X

State OREGON Date APRIL 11, 2011

No. 340600 Map: _____

Corner Designation

Narrative: _____
Corner Rpt: CS 67/33-34

$\frac{1}{4} \frac{54}{59}$

- Condition Report Only
- Not Found
- Renewed
- Unrecorded
- Surveyed In
- Referenced Out

Previous Renewals 1884, 1934, 1960

MONUMENT DETAIL

Monument(s) Found: (Condition and Source)
(A ROCK 18x10x6 NOW)

FROM 1884 AN UNMARKED 10x6 INCH SAND-
STONE MONUMENT FIRMLY SET AND PROT-
RUDES APPROX 10 INCHES ABOVE GROUND.

FROM 1960 A 2 1/2 INCH DIAMETER BRASS
CAP (MARKED AS AT RIGHT) ON 1 INCH I. D. IRON
PIPE IS FIRMLY SET AND PROTRUDES APPROX
14 INCHES ABOVE GROUND ON W. EDGE OF STONE.

POINTED TOP OF FOUND STONE AND CENTER
OF SLIGHTLY LEANING B.C. MONUMENT ARE
ESSENTIALLY CONCENTRIC; ACCESSORIES
ARE MEASURED FROM CENTER OF BRASS CAP.

COUNTY SURVEYOR'S OFFICE
T27S R7W

$\frac{1}{4} \frac{54}{59}$

1960

Accessories Found:

NO EVIDENCE OF ORIGINAL BEARING TREES.

EVIDENCE OF TWO 1934 RENEWAL BEARING TREES.
A 24" FIR, NOW A 4 FOOT TALL APPROX. 26 INCH DIAMETER PARTIALLY ROTTEN
FIR STUMP WITH THE SCRIBING "CS 13T" VISIBLE ON A PREVIOUSLY OPENED
SINGLE BLAZE; BEARS S 63° W, 18° FEET (RECORD S 60° W, 18° FEET).
AN 18" FIR, NOW A 1 FOOT TALL APPROX. 24 INCH DIAMETER VERY ROTTEN FIR
STUMP WHICH IS BROKEN OPEN TO FIND THE SCRIBING "S 13T" IN BLAZE REMNANT;
BEARS N 17° W, 45° FEET (AS PER RECORD).

FROM 1973 NORTH CRAFT SURVEY (FILED IN RCSD AS M 52-26) A 5/8 INCH
X 30 INCH IRON ROD IS LYING LOOSE ON SURFACE OF GROUND WESTERLY
15+ FEET FROM B.C. MONUMENT (RECORD S 89° 38' W 15 1/2 FEET).

RENEWAL

Monument Set (Procedure and Description)

Monument Detail


MONUMENTS ARE IN GOOD CONDITION; WE DO NOT DISTURB.

N/A

New Accessories

- AN 11 INCH D.B.H. BLACK OAK SCRIBED "1/4 S4 CS" "BT" ON A DOUBLE BLAZE; BEARS N49°E, 28² FEET DISTANT.
- A 16 INCH D.B.H. GRAND FIR SCRIBED "1/4 S9 CS" "BT" ON A DOUBLE BLAZE; BEARS S39°E, 35² FEET DISTANT.
- A 5 INCH D.B.H. STRONGLY PISTOL BUTT MADRONE SCRIBED "X" "CS BT" ON A HIGH-LOG DOUBLE BLAZE; THE CENTER OF THE ROOT CROWN OF WHICH BEARS S15°W, 10⁵ FEET DISTANT.
- A 10 INCH D.B.H. GRAND FIR SCRIBED "1/4 S4 CS" "BT" ON A DOUBLE BLAZE; BEARS N9¹/₂°W, 71⁴ FEET DISTANT.

Sketch of Monument, Accessories, and General Area

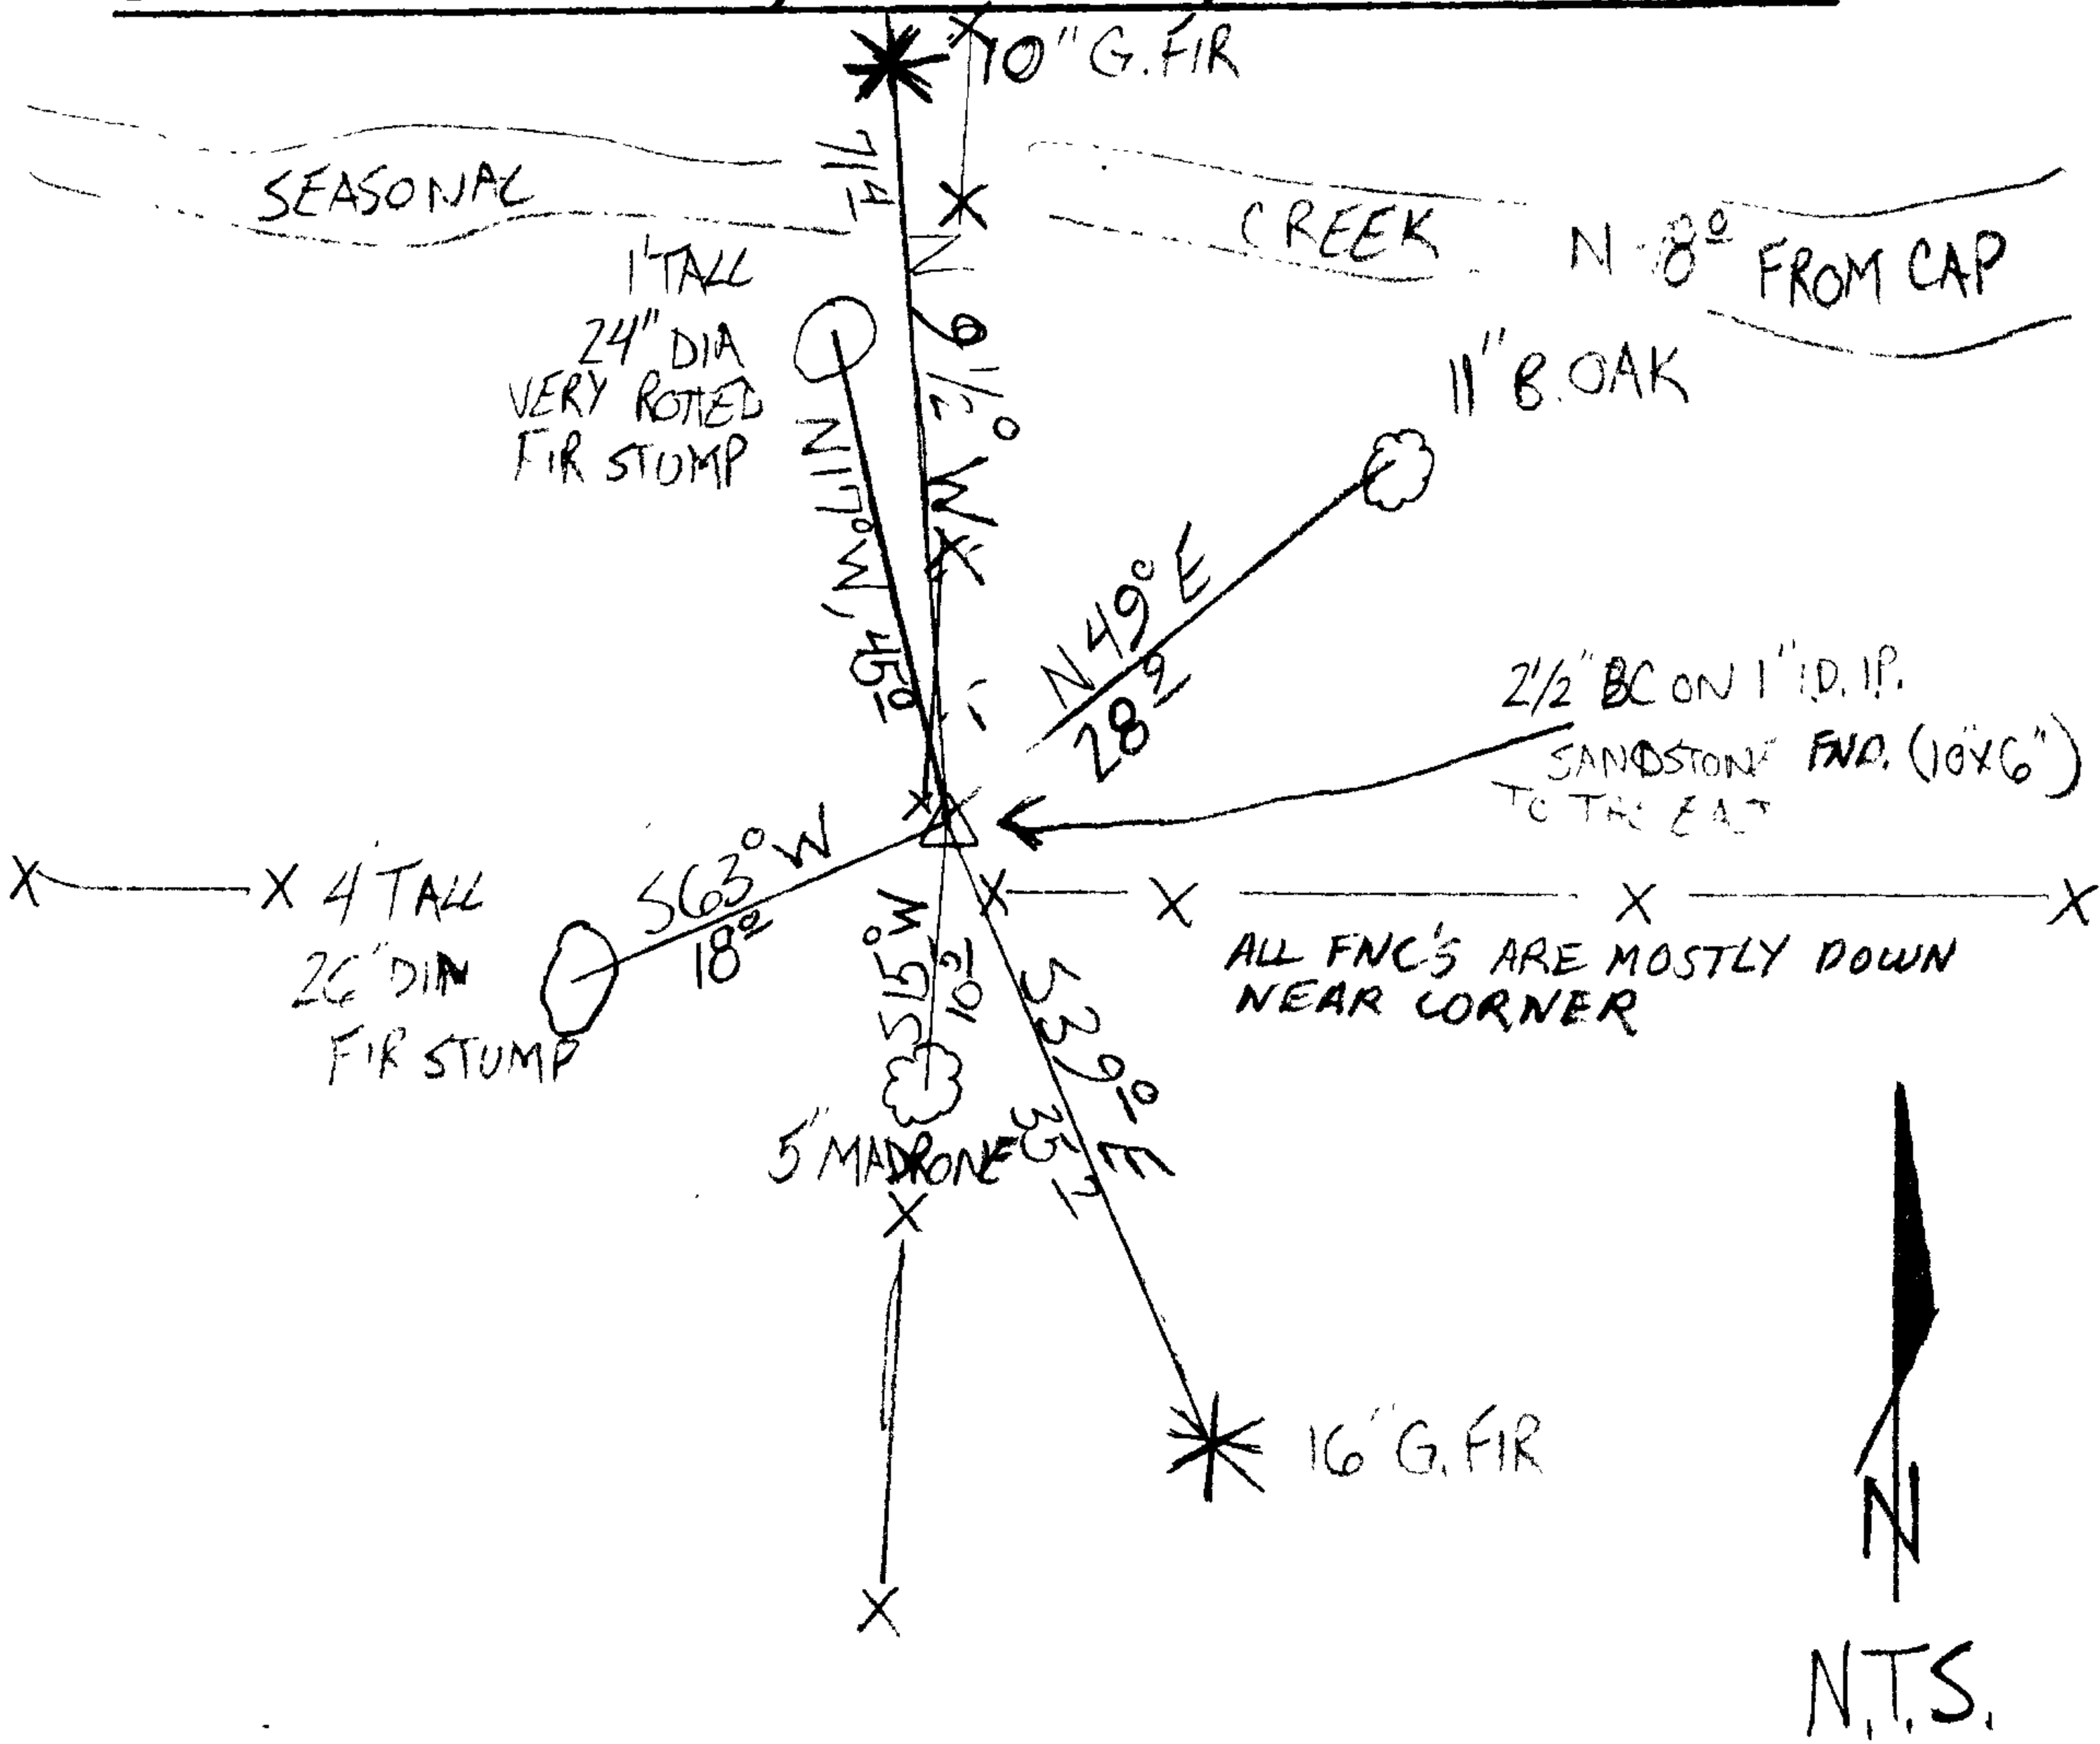

Location & Comments

CORNER IS ON GENTLE NORTHEAST SLOPE WHICH IS CLEAR CUT TO THE SOUTHWEST AND IS COVERED IN MIXED OLDER FOREST TO N.W., NE. AND S.E.

Comp. Declin. 15 3/4° E
 Agency DCSO
 Party Chief STEPHEN JOHN FLAUSE
 Notekeeper Stephen John Flause
 Witnesses MIKE S. KOCH
 GARRETT MCGRAW

Address

Surveyor's Seal
 REGISTERED PROFESSIONAL LAND SURVEYOR

OREGON
 JULY 25, 1990
 RANDALL W. SMITH
 2400

RENEWAL 6-30-2012