

GOVERNMENT CORNER RESTORATION FORM

FILED

Date: 5/31/2011 By: JC

Township 22 S Range 05 W Sec. 5

County DOUGLAS This survey consists of:

State OREGON Date APRIL 26, 2011

No. 200640 Narrative:

Corner Rpt: CS 67/33-36

Corner Designation

1/4
56 | 55

DOUGLAS COUNTY

- Condition Report Only
- Not Found
- Renewed
- Unrecorded
- Surveyed In
- Referenced Out

Previous Renewals 1992, 1995

MONUMENT DETAIL

Monument(s) Found: (Condition and Source)

WILFORD A. HAINES
235
SURVEY
POINT
DRAIN ORE.

A 1 INCH X 1 INCH HAINES T IRON WITH A 1 INCH BRASS WASHER (MARKED AS AT RIGHT) AT TOP IS FIRMLY AND PLUMBLY SET PROTRUDING 1 FOOT ABOVE GROUND. THIS MONUMENT IS OF UNKNOWN ORIGIN IT WAS FIRST NOTED AS FOUND IN 1992 RENEWAL.

Accessories Found:

EVIDENCE OF TWO ORIGINAL BEARING TREES:

A FIR 36" DIA., NOW A ROTTED 40 INCH DIAMETER, 3 FOOT TALL, FIR STUMP WITH NO REMAINING EVIDENCE OF BLAZES OR SCRIBING; BEARS S32°W, 39 1/2 FEET DISTANT (ORIGINAL RECORD S38°W, 38 3/4 FT (DISTANCE IS GOOD FACE MEASUREMENT), FOUND DISTANCE AGREES WITH 1992 RECORD).

A FIR 8" DIA., NOW A 20+ INCH DIAMETER ROTTED, FALLEN ON FACE, AND OUT OF POSITION FIR WITH POSSIBLE HEALED BLAZE. THE ROOT-HOLE OF THIS TREE BEARS N85°E, 19 3/8 FEET DISTANT (RECORD S88°E, 19 3/8 FEET).

FROM 1992 RENEWAL A BEARING TREE DESCRIBED AS FOUND, AND PROBABLY MARKED BY HAINES IN AN UNRECORDED RENEWAL. A 29" FIR, NOW A 35 INCH D.B.H. DOUGLAS FIR WITH A FULLY HEALED SINGLE BLAZE; BEARS S48°W, 26 1/2 FEET DISTANT (RECORD S51 1/2°W, 26 1/2 FEET DISTANT).

FROM 1995 TWO RENEWAL BEARING TREES FOUND. A 9" D. FIR NOW A DEAD 9 INCH D.B.H. DOUGLAS FIR WITH A SLIGHTLY HEALED SINGLE BLAZE WITH THE SCRIBING "1/4 55 BT" VISIBLE; BEARS S5°E, 5 3/4 FEET DISTANT (RECORD S02°E, 5.4').

A 17" D. FIR NOW A FALLEN AND ROTTED 17 INCH D.B.H. DOUGLAS FIR WITH A PARTIALLY HEALED SINGLE BLAZE SHOWING THE SCRIBING "1/4 55 BT". THE ROOT-HOLE OF THIS TREE BEARS N32°E, 34 6/8 FEET DISTANT (RECORD N34°E, 34 6/8').

RENEWAL

Monument Set (Procedure and Description)

Monument Detail

FOUND MONUMENT IS IN GOOD STABLE CONDITION.

N/A

New Accessories

A 15 INCH D.B.H. DOUGLAS FIR SCRIBED "1/4 55CS" "BT" ON A DOUBLE BLAZE; BEARS N47 1/2° E, 11⁵ FEET DISTANT.

A 23 INCH D.B.H. MAPLE SCRIBED "1/4 55CS BT" ON A SINGLE BLAZE; BEARS S62° E, 23³ FEET DISTANT.

A 12 INCH D.B.H. DOUGLAS FIR SCRIBED "1/4 56CS" "BT" ON A DOUBLE BLAZE; BEARS N13 1/2° W, 10⁵ FEET DISTANT.


Sketch of Monument, Accessories, and General Area

Location & Comments

MONUMENT IS APPROX. 2 FEET SOUTH FROM A DOWN EAST-WEST FENCELINE
MONUMENT IS ON A STEEP WESTERLY SLOPE IN AN OLD SECOND GROWTH FIR FOREST APPROX. 100 FEET NORTH FROM EDGE OF A LARGE NEWER CLEAR-CUT WITH CUT BOUNDARIES RUNNING SOUTH AND NORTHWEST.

Comp. Declin. 15 3/4° E
Agency DCSO
Party Chief STEPHEN JOHN FLAUSE
Notekeeper Stephen John Flause
Witnesses MIKE S. KOCH
GARRETT A. MCGRAW

Address

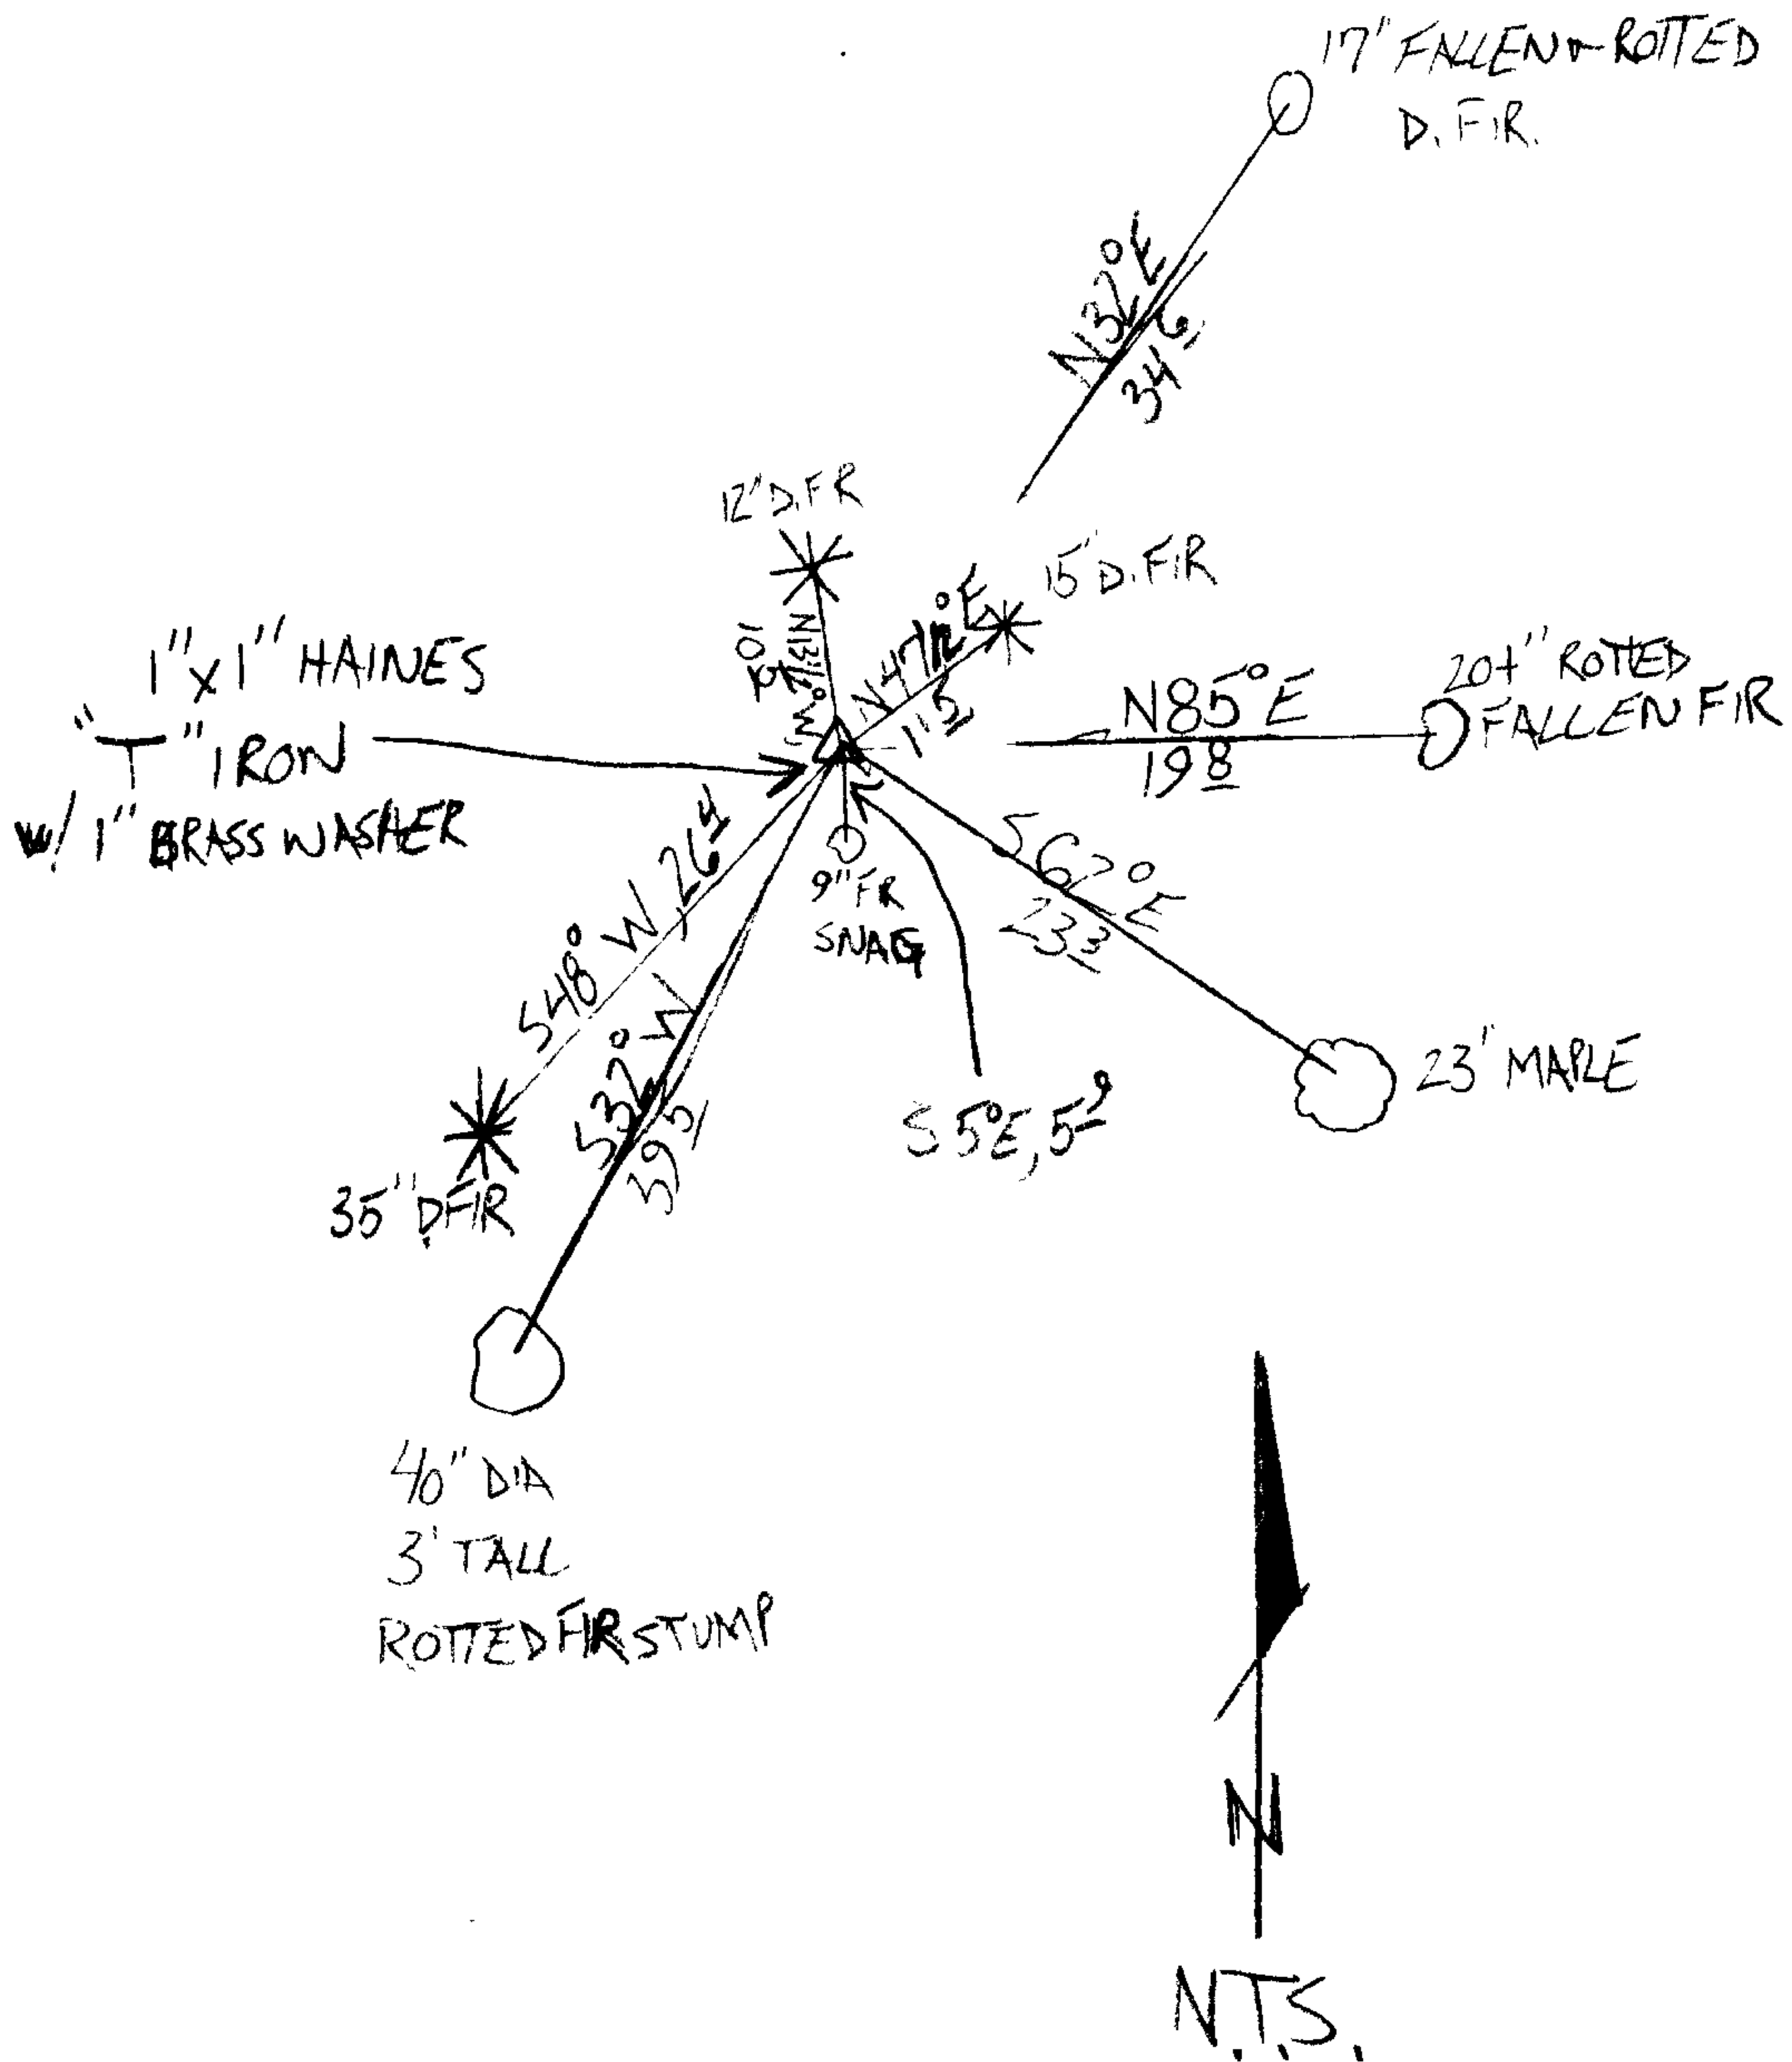

REGISTERED Surveyor's Seal
PROFESSIONAL LAND SURVEYOR
Randall W. Smith
RENEWAL 6-30-2012
OREGON
JULY 25, 1990
RANDALL W. SMITH
2488