

GOVERNMENT CORNER RESTORATION FORM

Date: 10-17-2011 By: JK

This survey consists of:

Township 22S Range 05W Sec. 12

County DOUGLAS Map:

State OREGON Date APRIL 28, 2011

No. 640500 Narrative: Corner Rpt: CS 67/33-40

Corner Designation

1/4 512  
+  
513

DOUGLAS COUNTY SURVEYOR

- Condition Report Only
- Not Found
- Renewed
- Unrecorded
- Surveyed In
- Referenced Out

MONUMENT DETAIL

Previous Renewals 1960, 1965, 1987

Monument(s) Found: (Condition and Source)

FROM 1988 DCSD RENEWAL A 2 3/8 INCH DIAMETER BRASS CAP (MARKED AS AT RIGHT) ON A 1 INCH I. D. IRON PIPE FIRMLY SET AND PLUMB PROTRUDING 4 INCHES ABOVE GROUND. ON NORTH EDGE OF S.C. MONUMENT THE 1960 ONE INCH I. D. ALUMINUM PIPE IS FIRMLY SET PROTRUDING 3 INCHES ABOVE GROUND.

DOUGLAS COUNTY SURVEYORS  
T 22 S  
1/4 512  
+  
513  
R 5 W  
1988

Accessories Found:

EVIDENCE OF TWO ORIGINAL BEARING TREES.

A FIR 40" DIA. NOW A 50 INCH DIAMETER VERY ROTTEN FIR STUMP WITH NO REMAINING BLAZES OR MARKS BEARS N 5° E, 74<sup>2</sup> FEET DISTANT TO CENTER OF ROOT CROWN (RECORD N 7° E, 71<sup>2</sup> FEET, DISTANCE IS GOOD FACE MEASUREMENT).

A FIR 8" DIA. NOW A TIPPED OVER 20 INCH DIAMETER 5 FOOT TALL FIR STUMP WITH AXE MARKS AND THE SCRIBING "B" VISIBLE ON AN OTHERWISE ROTTEN AWAY BLAZE. THE BASE OF THIS STUMP BEARS S 76° W, 72<sup>6</sup> FEET DISTANT (AS PER RECORD).

THE 1960 RENEWAL BEARING TREE

A 24" FIR NOW A FALLEN 26 INCH DIAMETER FIR WITH A FULLY HEALED BLAZE ("W" NAIL NOT SEEN); THE LARGE SHALLOW ROOT DEPRESSION OF THIS TREE IS REASONABLY LOCATED FOR THE RECORD BEARING AND DISTANCE.

TWO 1965 RENEWAL BEARING TREES

A 30" FIR NOW A 36 INCH D.B.H. DOUGLAS FIR 6 FOOT TALL STUMP WITH A PARTIALLY HEALED DOUBLE BLAZE SHOWING THE SCRIBING "1/4 512 CS" (LOWER BLAZE IS ROTTEN). THIS TREE BEARS N 82° E, 25<sup>2</sup> FEET DISTANT (RECORD N 82° E, 26<sup>2</sup> FT., DISTANCE IS A GOOD SLOPE MEASUREMENT).

A 10" W. FIR NOW A POSSIBLE ROOT-HOLE (NO REMNANTS OF TREE); BEARS S 43° W, 39<sup>4</sup> FEET DISTANT (AS PER RECORD).

TWO 1988 RENEWAL BEARING TREES. A 9" DIA. FIR NOW A 19 INCH D.B.H. DOUGLAS FIR WITH A FULLY HEALED SINGLE BLAZE; BEARS S 15° E, 17<sup>2</sup> FEET DISTANCE (RECORD S 13° E, 17<sup>2</sup> FT.)

AN 8" DIA. FIR NOW AN 11 INCH DIAMETER FALLEN DOUGLAS FIR WITH A PARTIALLY HEALED SINGLE BLAZE (ROTTEN FACE SHOWS NO SCRIBING); BEARS N 74 1/4° W, 20<sup>4</sup> FEET DISTANT (AS PER RECORD).

Monument Set (Procedure and Description)

Monument Detail

MONUMENT IS IN GOOD STABLE CONDITION.

N/A


New Accessories

A 1 1/2 INCH D.B.H. DOUGLAS FIR DOUBLE BLAZED AND SCRIBED "1/4 S12CS" "BT"; BEARS N27 1/2° E, 25<sup>2</sup> FEET DISTANT.

A 2 1/2 INCH D.B.H. DOUGLAS FIR DOUBLE BLAZED AND SCRIBED "1/4 S13CS" "BT"; BEARS S54 1/2° W, 17<sup>2</sup> FEET DISTANT.

A 6 INCH D.B.H. DOUGLAS FIR SCRIBED "X" "CS BT" ON A HIGH-LOW DOUBLE BLAZE; BEARS N50° W, 28<sup>6</sup> FEET DISTANT.

Sketch of Monument, Accessories, and General Area

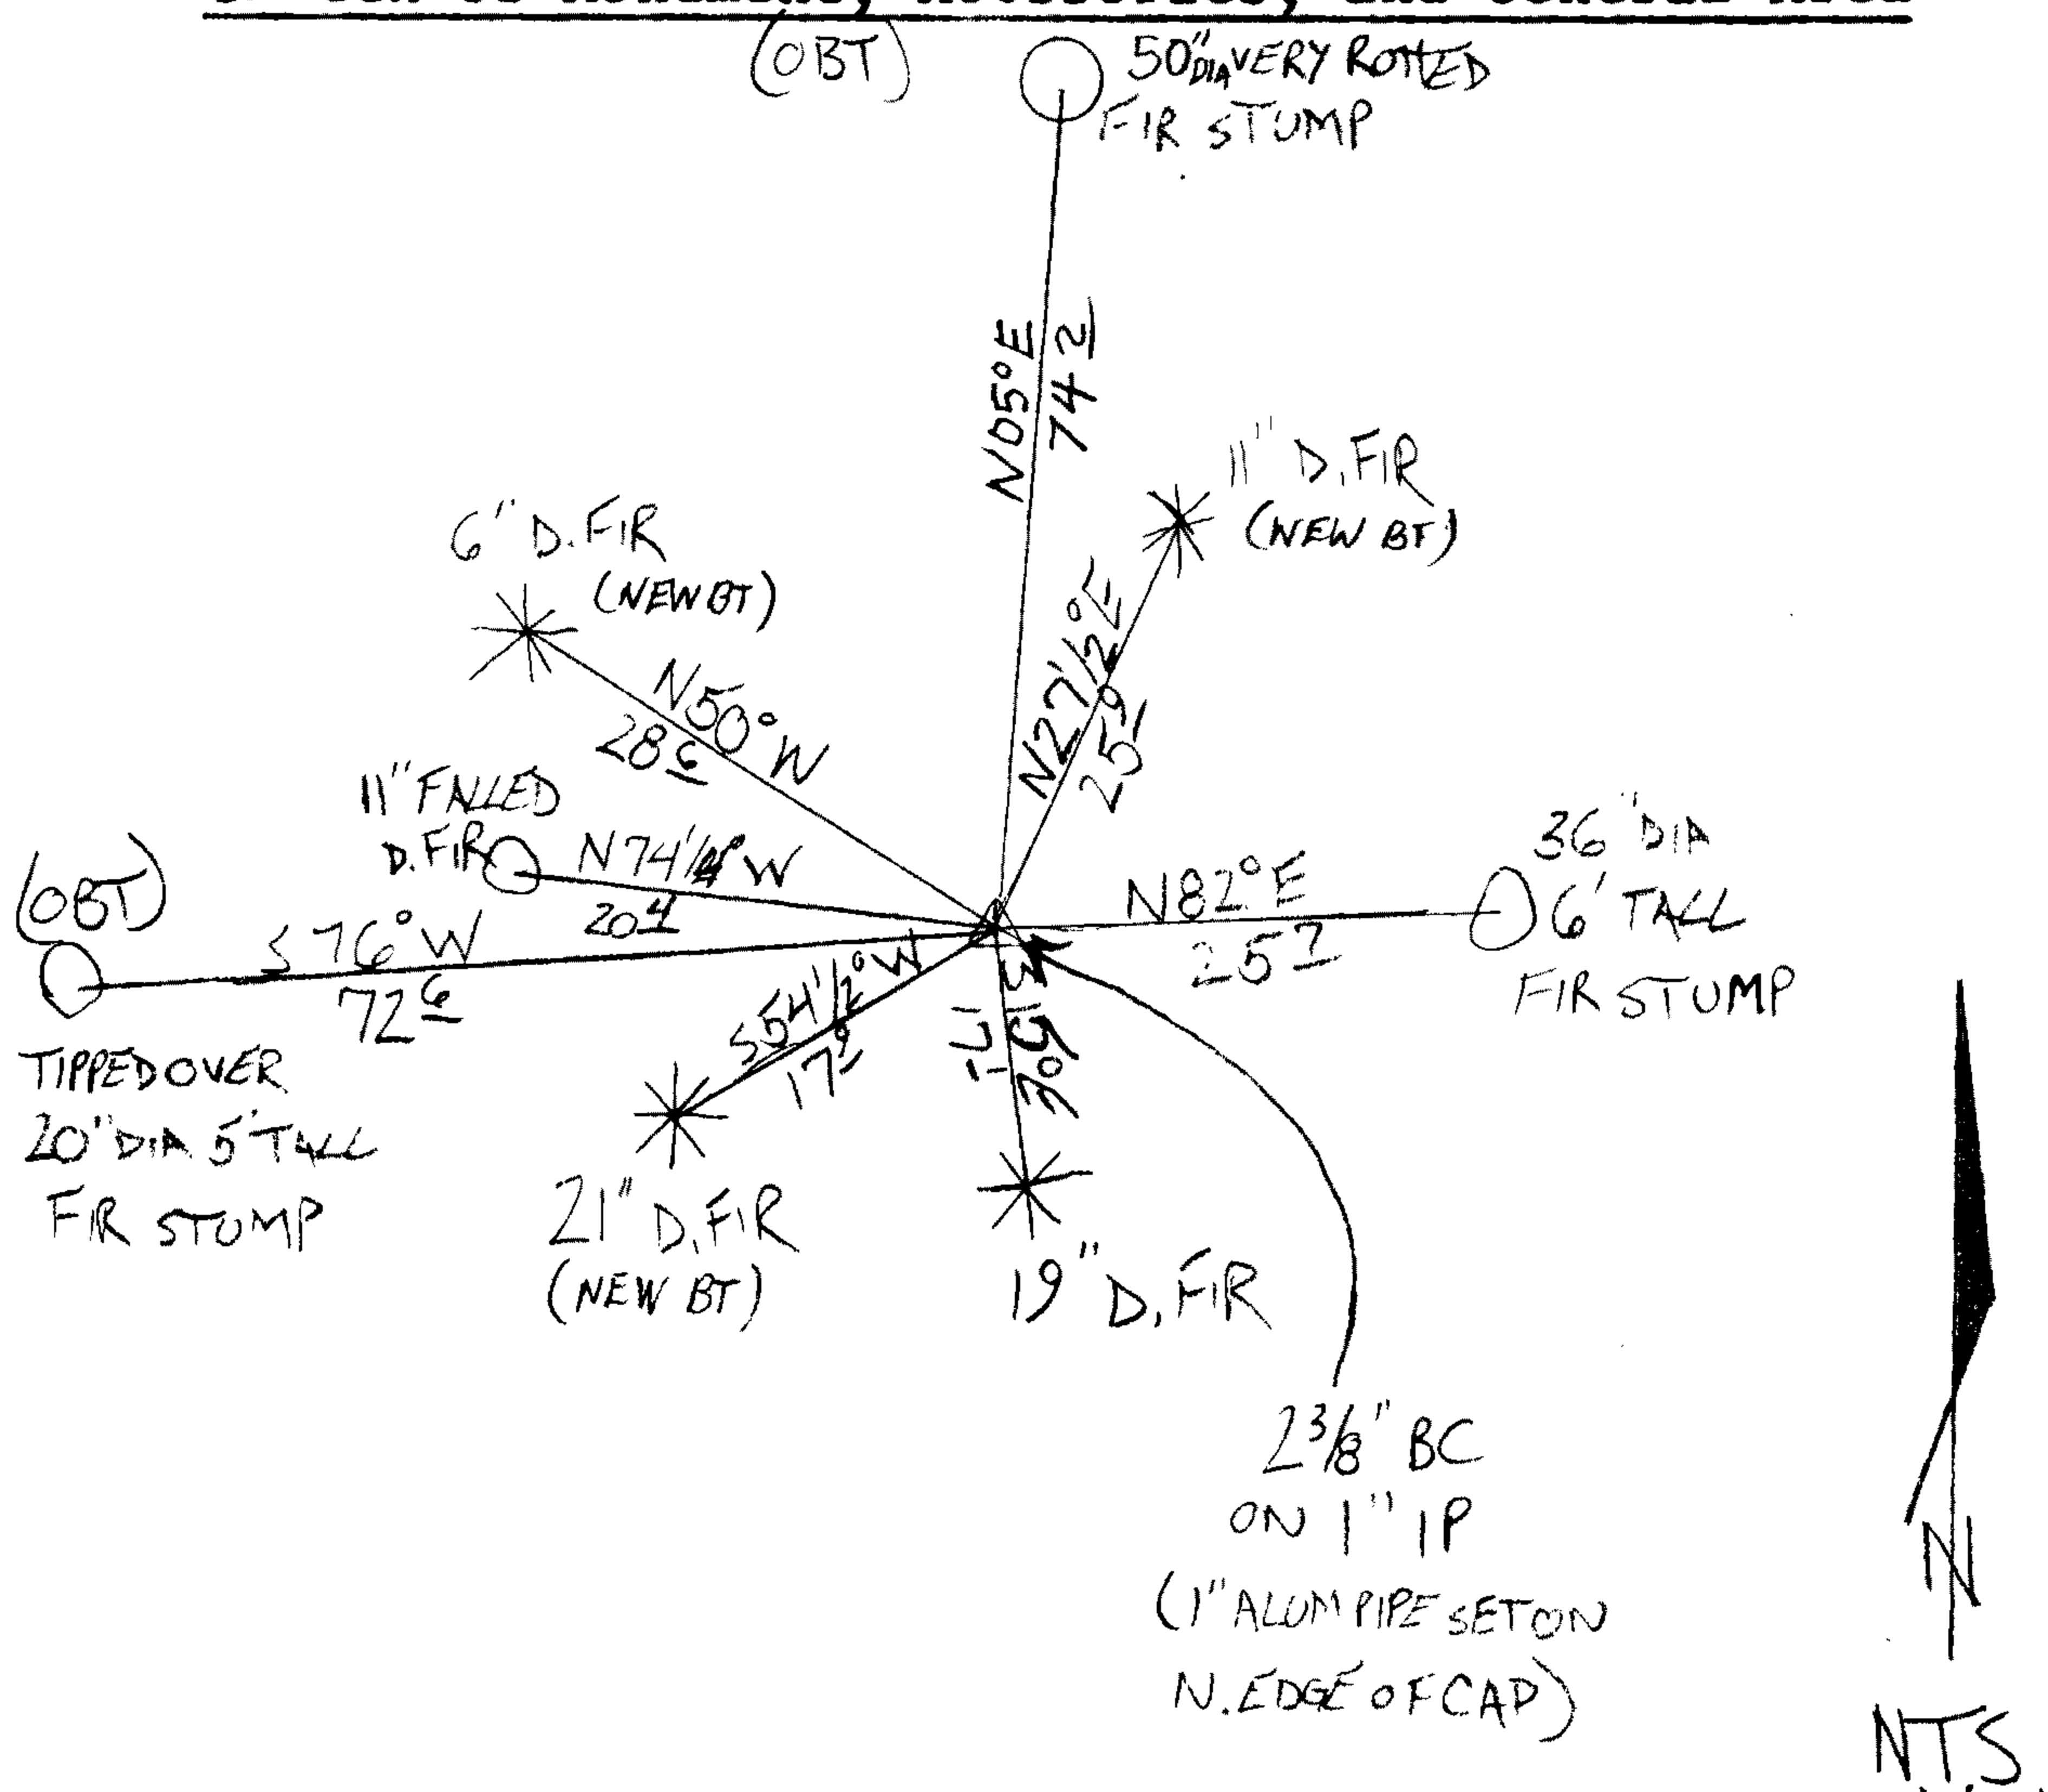

Location & Comments

MONUMENT IS ON GENTLE EAST SLOPE IN OLD SECOND GROWTH FIR FOREST.

Comp. Declin. 15 3/4° E  
 Agency D.C.S.O.  
 Party Chief STEPHEN JOHN FLAUSO  
 Notekeeper Stephen John Flauso  
 Witnesses MIKE S. KOCH  
 GARRETT A. MC GRAW

Address

Surveyor's Seal  
 REGISTERED  
 PROFESSIONAL  
 LAND SURVEYOR

*Signature of Randall W. Smith*

OREGON  
 JULY 28, 1990  
 RANDALL W. SMITH  
 2488

EXPIRES 6-30-2012