

GOVERNMENT CORNER RESTORATION FORM

Date: 10/17/2011 By: JC
This survey consists of:

Township 22 S Range 05 W Sec. 1 County DOUGLAS Map: _____
State OREGON Date JULY 21, 2011 No. 640600 Corner Ppt: CS 67/33-42
Narrative: _____

Corner Designation

1/4 51/512

DOUGLAS COUNTY SURVEYOR

- Condition Report Only
- Not Found
- Renewed
- Unrecorded
- Surveyed In
- Referenced Out

Previous Renewals 1952, 1982

Monument(s) Found: (Condition and Source)

FROM 1982 BLM (REPROPORTIONING) RESURVEY:
A 3 1/2 INCH DIAMETER ALUMINUM CAP (MARKED AS A RIGHT) ON A 2 1/2 INCH OD. IRON PIPE IS FIRMLY SET AND PROTRUDES 6 INCHES ABOVE GROUND. STAMPING ON CAP IS ORIENTED SOUTH.

SOME LOOSE STONES ARE FOUND NEAR RECORD BEARING AND DISTANCE NOTED IN 1982 RESURVEY FOR MCGILLICUDDY CORNER MONUMENT (STONES TOO FEW AND SCATTERED FOR ANY REASONABLE MEASUREMENT).

U.S. DEPARTMENT OF THE INTERIOR
T 22 S R 5 W
1/4 51/512
1982
BUR. OF LAND MANAGE

Accessories Found:

SEARCH MADE FOR 1884 LAUREL O.B.T.S. NO EVIDENCE FOUND.
FROM THE ABOVE NOTED MCGILLICUDDY SCATTERED STONES, EVIDENCE OF THE TWO 1952 BEARING TREES IS FOUND AT POSITIONS THAT AGREES REASONABLY WITH THE 1952 RECORD. THE SOUTHWEST 22" FIR IS NOW A MOSTLY ROTTEN AWAY FIR TREE STUMP AND THE NORTHWEST 34" FIR IS NOW A 4.5 INCH DIAMETER 3 FOOT TALL ROTTEN FIR STUMP WITH A POSSIBLE HEALED BLAZE (NOT OPENED).

FROM THE ABOVE 1982 B.L.M. ALUMINUM CAP MONUMENT EVIDENCE OF TWO BEARING TREES IS FOUND:
A FIR 16" DIA. NOW A 2 FOOT TALL 2 1/2 INCH DIAMETER FIR STUMP WITH A PARTIALLY HEALED SINGLE BLAZE (MOSTLY ROTTEN AWAY) SHOWING SOME ILLEGIBLE SCRIBING AND A "BT"; BEARS N 30 1/2° E, 22 1/2 FEET DISTANT (AS PER RECORD).
A FIR 11" DIA. NOW A 17 INCH D.B.H. DOUGLAS FIR WITH A FULLY HEALED SINGLE BLAZE BEARS S 73 1/4° E, 22 1/2 FEET DISTANT (RECORD S 5° E, 23 1/2 FT. BASE IS SOMEWHAT PISTOL-BUTT, MAY ACCOUNT FOR DISCREPANCY).

RENEWAL

Monument Set (Procedure and Description)

Monument Detail

STABLE MONUMENT ACCEPTED AS FOUND.

N/A


New Accessories

A 1 INCH D.B.H. DOUGLAS FIR SCRIBED "1/4 S 1 CS" "BT" ON A DOUBLE BLAZE BEARS N09 1/2° E, 3 2 FEET DISTANT.

A 12 INCH D.B.H. GRAND FIR SCRIBED "1/4 S 12 CS" "BT" ON A DOUBLE BLAZE BEARS S47 1/2° E, 24 1/2 FEET DISTANT.

A 9 INCH D.B.H. DOUGLAS FIR SCRIBED "1/4 S 12 CS" "BT" ON A DOUBLE BLAZE BEARS S54° W, 14 1/2 FEET DISTANT.

Sketch of Monument, Accessories, and General Area

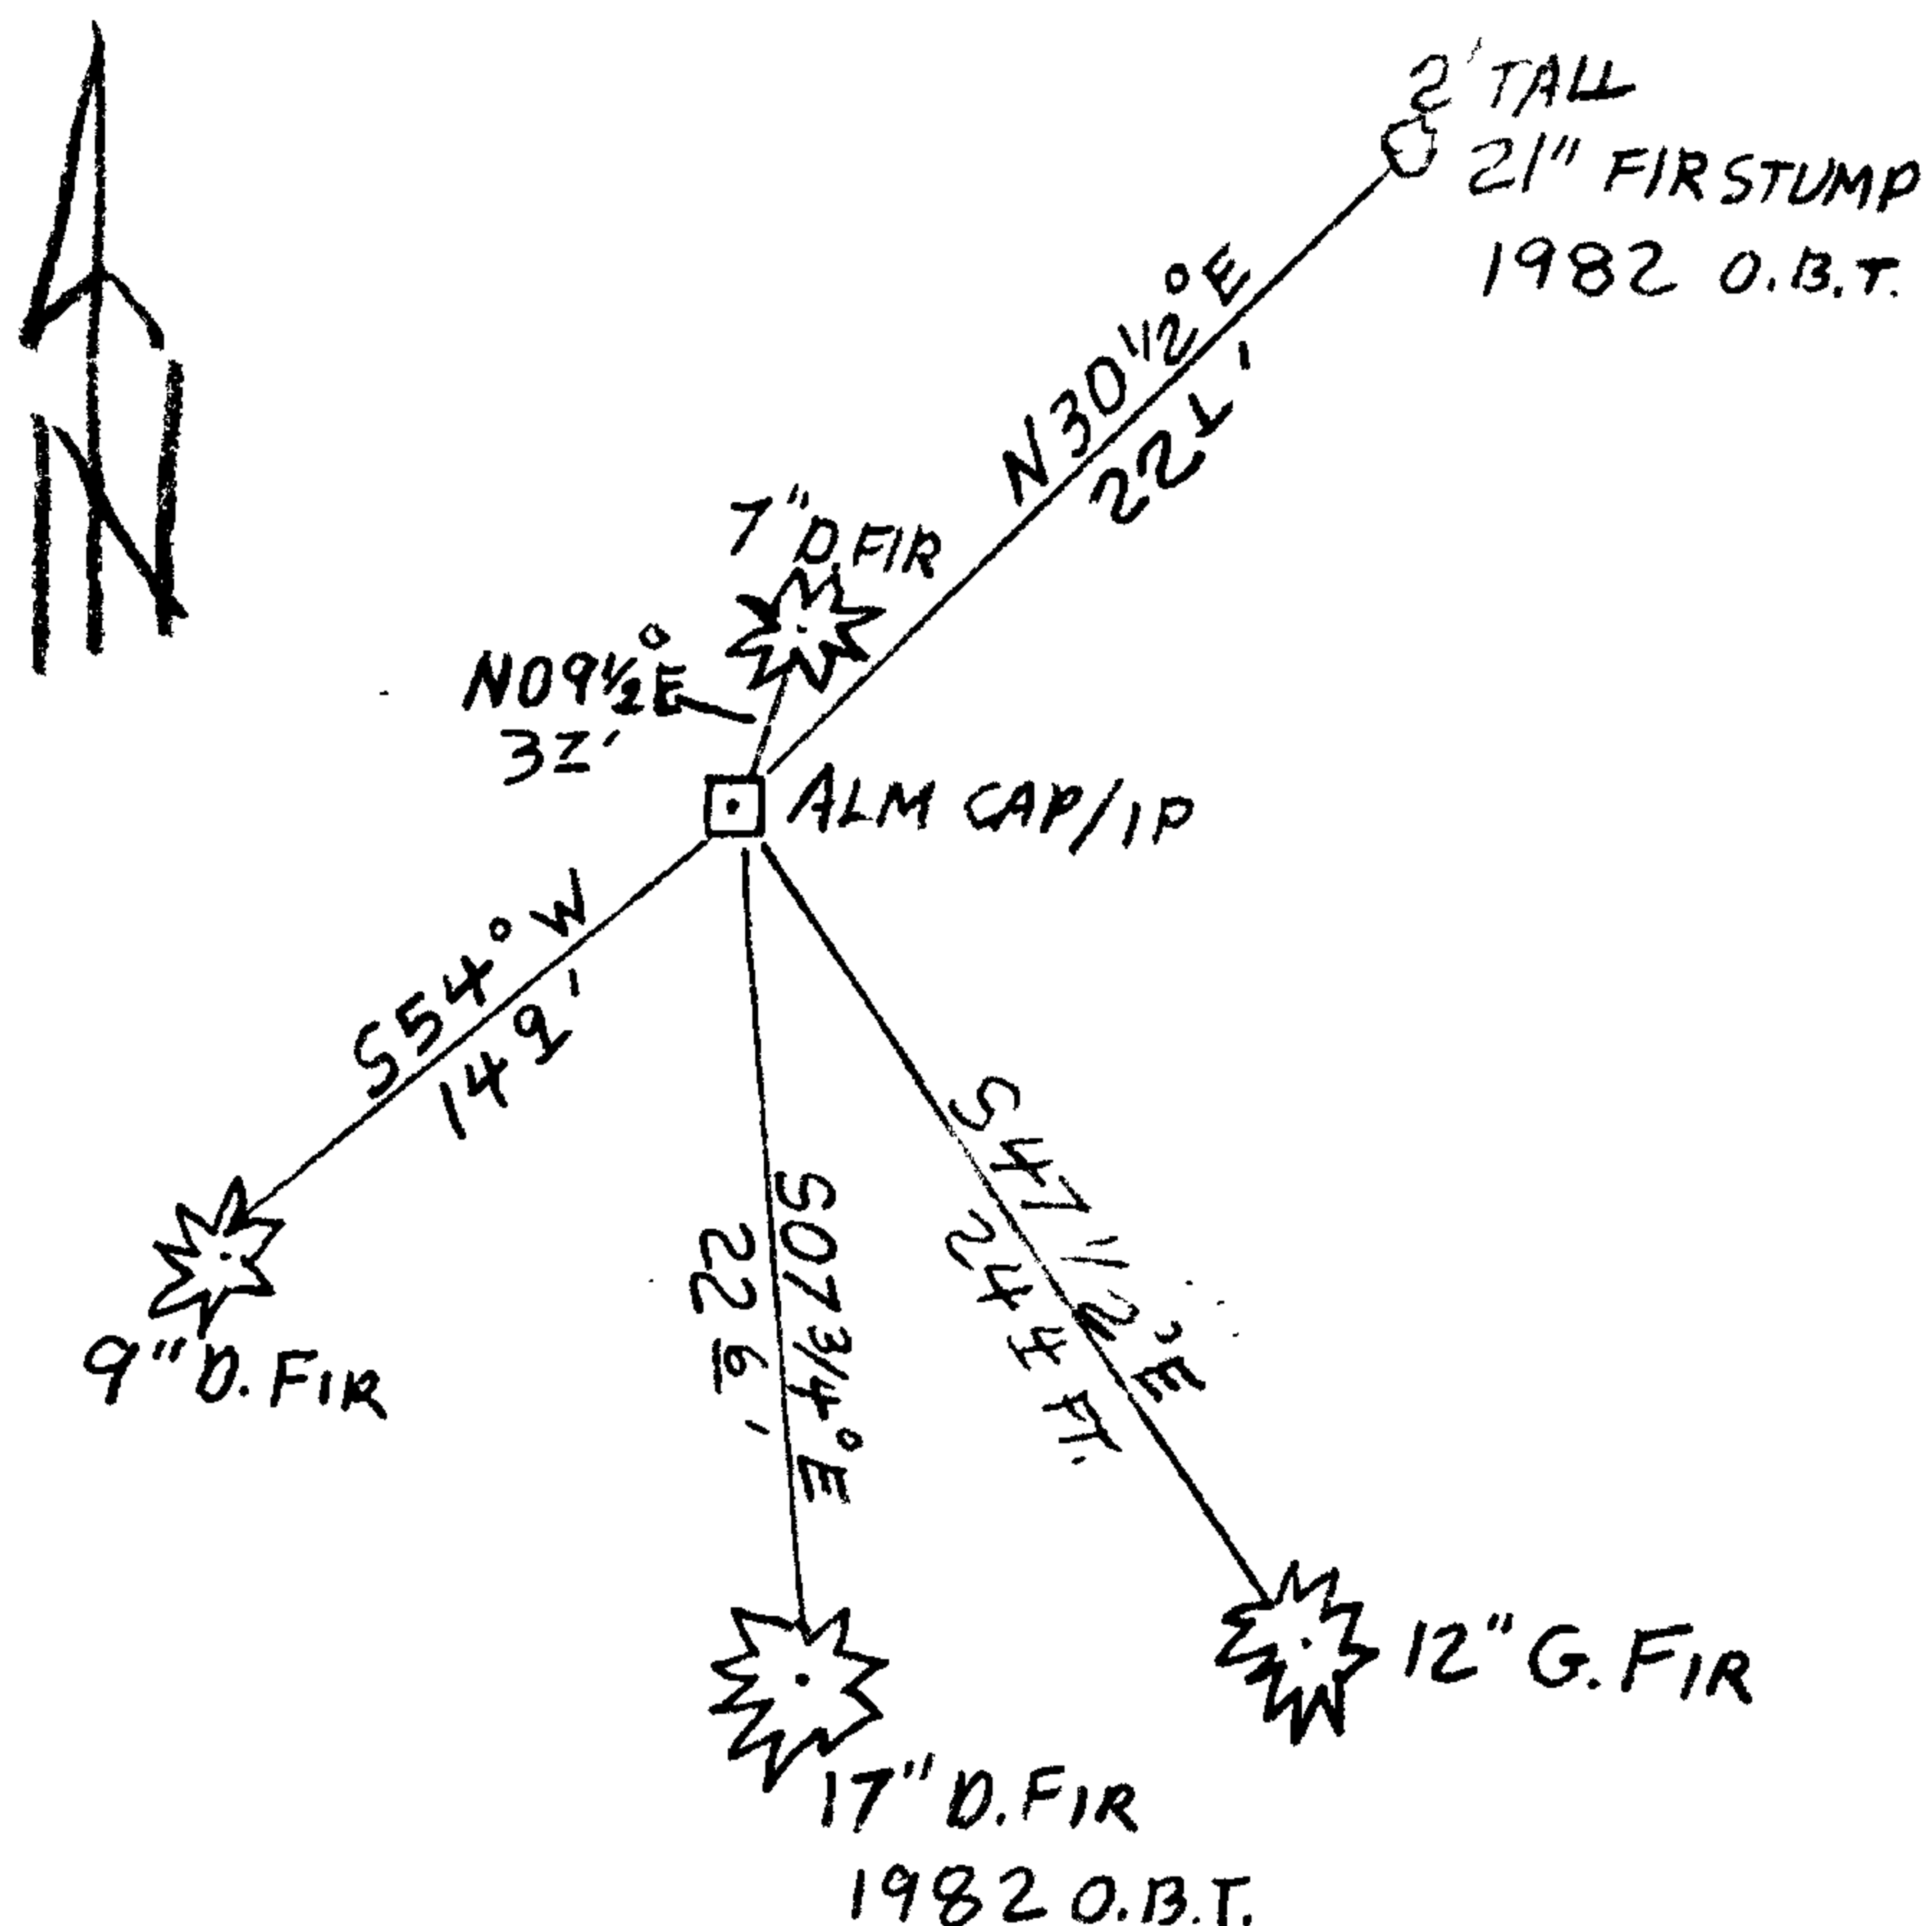

Location & Comments

MONUMENT IS ON A MODERATE WSW SLOPE AT THE NORTH EDGE OF A NEWER CLEAR-CUT AND THE SOUTH EDGE OF AN OLDER FIR REPROD. FOREST

Comp. Declin. 15 3/4° E
Agency DCSO
Party Chief STEPHEN JOHN FLAUSE
Notekeeper Stephen John Flause
Witnesses MIKE S. KOCH, JASON E. MARTIN

Address

Surveyor's Seal

**REGISTERED
PROFESSIONAL
LAND SURVEYOR**

Randall W. Smith

OREGON
JULY 25, 1980
RANDALL W. SMITH
2488

EXPIRES 6-30-2018