

GOVERNMENT CORNER RESTORATION FORM

Date: 6/19/2012 By: [Signature]

Township 32 S Range 9 W Sec. 2

County DOUGLAS This survey consists of:

State OREGON Date 3/28/2011

No. 540700

Corner Rpt: CS 67/36-12

Corner Designation

1/4 52 (ONLY)

DOUGLAS COUNTY

- Condition Report Only
- Not Found
- Renewed
- Unrecorded
- Surveyed In
- Referenced Out

Previous Renewals

MONUMENT DETAIL

Monument(s) Found: (Condition and Source)

FOUND FROM 1916-1917 SURVEY A
 2 3/8 INCH DIAMETER BRASS CAP (MARKED AS
 AT RIGHT) ON A 3/4 INCH I.D. IRON PIPE
 FIRMLY SET AND PROTRUDING APPROX.
 1 FOOT ABOVE GROUND.

US GENERAL LAND OFFICE SURVEY

BC LIES N89 1/2 W, 34° (1916 RECORD N89 1/2 W 35° FT)
 FROM A.P. ON NORTH BOUNDARY OF SEC. 2, T32-9; I.E.
 THE CENTER OF THE FIR ORIGINALLY ESTABLISHED AS THE
 QUARTER CORNER IN 1883.

1/4 52
1917

Accessories Found:

FROM THE ORIGINAL 1916-1917 B.C. MONUMENT.
 FOUND 30 INCH FIR NOW 72 INCH D.B.H. DOUGLAS FIR WITH LOW FULLY HEALED
 SINGLE BLAZE; BEARS S. 24° E, 41 1/2 FEET DISTANT (AS PER RECORD).
 A 30 INCH FIR NOW 37 INCH FIR D.B.H. DOUGLAS FIR WITH A HIGH FULLY HEALED
 SINGLE BLAZE; BEARS S. 55° W., 5 1/2 FEET DISTANT (AS PER RECORD)

RENEWAL

Monument Set (Procedure and Description)

Monument Detail


N/A

N/A

New Accessories

AN 11 INCH D.B.H. CHINQUAPIN SCRIBED "1/4 S 2 CS" "BT" ON A DOUBLE BLAZE; BEARS S. 10 1/2° E., 20± FEET DISTANT

Sketch of Monument, Accessories, and General Area

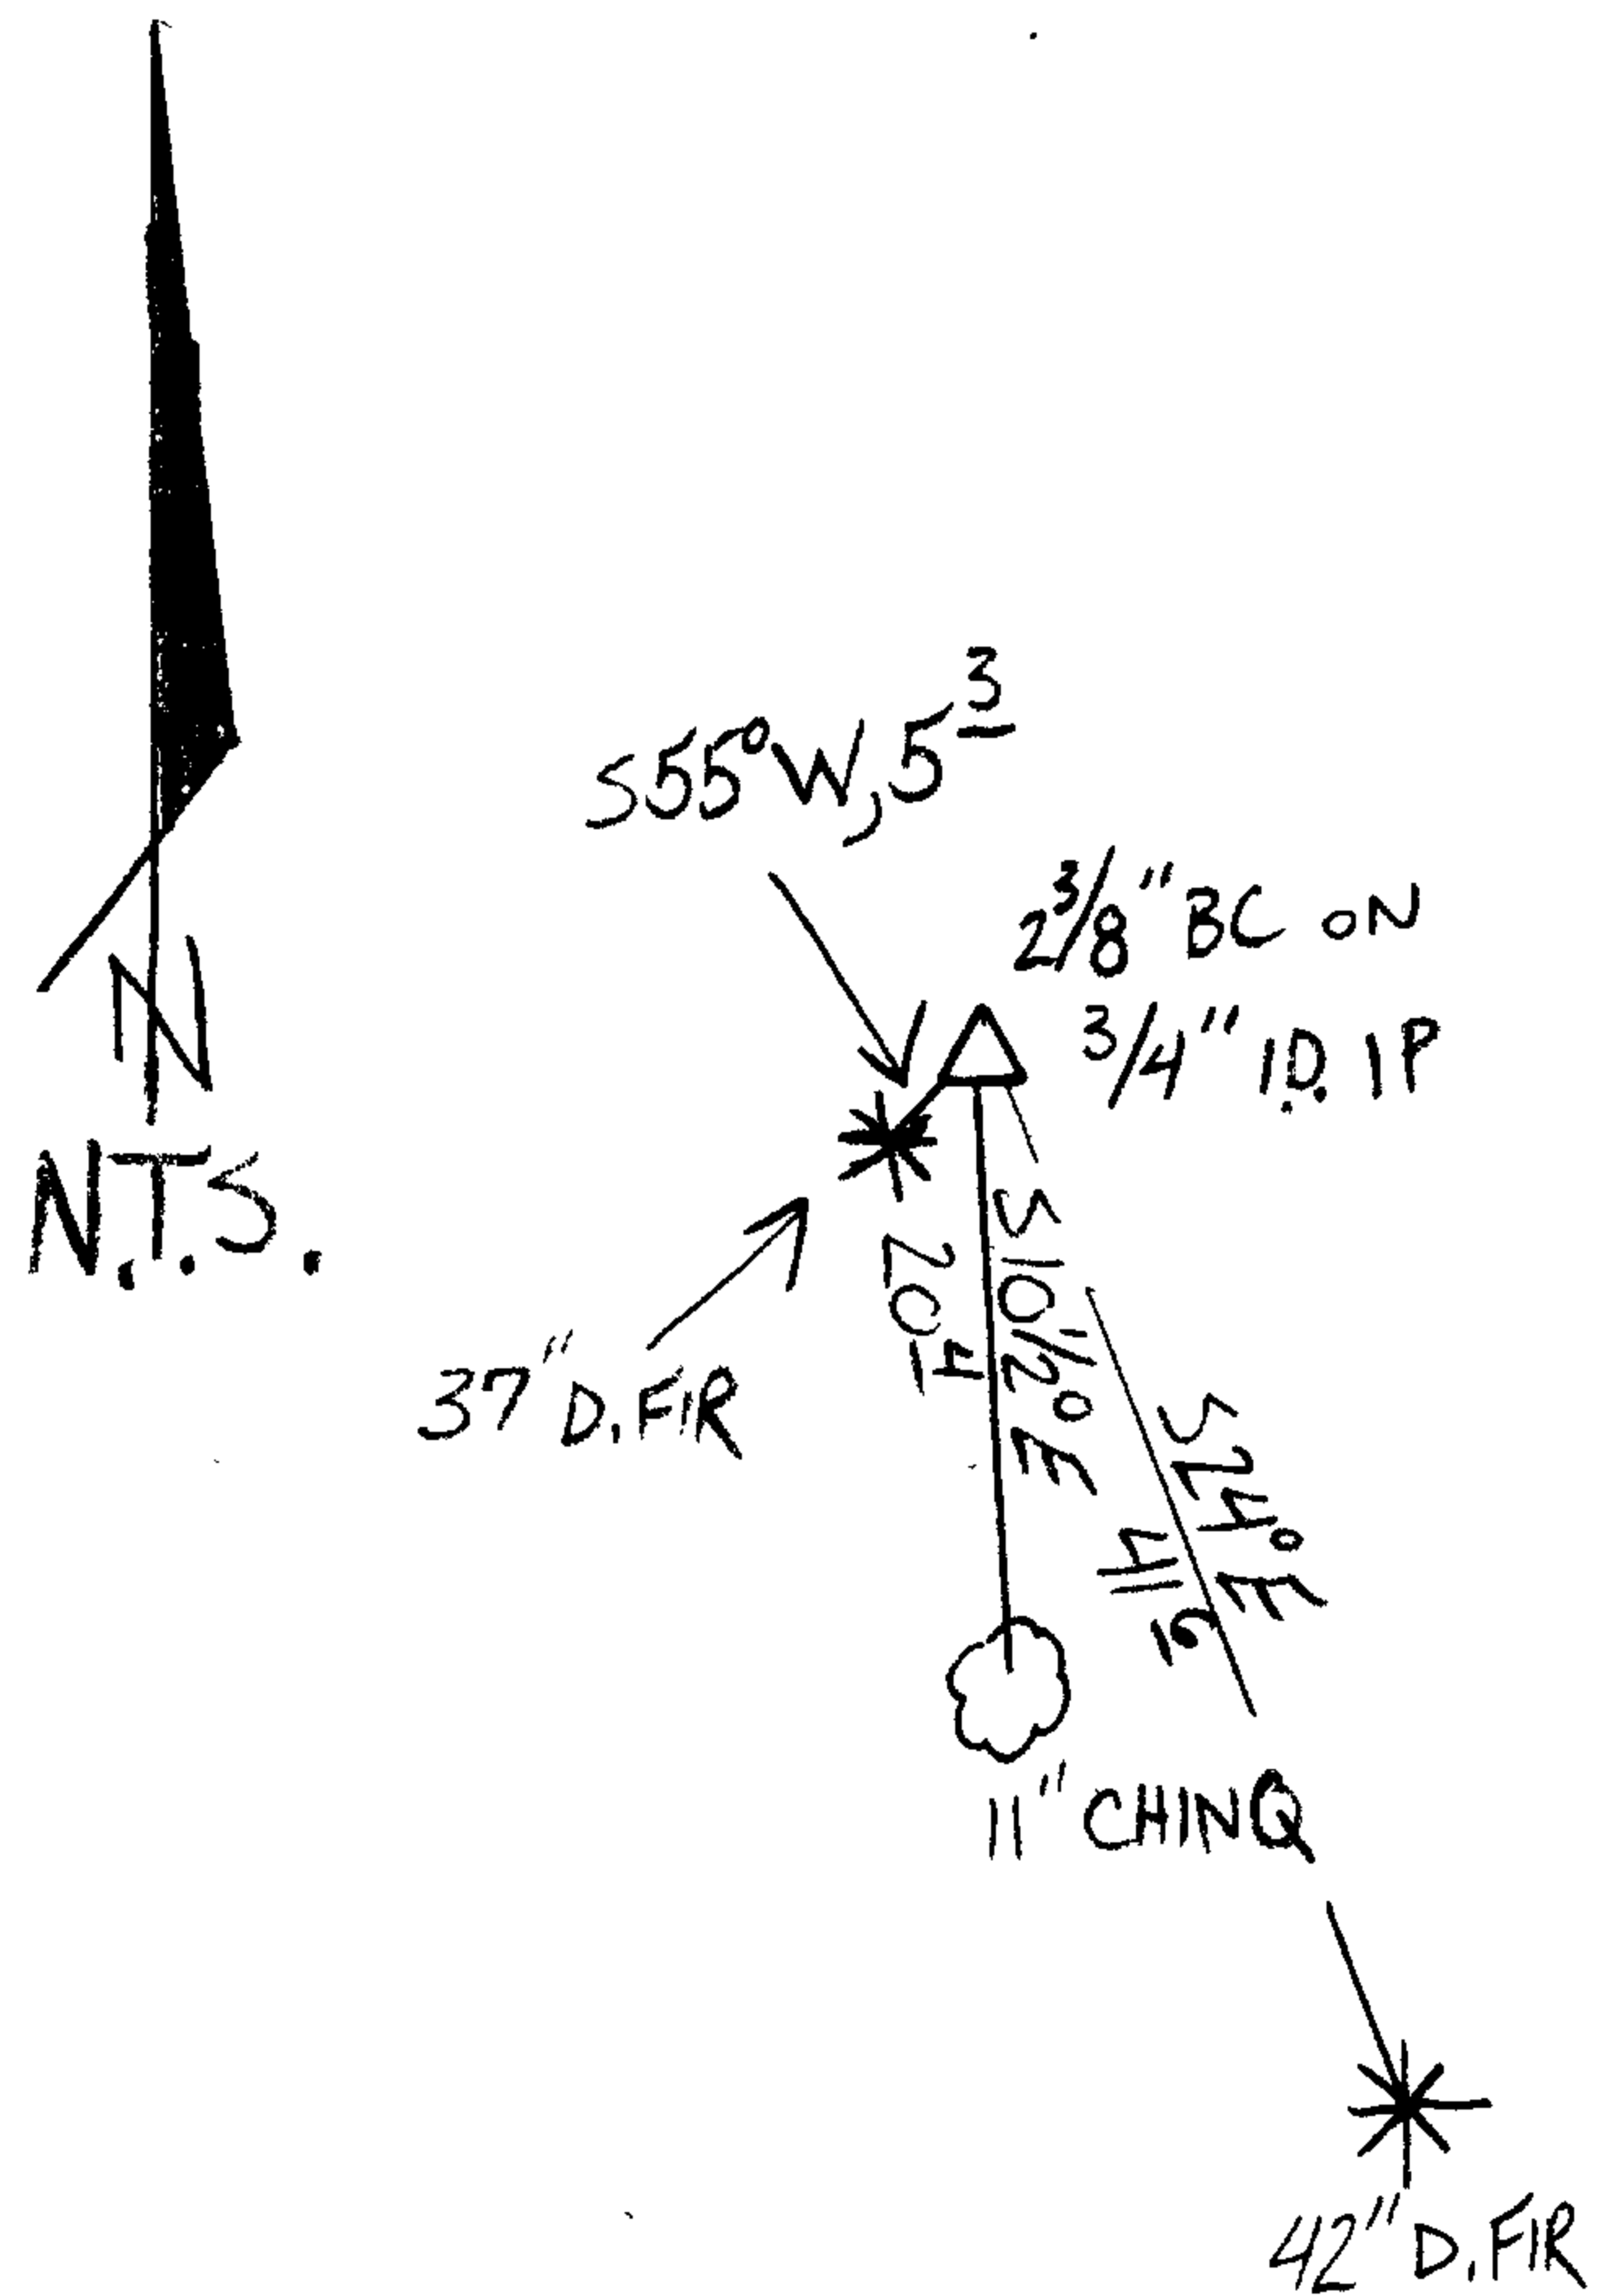

Location & Comments

MONUMENT IS ON A STEEP HILLSIDE AND OLD CLEAR CUT WITH MIX REGROWTH OF OAK AND FIR TO THE NORTH AND AN OLD GROWTH STAND OF FIR AND MIXED HARDWOOD TO THE SOUTH

Comp. Declin. 16° E
Agency DCSO
Party Chief STEPHEN JOHN FLAUSE
Notekeeper Michael S. Koch
Witnesses MIKE S. KOCH, GARRETT A. MCGRAW

Address

Surveyor's Seal
REGISTERED
PROFESSIONAL
LAND SURVEYOR

Randall W. Smith
RENEWAL 6-30-2014

OREGON
JULY 25, 1990
RANDALL W. SMITH
2460