

GOVERNMENT CORNER RESTORATION FORM

Date: 7/31/2012 By: JC

Township 31S Range 4W Sec. 10

County DOUGLAS This survey consists of:

State OR

Date 7-31-2012

No. 44050

Corner Rpt: CS 67/36-20

Corner Designation

$\frac{1}{4}$ $\frac{S10}{S15}$

DOUGLAS COUNTY SURVEYOR

- Condition Report Only
- Not Found
- Renewed
- Unrecorded
- Surveyed In
- Referenced Out

Previous Renewals 1959

MONUMENT DETAIL

Monument(s) Found: (Condition and Source)

FD 1/2" IRON BOLT LEANING WESTWARD 2" BELOW GROUND,
12" X 10" X 4" SHALE STONE
NO MARKS FOUND ALONG WESTWARD EDGE OF BOLT.

N/A

Accessories Found:

- ORIG. AND 1959 DISTANCE MEASUREMENTS FOUND TO BE SLOPED
- 7" NOW 30" DIA 2 1/2 FT HIGH D. FIR STUMP WITH A FULLY HEALED SINGLE BLAZE BEARS N18 1/2° E, 26.0 FT (N17° E 27.0 FT) OBT
 - 14" NOW 24" DIA. 2 FT HIGH D. FIR STUMP WITH A FULLY HEALED DOUBLE BLAZE BEARS S81° W, 26.6 FT (S82° W, 30.2 FT) OBT
 - 20" NOW 21" DIA 4 FT HIGH D. FIR STUMP WITH A ROTTED BLAZE, BEARS S100° W, 59.2 FT (S10° W 60.0 FT) 1959
 - 8" NOW 10" DIA 3 FT HIGH BROKEN MADRONE STUMP WITH A ROTTED SINGLE BLAZE, BEARS N51° W, 21.6 FT (N55° W, 23.5 FT) 1959
 - 7" NOW 12" DIA, STANDING PARTIALLY ALIVE MADRONE WITH A ROTTED BLAZE, BEARS N44° W, 37.2 FT (N45° W, 40.6 FT) 1959
 - 5" NOW YOUNG MADRONE'S GROWING FROM ROOTCROWN FOUND NEAR RECORD (N9° E, 29.3 FT) 1959

RENEWAL

Monument Set (Procedure and Description)

SET 2 1/2" DIA BRASS CAP ON A
 1 1/2" BY 32" LONG IRON PIPE IS
 SET AT PLUMB POSITION OF FOUND
 1959 BOLT. PROTRUDES 4" OUT OF
 GROUND. 1959 BOLT MEASURED 18 1/2"
 LONG IS SET ALONG NORTH EDGE
 OF BC/IP, STONE PLACED ALONG
 WESTERLY EDGE OF BC/IP.


Monument Detail

DOUGLAS COUNTY SURVEYORS
 T 315
 1/4 S10 R
 S15 4
 W
 2012
 OFFICE

New Accessories

- 15" DIA. D.FIR DOUBLE BLAZED AND SCRIBED "Y4 S15 CS BT"
 BEARS S 13° W 13.6 FT
- 8" DIA D.FIR DOUBLE BLAZED AND SCRIBED "Y4 S10 CS BT"
 BEARS N 21° W 6.9 FT
- 7" DIA D.FIR DOUBLE BLAZED AND SCRIBED "Y4 S15 CS BT"
 BEARS N 51° E 8.5 FT
- 7" DIA. D.FIR DOUBLE BLAZED AND SCRIBED "Y4 S10 CS BT"
 BEARS S 54 1/2° E 29.5 FT

Sketch of Monument, Accessories, and General Area

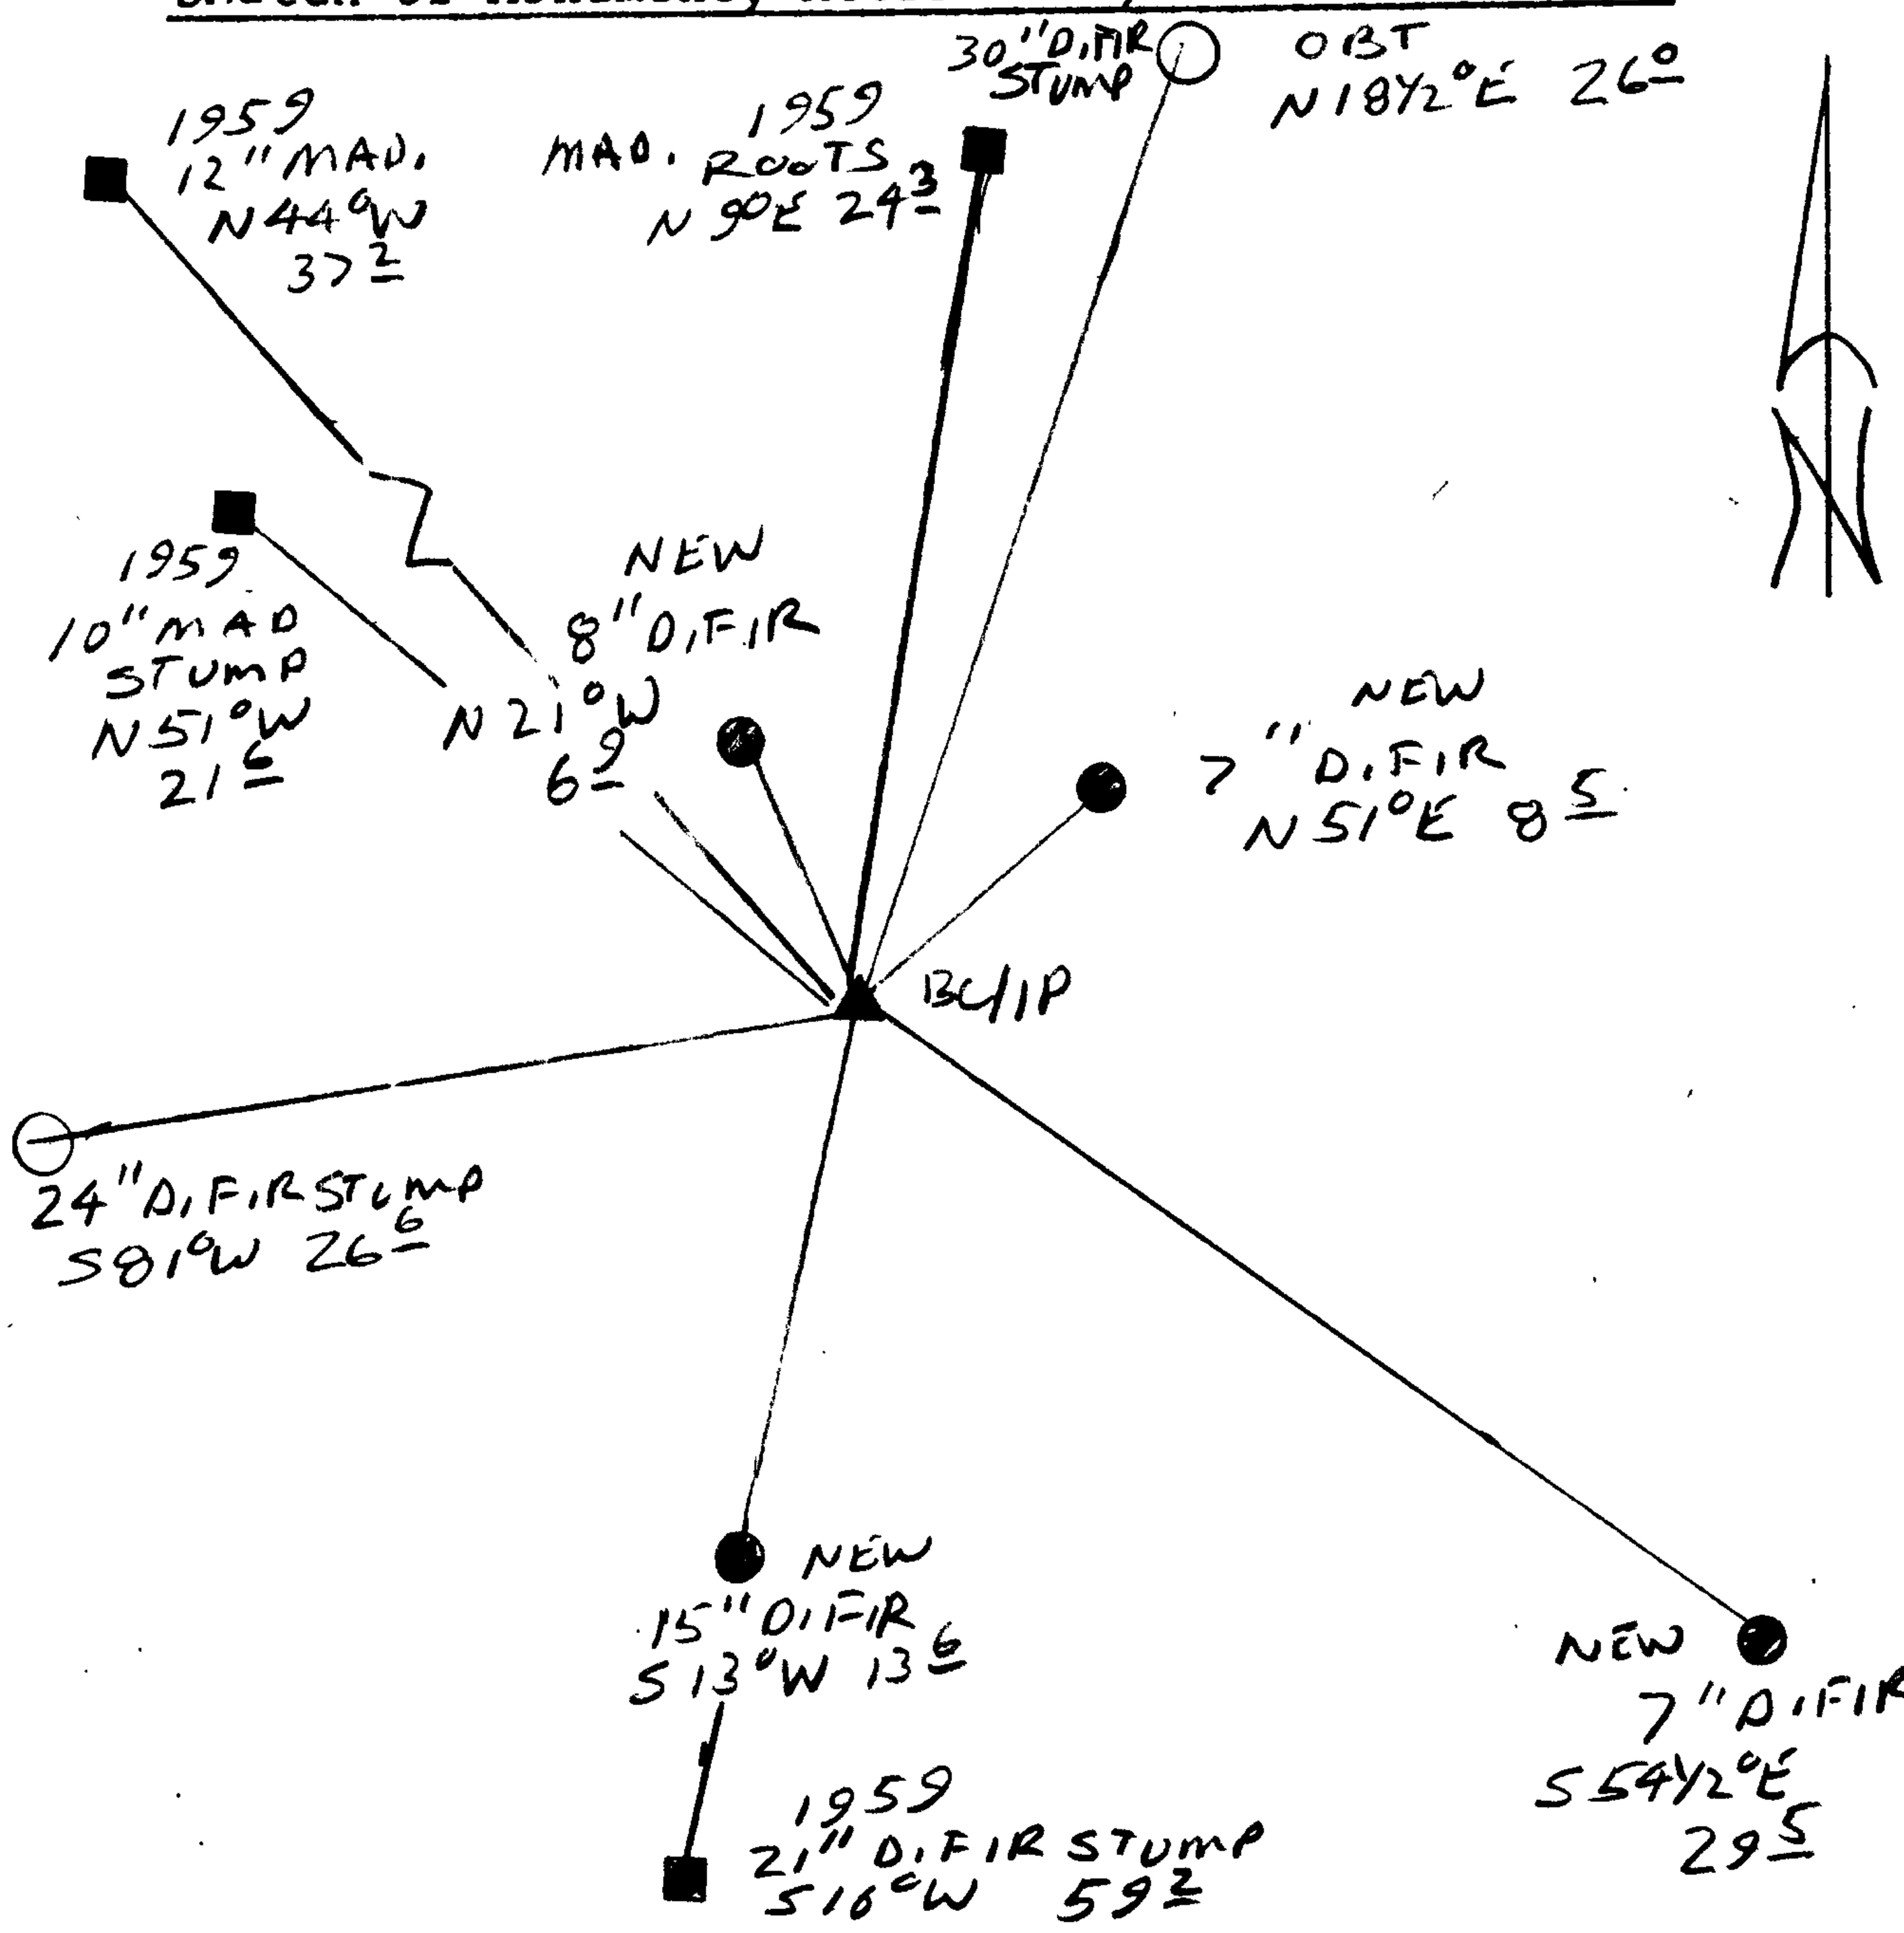

Location & Comments

ON STEEP SW'y SLOPE
 APPROX 165 WEST OF A
 RIDGE

Comp. Declin. 15 1/2° E
 Agency NCSO
 Party Chief RANDALL W SMITH
 Notekeeper
 Witnesses STEPHEN J FLAUST

Address

Surveyor's Seal

2008
 RANDALL W. SMITH
 JULY 25, 1980
 OREGON

6-30-2013
 [Signature]
 REGISTERED
 PROFESSIONAL
 LAND SURVEYOR