

GOVERNMENT CORNER RESTORATION FORM

Date: 10-1-2012 By: JC

Township 30S Range 5W Sec. 22

County DOUGLAS This survey consists of:

State OREGON Date SEPT. 10, 2012

Map: \_\_\_\_\_  
No. 048010 AND Narrative: \_\_\_\_\_  
049040 Corner Rpt: 67/36-22

Corner Designation

INT SW  
DLC 49  
NE  
DLC 48

DOUGLAS COUNTY

- Condition: SURVEYOR Only
- Not Found
- Renewed
- Unrecorded
- Surveyed In
- Referenced Out

Previous Renewals 1891, 1954

MONUMENT DETAIL

Monument(s) Found: (Condition and Source)

N/A

FROM THE WENDEROTH 1954 RENEWAL  
A 1 INCH I.D. IRON PIPE IS FIRMLY SET  
AND PROTRUDES APPROX. 1 INCH ABOVE  
GROUND.

Accessories Found:

NO EVIDENCE OF THE ORIGINAL B.T.S FOR DLC 48 IS FOUND.  
WENDEROTH'S NORTHWEST BT. IS OPENED TO SEARCH FOR O.B.T. EVIDENCE  
OF D.L.C. 49'S ORIGINAL B.T. BUT NONE IS FOUND.  
~~THERE IS POSSIBLE EVIDENCE OF OAK ROOTS AND A BROT HOLE NEAR THE~~  
~~BEARING TREE POSITION FOR THE INTERIOR SW CORNER FOR DLC 49.~~

THE TWO 1954 WENDEROTH RENEWAL TREES ARE FOUND.  
A 30" B. OAK NOW A 37" DIAMETER BLACK OAK WITH A FULLY HEALED DOUBLE  
BLAZE; BEARS N82°14'W, 348 FEET DISTANT (RECORD N82°12'W, 332 FT.;  
THIS IS A POSSIBLE FACE MEASUREMENT). THIS TREE IS OPENED TO SEARCH FOR  
O.B.T. SCRIBING (SEE ABOVE).  
A 24" B. OAK NOW A 27 INCH DIAMETER BLACK OAK WITH A FULLY HEALED DOUBLE  
BLAZE; BEARS N39°E, 296 FEET DISTANT (AS PER RECORD).

RENEWAL

Monument Set (Procedure and Description)

Monument Detail


WE PERPETUATE WENPEROTHS POSITION AS FOUND. MONUMENT IS FIRMLY SET WE DO NOT DISTURB.

N/A

New Accessories

A 14 INCH DIAMETER WHITE OAK SCRIBED "INTL DLC 49CS" "BT" ON A DOUBLE BLAZE BEARS S 11° E, 52.9 FEET DISTANT.  
 A 38 INCH DIAMETER WHITE OAK SCRIBED "NE DLC 48CS" "BT" ON A DOUBLE BLAZE; BEARS S 12° W, 133.8 FEET DISTANT.

Sketch of Monument, Accessories, and General Area

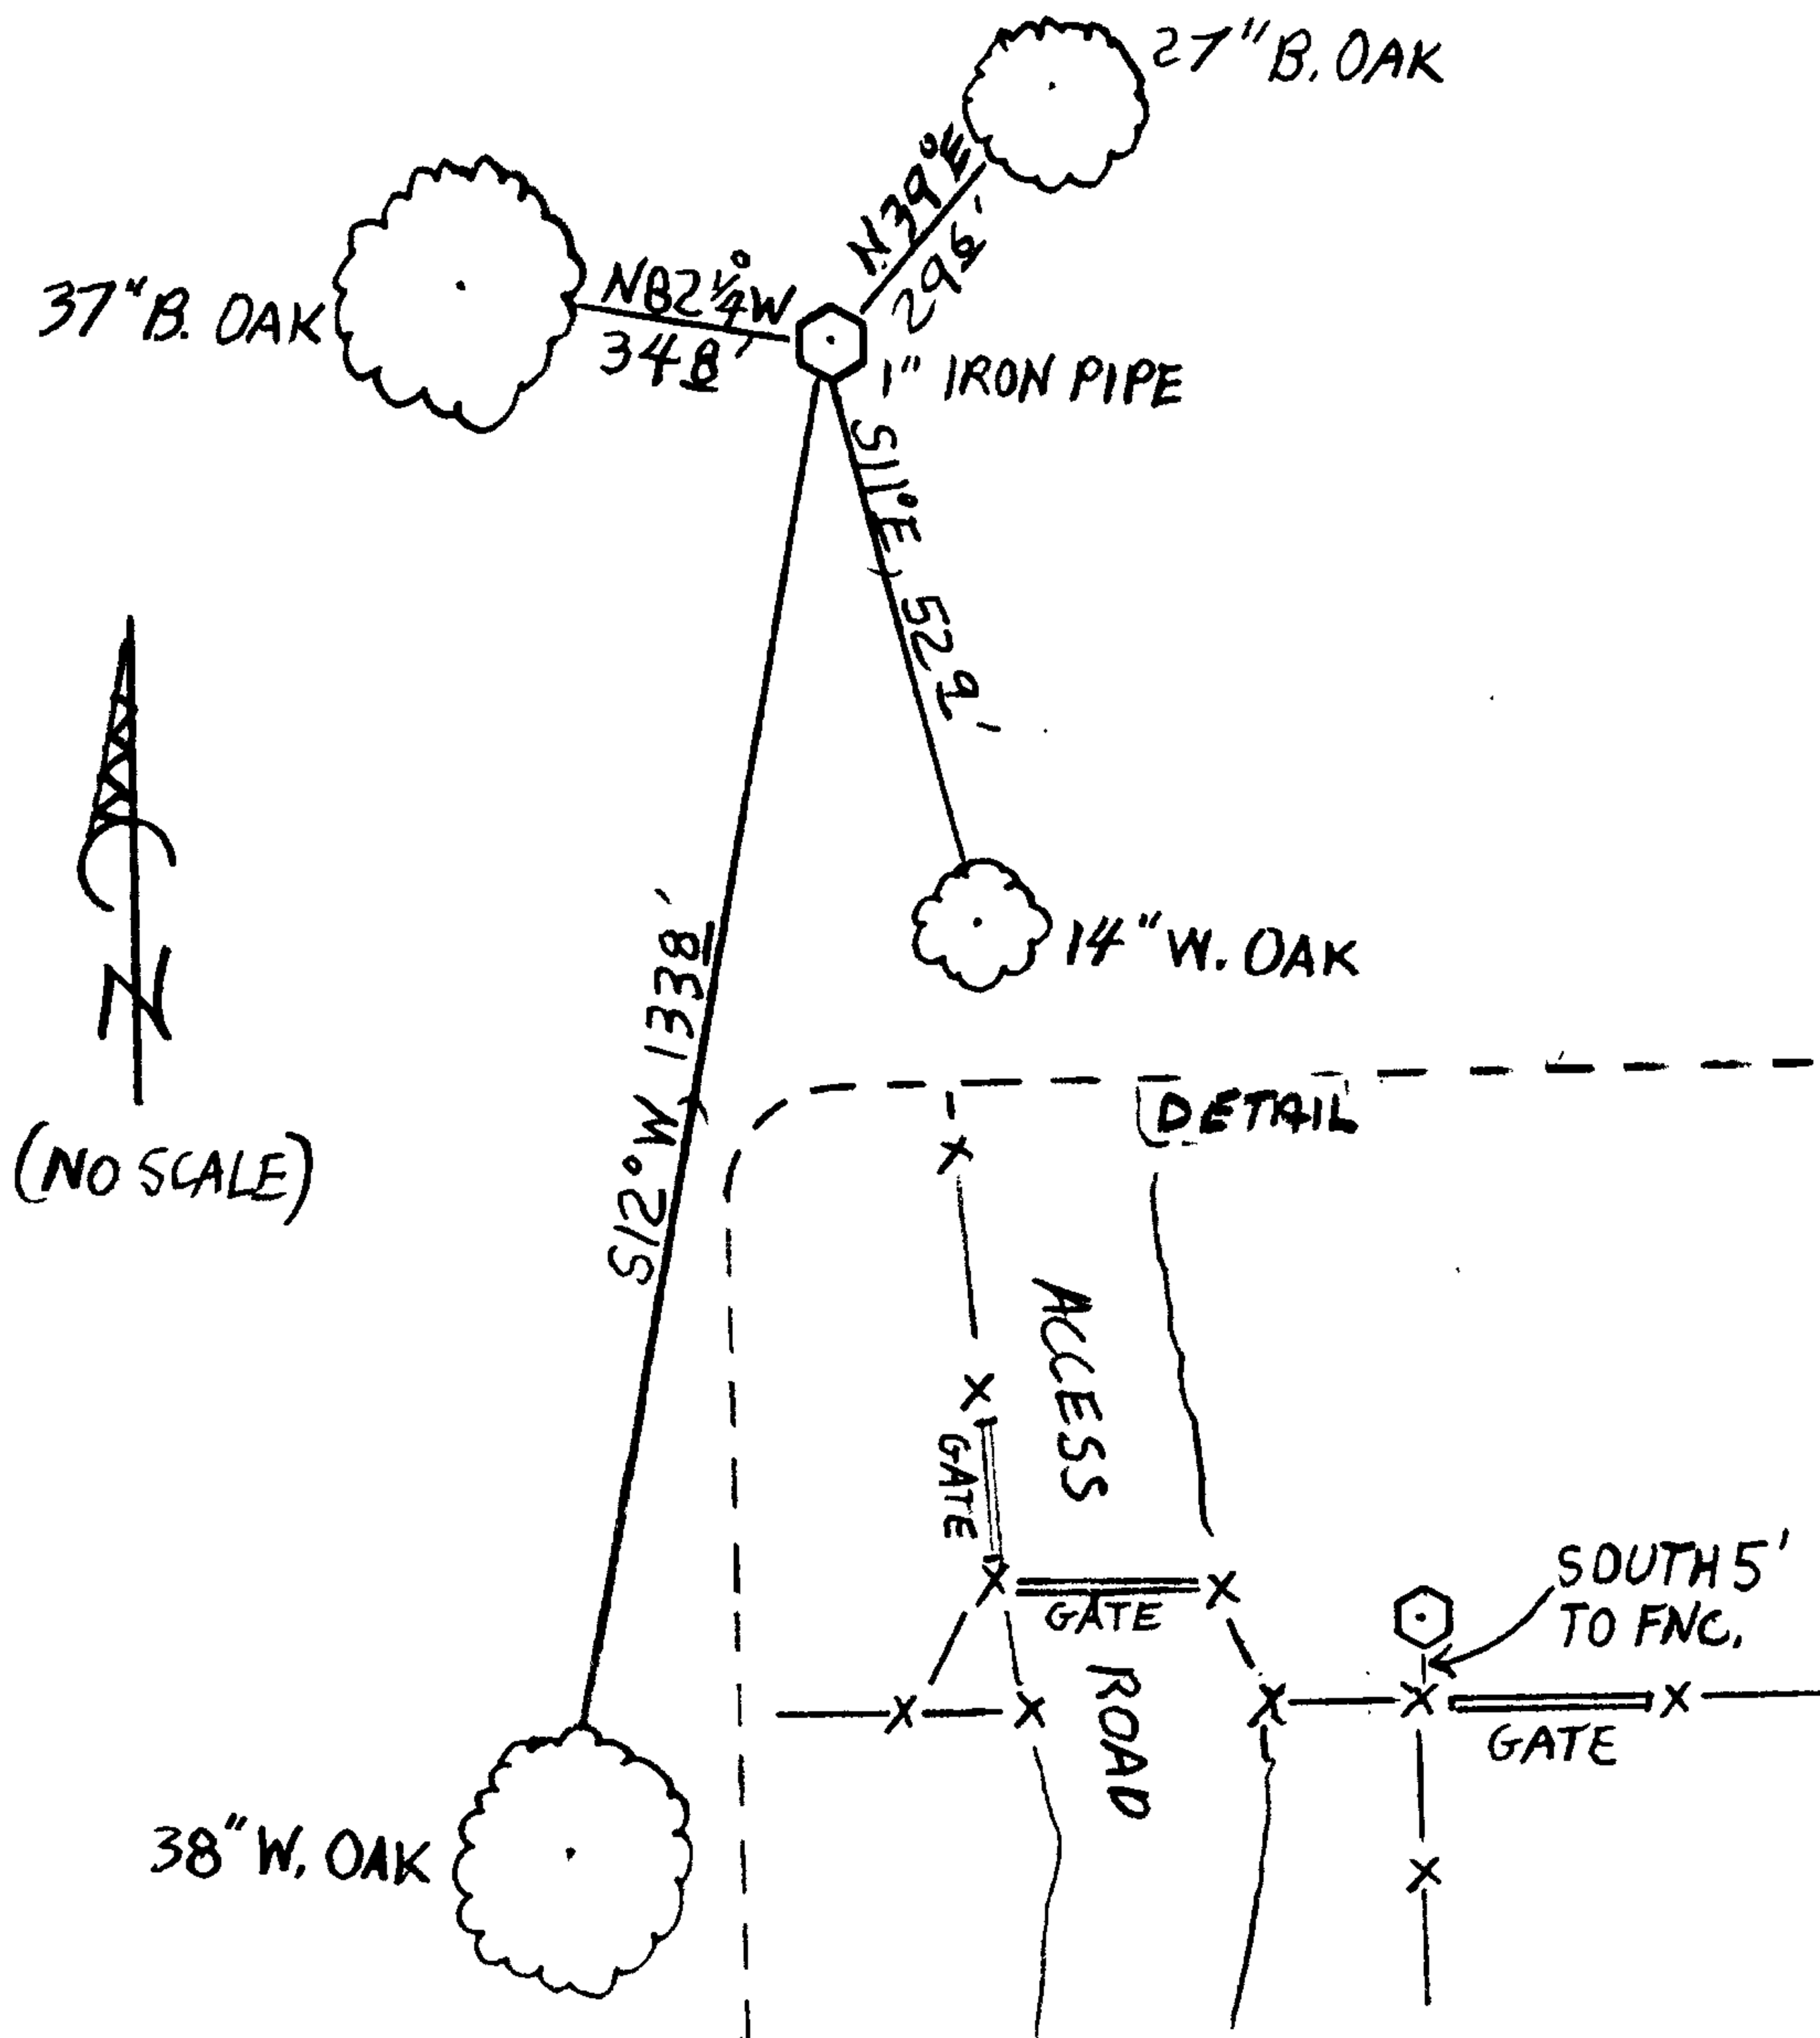

Location & Comments

MONUMENT IS ON OPEN PASTURE LAND WITH SPARSE OAKS AND MADRONES. LAND SLOPES GENTLY SOUTH.

Comp. Declin. 15 1/2° E  
 Agency DCSD  
 Party Chief STEPHEN JOHN FLAUSE  
 Notekeeper Stephen John Flause  
 Witnesses MIKE S. KOCH

Address

Surveyor's Seal

REGISTERED PROFESSIONAL LAND SURVEYOR

*Renewal*  
 6-30-2013

OREGON  
 JULY 25, 1990  
 RANDALL W. SMITH  
 2489