

FILED

GOVERNMENT CORNER RESTORATION FORM

Date: 11/5/2012 By: JC

Township 30S Range 05W Sec. 27

County DOUGLAS

This survey consists of:

State OREGON

Date OCT. 25, 2012

No. 051050

Narrative: _____
Corner Rpt: CS67/36-32

Corner Designation

INT, SE
KLC
51

DOUGLAS COUNTY SURVEYOR

- Condition Report Only
- Not Found
- Renewed
- Unrecorded
- Surveyed In
- Referenced Out

MONUMENT DETAIL

Previous Renewals 1949

Monument(s) Found: (Condition and Source)

FROM THE 1949 RENEWAL A 1 1/2 INCH I.D. IRON PIPE FIRMLY SET AND LEANING VERY SLIGHTLY SWEELY PROTRUDES 3 INCHES ABOVE GROUND.

N/A

Accessories Found:

EVIDENCE OF THE ONE D.B.T. FOUND. A FALLEN AND MOSTLY ROTTED AWAY MADRONE THE ROOT-HOLE OF WHICH BEARS N40°W, 59 1/2 FEET DISTANT (AS PER RECORD).

EVIDENCE OF TWO 1949 RENEWAL BEARING TREES FOUND.
A 18" W. OAK NOW A 9 INCH DIAMETER WHITE OAK WITH A FULLY HEALED DOUBLE BLAZE; BEARS S52 1/2°E, 27 1/2 FEET DISTANT (RECORD S50 1/2°E, 27 1/2 FEET).
A 10" W. OAK NOW AN 11 INCH DIAMETER FALLEN AND OUT OF POSITION OAK (NO BLAZE EVIDENT PROBABLY ON UNDERSIDE OF TRUNK) THE ROOT-HOLE OF WHICH BEARS S30°W, 36 1/2 FEET DISTANT (AS PER RECORD).

C.S. File No 67/36-32

RENEWAL

Monument Set (Procedure and Description)

Monument Detail

N/A

N/A


New Accessories

A 6 INCH DIAMETER WHITE OAK SCRIBED "X" "CSBT" ON A HIGH-LOW DOUBLE BLAZE; BEARS N79 1/4° E, 10° FEET DISTANT.

A 5/8 INCH DIAMETER IRON ROD WITH A PLS BAUGHMAN PLASTIC CAP SET PROTRUDING 4 INCHES ABOVE GROUND; BEARS SOUTH, 7 1/2 FEET DISTANT (AS PER DCSDO FILE PART, 1993-30).

AN 8 INCH DIAMETER PONDEROSA PINE SCRIBED "INT L DLC 5165" "BT" ON A DOUBLE BLAZE; BEARS S68° W, 18 1/2 FEET DISTANT.

Sketch of Monument, Accessories, and General Area

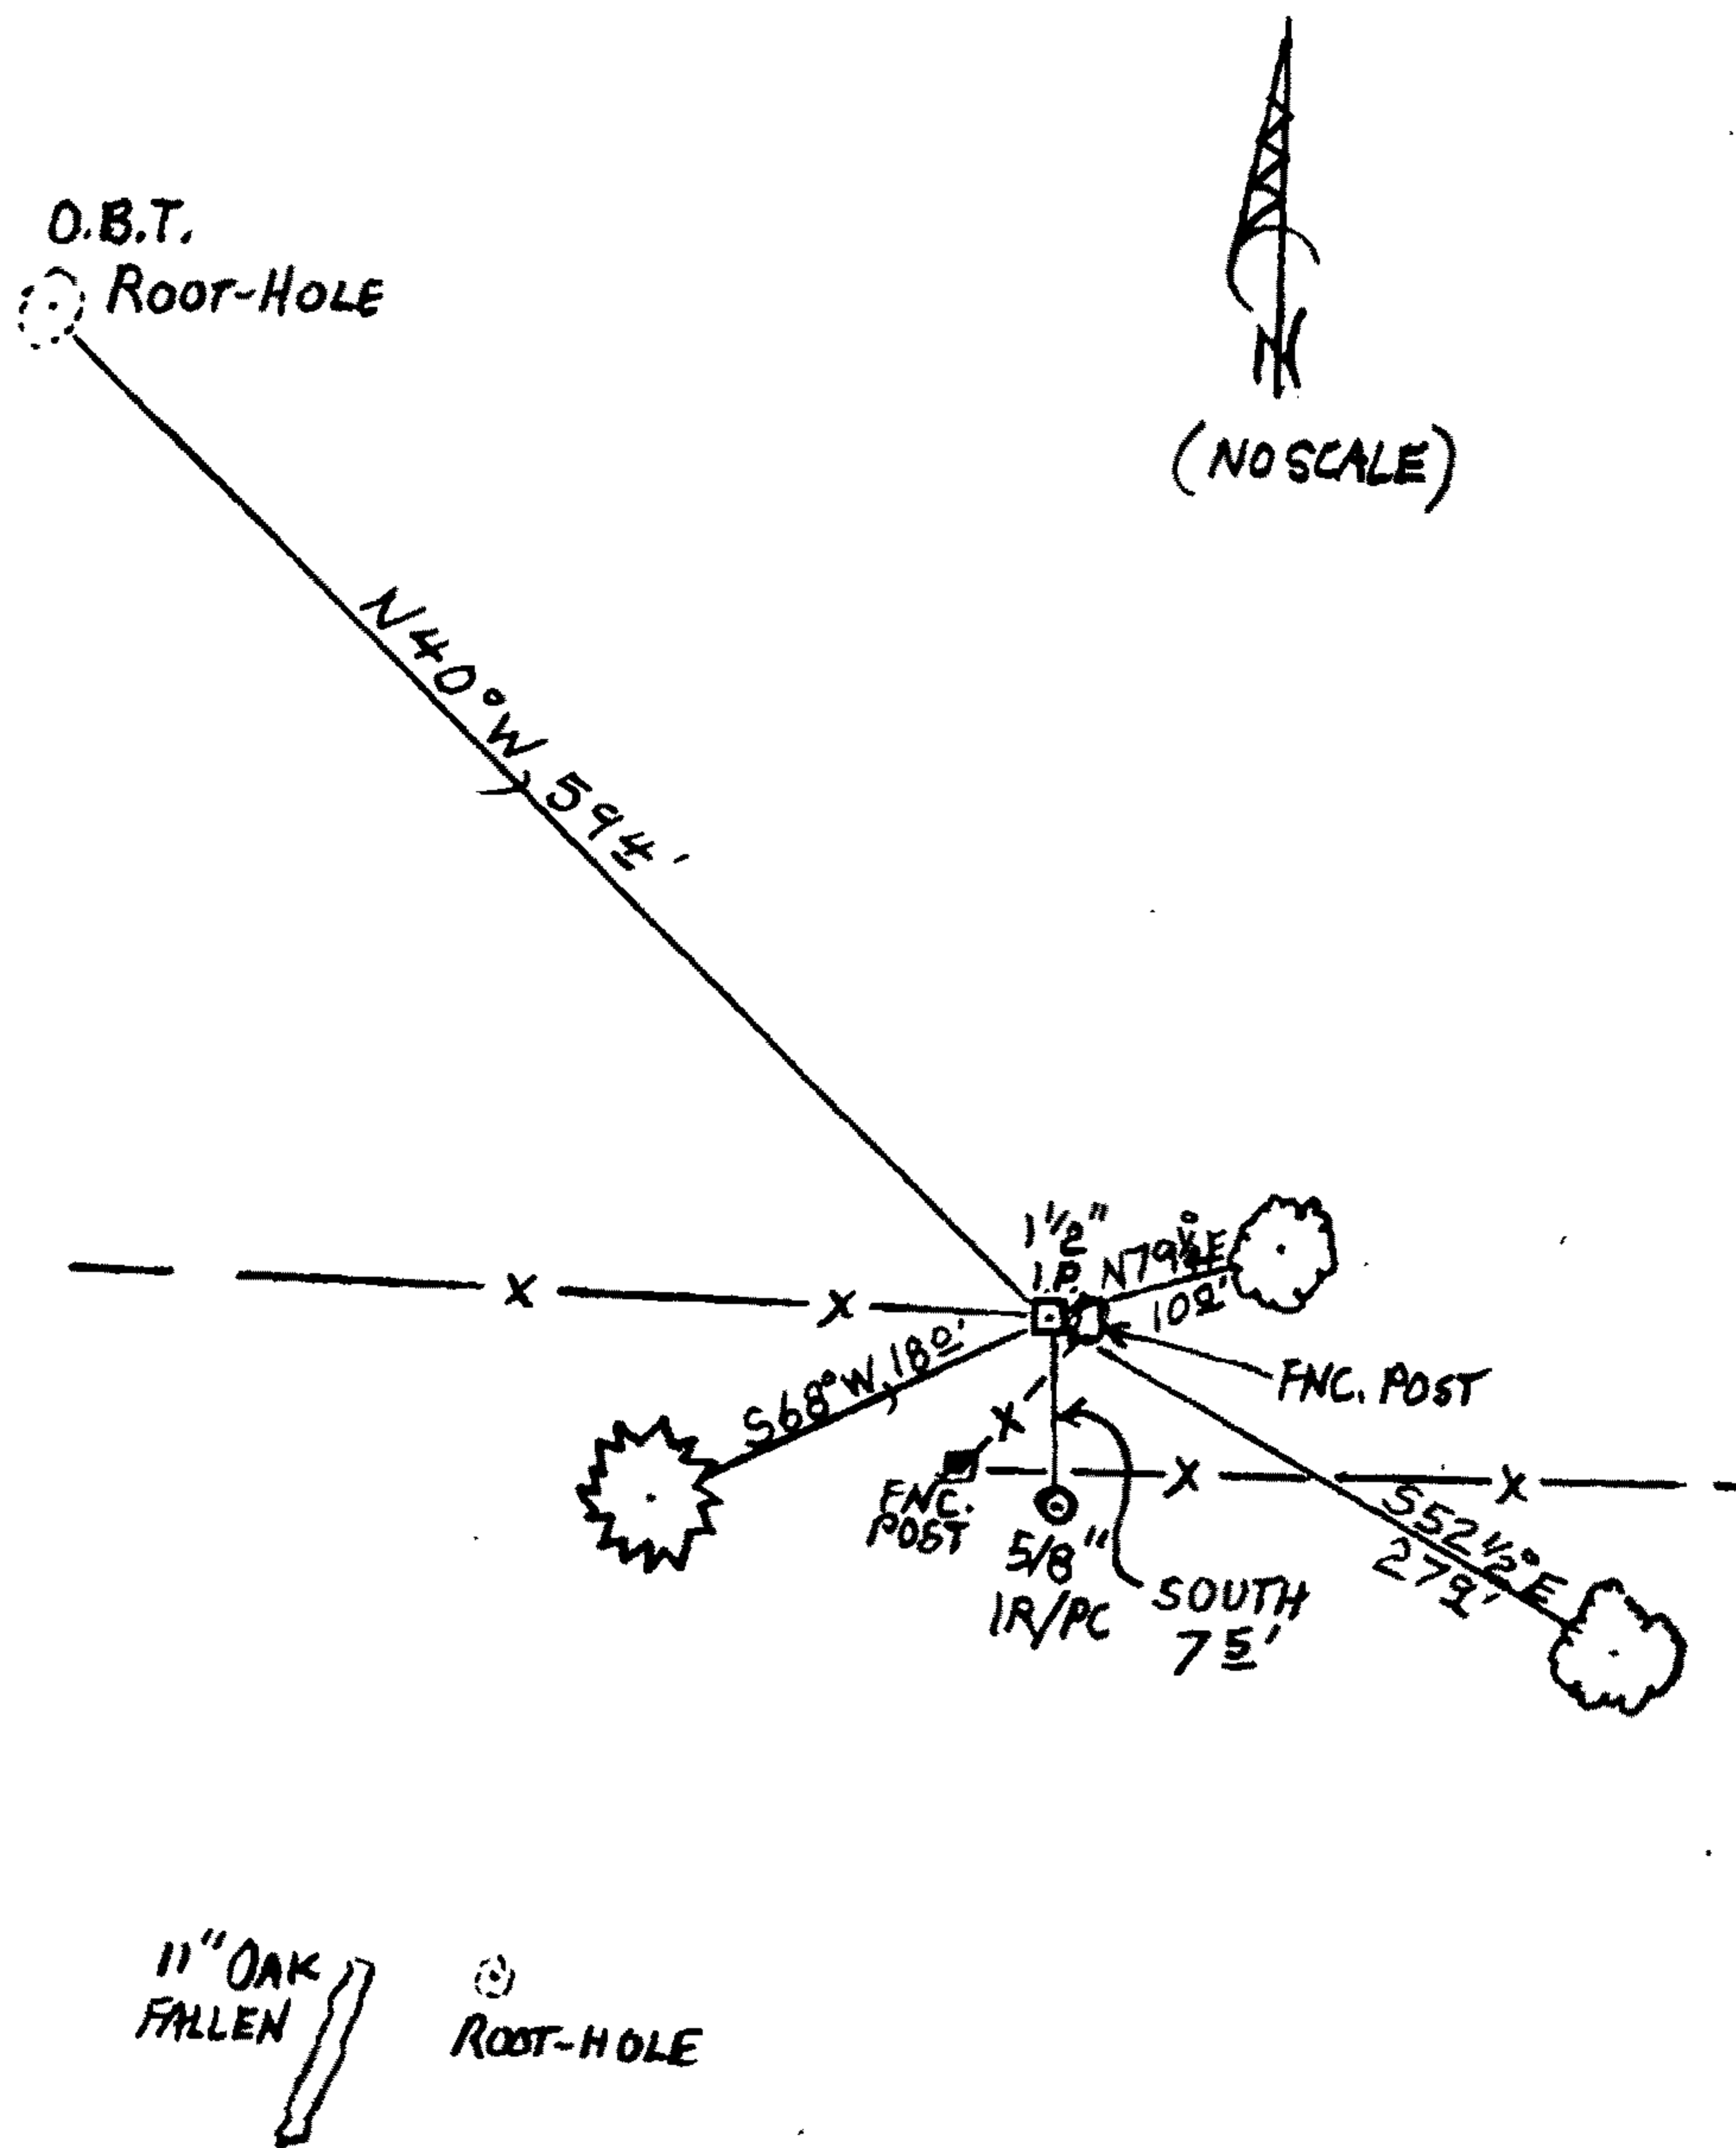

Location & Comments

CORNER IS ON STEEP NW SLOPE IN MIXED FOREST OF OAK, MADRONE, PINE AND FIR.

Comp. Declin. 15 1/2° E

Agency DCSDO

Party Chief STEPHEN JOHN FLAUSE

Notekeeper Stephen John Flause

Witnesses MIKE S. KOCH

Address

Surveyor's Seal

REGISTERED PROFESSIONAL LAND SURVEYOR

Randall W. Smith
LONDON 6-30-2013

OREGON
JULY 25, 1990
RANDALL W. SMITH
2488