

**FILED**

GOVERNMENT CORNER RESTORATION FORM

Date: 11/15/2012 By: X

This survey consists of:

Township 30S Range 05W Sec. 23

County DOUGLAS Map: \_\_\_\_\_

State OREGON Date SEPT 13, 2012

No. 052050 Narrative: \_\_\_\_\_

Corner Rpt: CS 67/36-35

Corner Designation

**DOUGLAS COUNTY**

NNE  
DLC 52

- Condition Report Only
- Not Found
- Renewed
- Unrecorded
- Surveyed In
- Referenced Out

MONUMENT DETAIL

Previous Renewals 1923, 2005

Monument(s) Found: (Condition and Source)

N/A

FOUND AS DESCRIBED IN 2005 RENEWAL.

Accessories Found:

FOUND AS DESCRIBED IN 2005

RENEWAL

Monument Set (Procedure and Description)

Monument Detail

N/A

N/A

New Accessories

FOUND ACCESSORIES ARE RETAGGED AND FLAGGED AS NEEDED.

Sketch of Monument, Accessories, and General Area


Location & Comments

N/A

N/A

Comp. Declin. 15 1/2° E  
Agency DCSD  
Party Chief STEPHEN JOHN FLAUSE  
Notekeeper Stephen John Flause  
Witnesses MIKE S. KOCH

Address

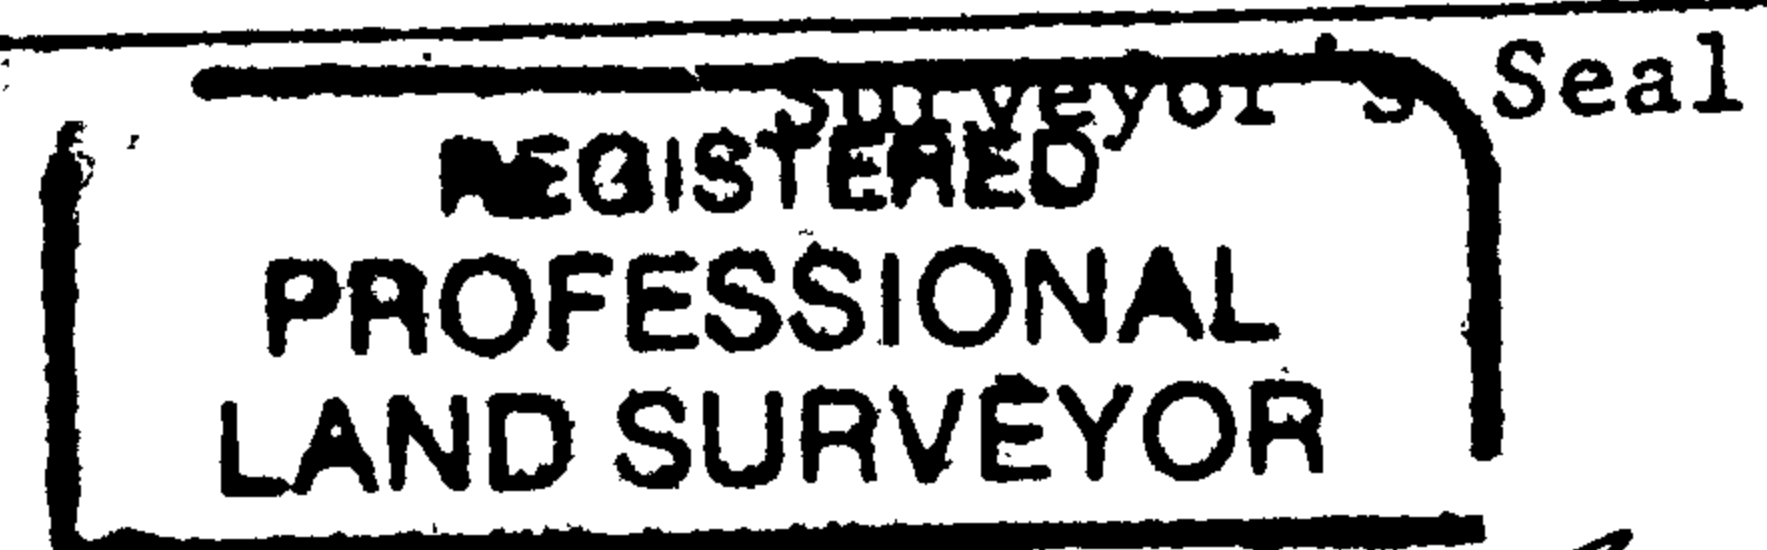

*Handwritten signature*  
RENEWAL 6-30-2013

