

GOVERNMENT CORNER RESTORATION FORM

FILED

TOWNSHIP 30S RANGE 5W SEC. 2 PLSS # 050040

Date: 2-13-2013 By: SC

This survey consists of:

DOUGLAS COUNTY OREGON

DATE JAN. 18, 2013

Map: _____

Narrative: _____

Corner Rpt: CS 67/38-9

Corner Designation

DOUGLAS COUNTY SURVEYOR

SE
DLC 50

- _____ Condition Report
- _____ Not Found
- Renewed
- _____ Unrecorded
- _____ Surveyed In
- _____ Referenced Out

Previous Renewals 1892, 1920, 1955, 1966

Monument(s) Found: (Condition and Source)

NO EVIDENCE OF 1920 STONE OR 1955 I.P. FOUND.

FROM THE 1966 RENEWAL

A 2 1/2 INCH DIAMETER BRASS CAP (MARKED AS AT RIGHT) IS FIRMLY AND PLUMBLY SET PROTRUDING 9 INCHES ABOVE GROUND

MONUMENT DETAIL

COUNTY SURVEYORS OFFICE

S. E. COR.



D. L. C. 50

L. S. 5

Accessories Found

EVIDENCE OF THE ORIGINAL BEARING TREE IS FOUND
A B. OAK 10" DIA. NOW A WELL DEFINED ROOT-HOLE WITH ROTTEN OAK REMAINS (TOO LOW FOR BLAZE EVIDENCE) BEARS N27°W, 92 FEET DISTANT (AS PER RECORD).

NO EVIDENCE OF 1892 RENEWAL BEARING TREE REMAINS.

EVIDENCE OF THE TWO 1920 RENEWAL TREES IS FOUND.

A LAUREL 10" DIA. NOW A 17 INCH DIAMETER MADRONE WITH A FULLY HEALED SINGLE BLAZE; BEARS N51°E, 42 FEET DISTANT (RECORD N58°E, 33 FEET IS A REASONABLE FACE MEASUREMENT).

A LAUREL 6" DIA. NOW A 10 INCH DIAMETER MADRONE, NOT SHOWING A VISIBLE BLAZE; BEARS N75°W, 93 FEET DISTANT (BEARING AGREES WITH 1955 RECORD, DISTANCE RECORD MAY BE TO FACE OF TREE)

EVIDENCE OF THE ONE RENEWAL TREE MARKED IN 1955 IS FOUND.

A 10" CEDAR NOW A 21 INCH DIAMETER INCENSE CEDAR WITH A FULLY HEALED DOUBLE BLAZE; BEARS S40 1/2°E, 81 FEET DISTANT (RECORD S36°E, 81 FT.)

PREVIOUSLY NOTED N-S FENCE MOSTLY GONE SOME STANDING FENCE RVNS WEST FROM NE BEARING TREE.

C.S. File 67/38-9

RENEWAL

Monument Set (Procedure and Description)

MONUMENT DETAIL

N/A


NA

New Accessories

AN 11 INCH DIAMETER DOUGLAS FIR SCRIBEN "SE DLC 50CS" "BT" ON A DOUBLE BLAZE; BEARS N38 1/2° W, 21° FEET DISTANT.

Sketch of Monument, Accessories, and General Area

Location & Comments

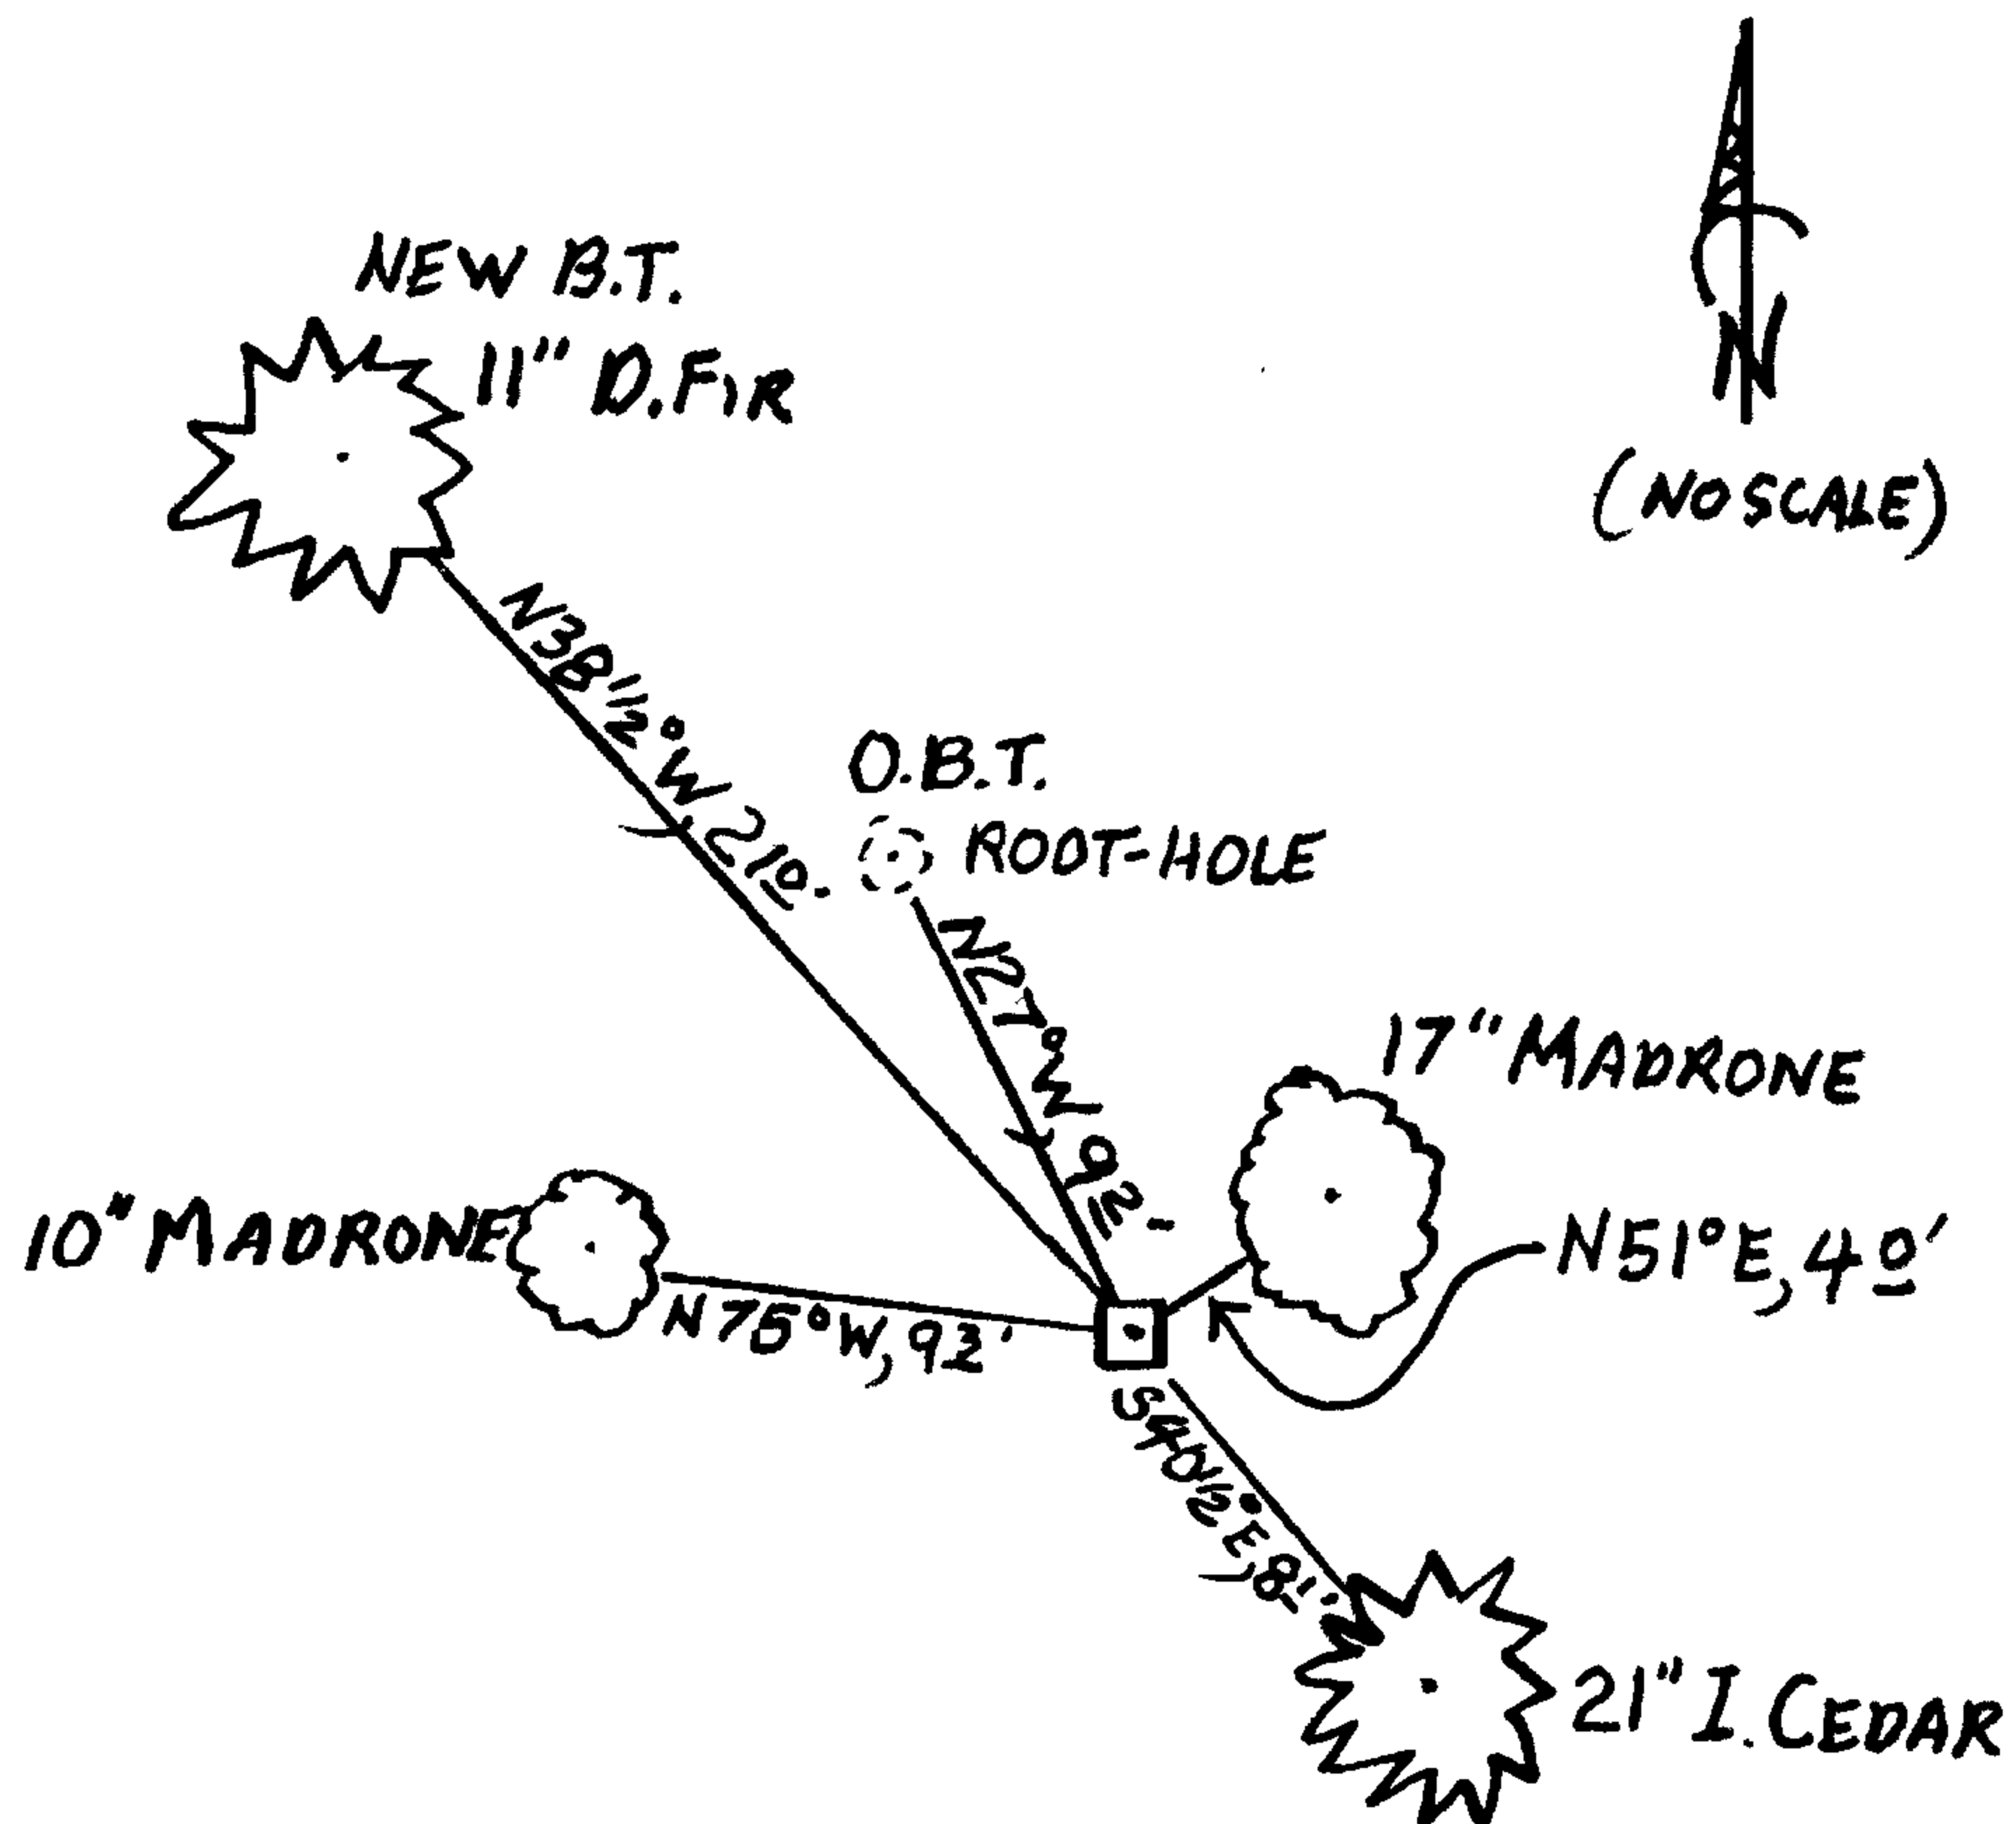

MONUMENT IS ON LAND SLOPING MODERATELY EAST AND SOUTH AND IS JUST EAST AND SOUTH OF A FLAT RIDGETOP. LAND IS FORESTED WITH OAK, MADRONE, FIR AND CEDAR.

Comp. Decline. 15 1/2° E
Agency DCSD
Party Chief STEPHEN JOHN FRAUSE
Note keeper Stephen John Frause
Witnesses MIKE S. KOCH

Surveyor's Seal
REGISTERED PROFESSIONAL LAND SURVEYOR

Handwritten signature

OREGON
JULY 25, 1990
RANDALL W. SMITH
2469

LOWMONT 6-30-14