

GOVERNMENT CORNER RESTORATION FORM

FILED

TOWNSHIP 25S RANGE 05W SEC. 23 PLSS # 540300

Date: 2-21-2013 By: JC
This survey consists of:

DOUGLAS COUNTY OREGON

DATE FEB. 15, 2013

Map: _____

Narrative: _____

Corner Rpt: CS 67/38-15

Corner Designation

DOUGLAS COUNTY
SURVEYOR

1/4 $\frac{523}{526}$

- Condition Report
- Not Found
- Renewed
- Unrecorded
- Surveyed In
- Referenced Out

Previous Renewals 1920, 1960, 1997
Monument(s) Found: _____ (Condition and Source)

MONUMENT DETAIL

AS DESCRIBED

FD BELT SW 1.35' PER M145-30
RECORD, POSSIBLY
SET AT DISTANCE, DISTANCE
INTERSECT FROM 1920 BT'S
(SOURCE UNKNOWN) N/A

Accessories Found

AS DESCRIBED IN 1997 EXCEPT AS FOLLOWS:

S.E. 13 INCH DEAD OAK NOW FALLEN S12°E BRG IS S13°E IN
FB 49 PG 33
N.W. 7 INCH WHITE OAK NOW COMPLETELY MISSING, ROOT-HOLE
AT RECORD BEARING AND DISTANCE.

C.S. File 67/38-15

RENEWAL

Monument Set (Procedure and Description)

N/A

MONUMENT DETAIL

N/A

New Accessories


N/A

Sketch of Monument, Accessories, and General Area


Location & Comments

Comp. Decline. 15' 2" E
Agency DCSO
Party Chief STEPHEN JOHN FLAUS
Note keeper Stephen John Flaus
Witnesses MIKE S. KOCH

Surveyor's Seal

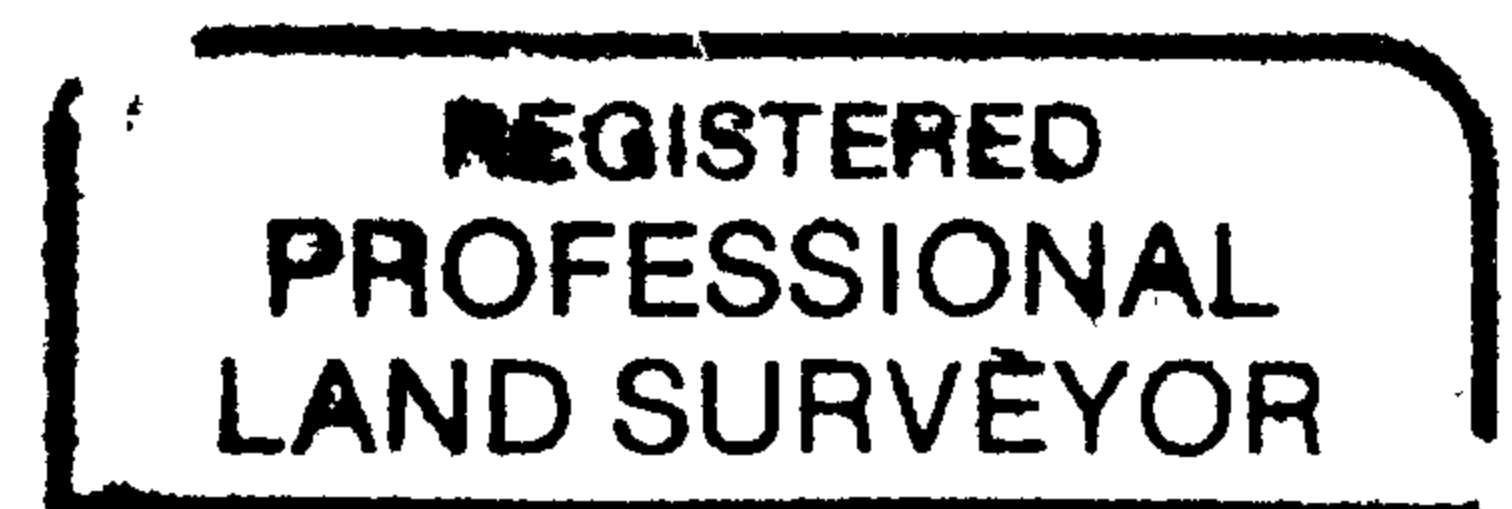

Handwritten signature

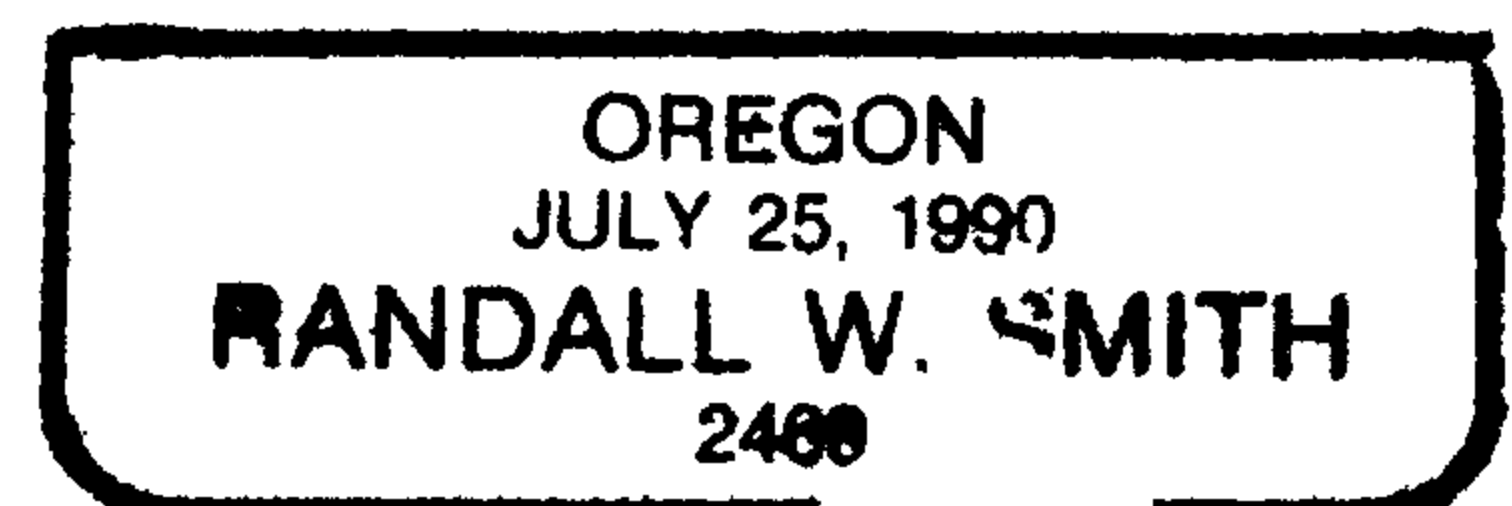

Renewal 6-30-2014