

GOVERNMENT CORNER RESTORATION FORM

FILED

TOWNSHIP 30S RANGE 5W SEC. 14 PLSS # 500440

Date: 3-4-2013 By: JC  
This survey consists of:

DOUGLAS COUNTY OREGON

DATE FEB. 11, 2013

Map: \_\_\_\_\_

Narrative: \_\_\_\_\_

Corner Rpt: CS 67/38-17

Corner Designation

1/4

S15 | S14

DOUGLAS COUNTY  
SURVEYOR

Previous Renewals 1967-69 BLM RESURVEY  
Monument(s) Found: (Condition and Source)

- Condition Report
- Not Found
- Renewed
- Unrecorded
- Surveyed In
- Referenced Out

A 3 1/4 INCH DIAMETER BRASS CAP (MARKED AS AT RIGHT)  
ON A 2 INCH I.D. IRON PIPE IS FIRMLY AND PLUMBLY  
SET, PROTRUDING 6 INCHES ABOVE GROUND.

MONUMENT DETAIL

U.S. DEPT. OF THE INTERIOR

T 30S R 5W

1/4

S15 | S14

1969

BUREAU OF LAND MANAGEMENT

Accessories Found

NO D.B.T.S FOUND. WE OPEN AND INSPECT LARGE MADRONES IN VICINITY BUT FIND NO B.T. EVIDENCE.  
NO LARGE B. OAKS REMAIN.

TWO 1969 B.L.M. RESURVEY BEARING TREES.  
A CEDAR 12" DIA. NOW A 19 INCH DIAMETER INCENSE CEDAR WITH A FULLY HEALED LOW SINGLE BLAZE;  
BEARS N 49 1/2° E, 238 FEET DISTANT (RECORD N 51 1/2° E, 252 FEET).  
A FIR 13" DIA. NOW A 24 INCH DIAMETER DOUGLAS FIR WITH A FULLY HEALED DOUBLE BLAZE; BEARS  
S 58 1/2° W, 21 1/2 FEET DISTANT (RECORD S 60 1/2° W, 21 1/2 FEET).

C.S. File 67/38-17

Monument Set (Procedure and Description)

MONUMENT DETAIL

N/A

N/A


New Accessories

A 18 INCH DIAMETER DOUGLAS FIR SCRIBED "1/4 S14CS" "BT" ON A DOUBLE BLAZE; BEARS S46 1/2° E, 36 1/2 FEET DISTANT (NEARER FIR IN THIS QUADRANT HAS UNSCRIBABLE BASE).

A 16 INCH DIAMETER MADRONE SCRIBED "1/4 S15CS" "BT" ON A DOUBLE BLAZE; BEARS N63 1/2° W, 21 1/2 FEET DISTANT.

Sketch of Monument, Accessories, and General Area


Location & Comments

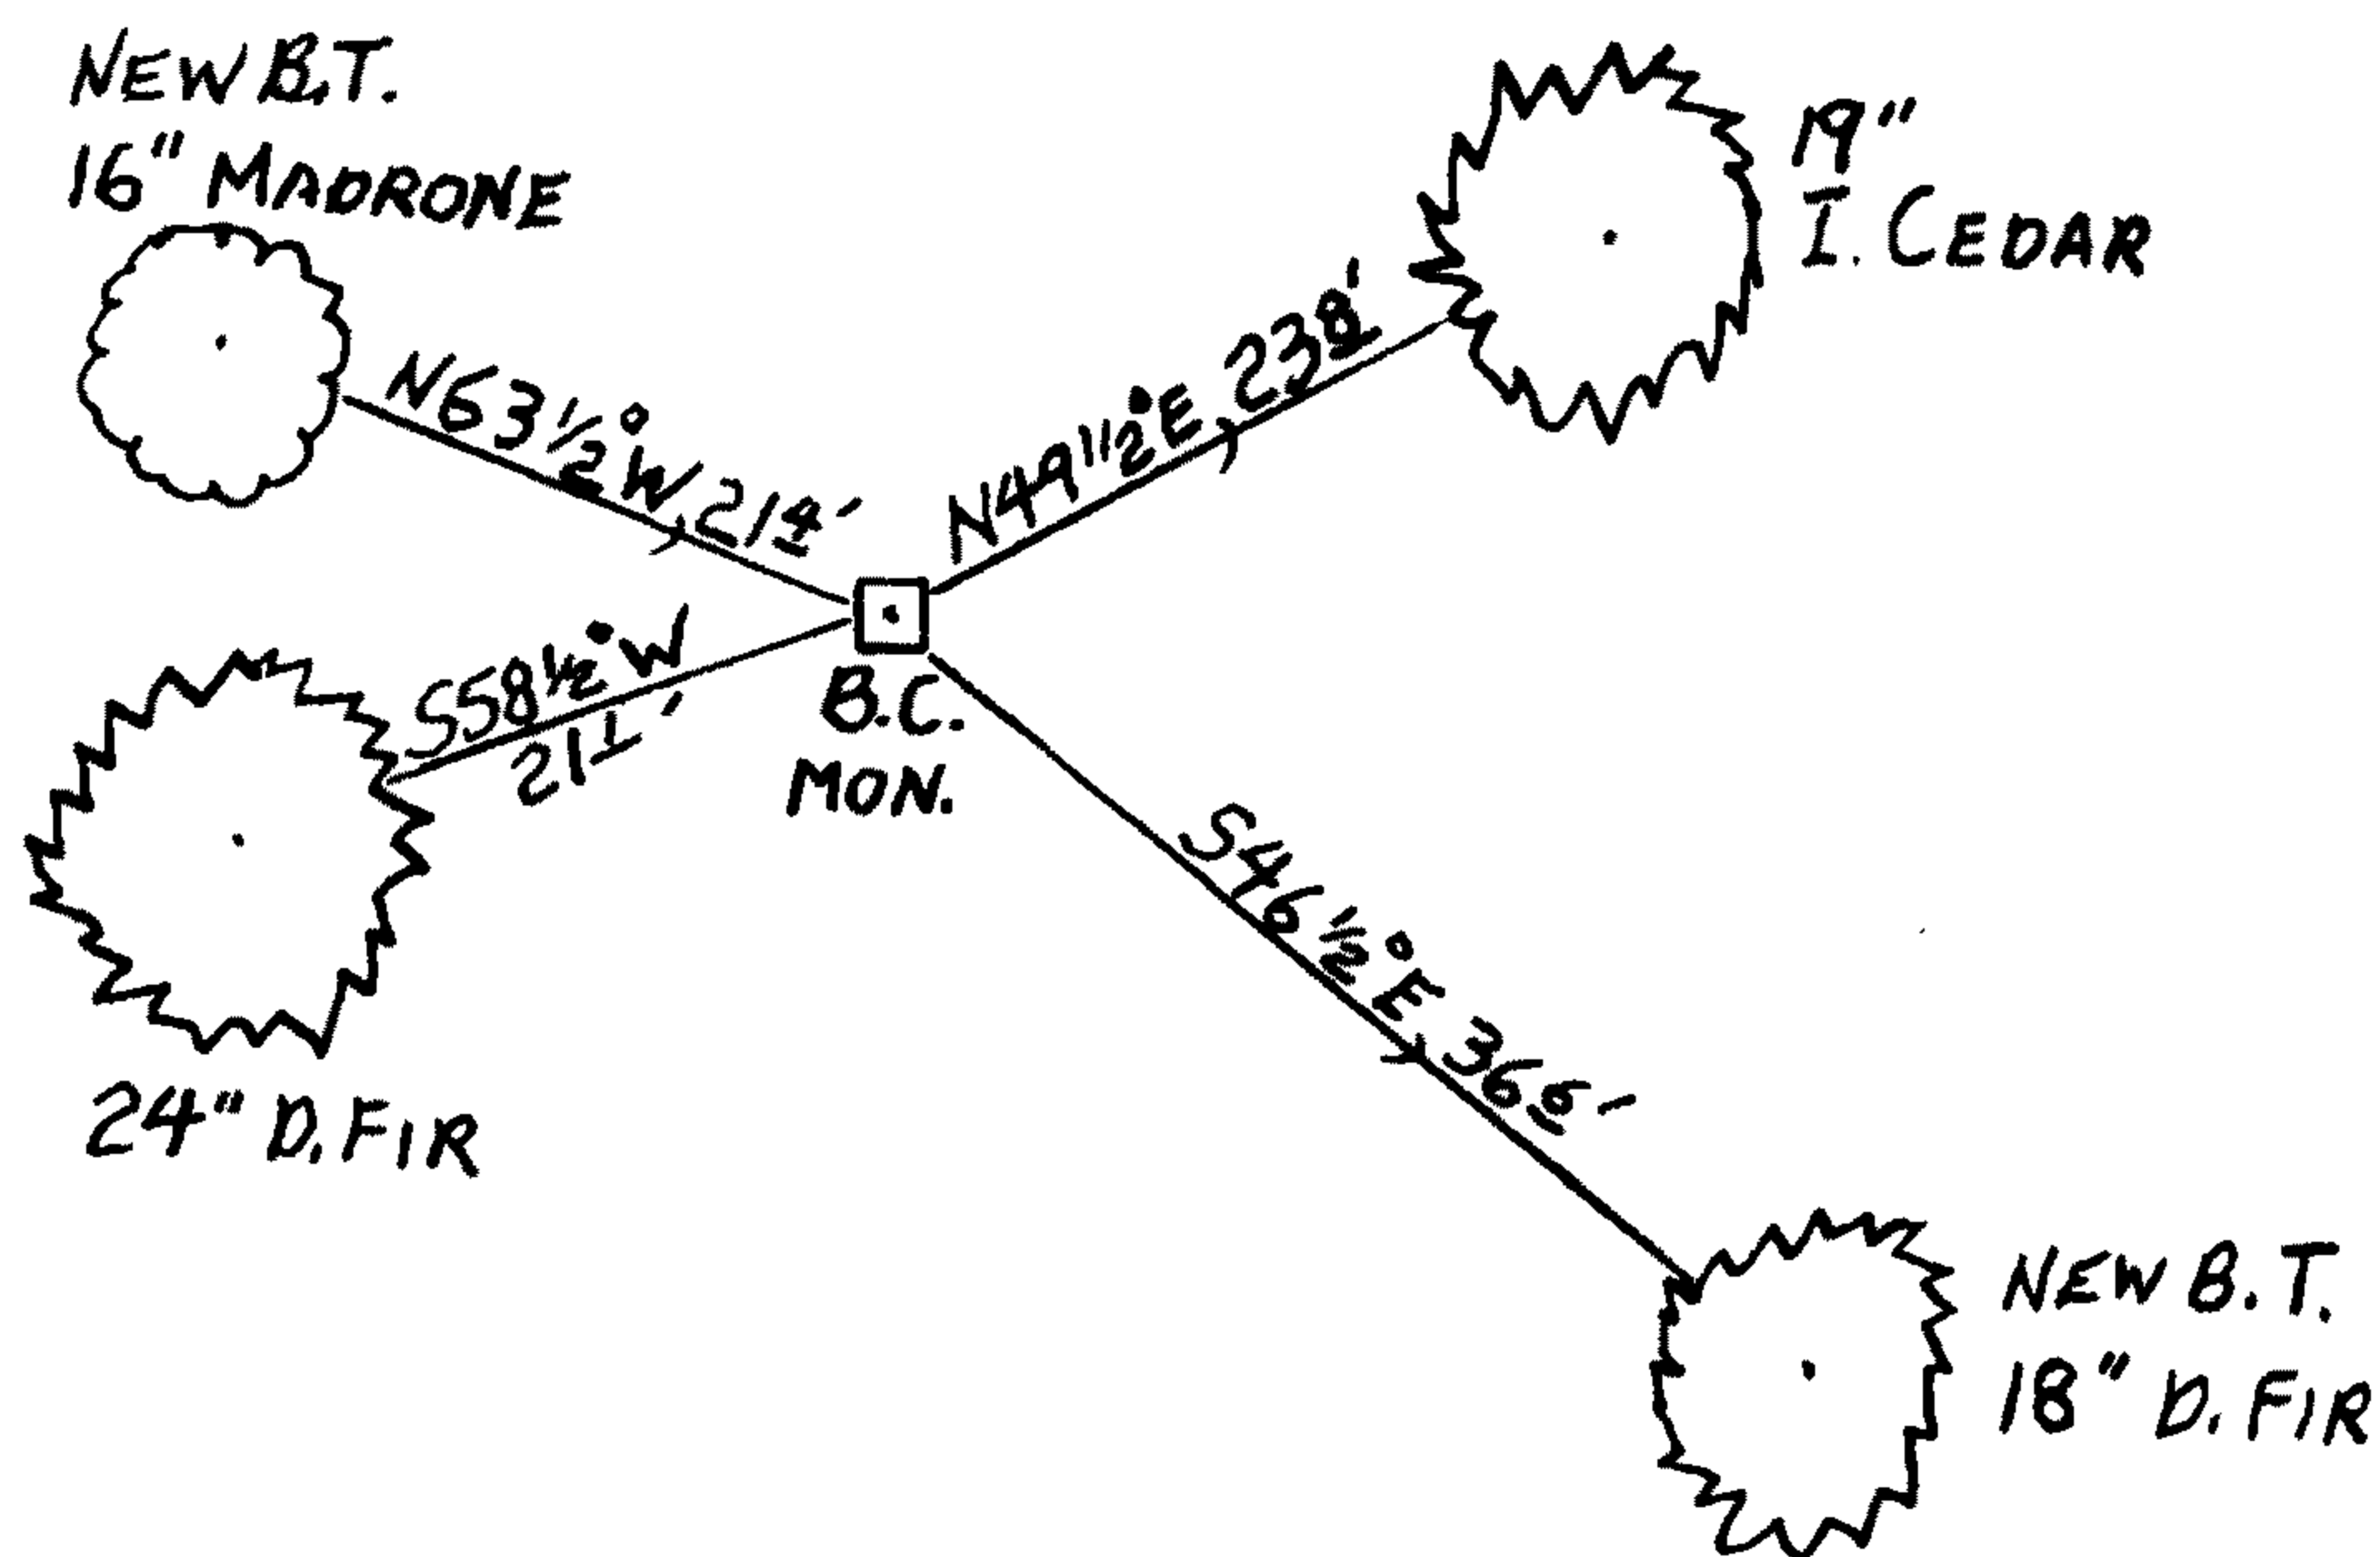

MONUMENT IS ON GENTLE EAST SLOPE OF A BROAD RIDGE IN A MATURE WOODS WITH FIR, MADRONE, CEDAR AND OAK. B.L.M ROAD # 30-5-14.0 IS 120 FEET WEST FROM CORNER.

Comp. Decline. 15 1/2° E  
Agency D.C.S.O.  
Party Chief STEPHEN JOHN FLAUSE  
Note keeper Stephen John Flause  
Witnesses MIKE S. KOCH

Surveyor's Seal

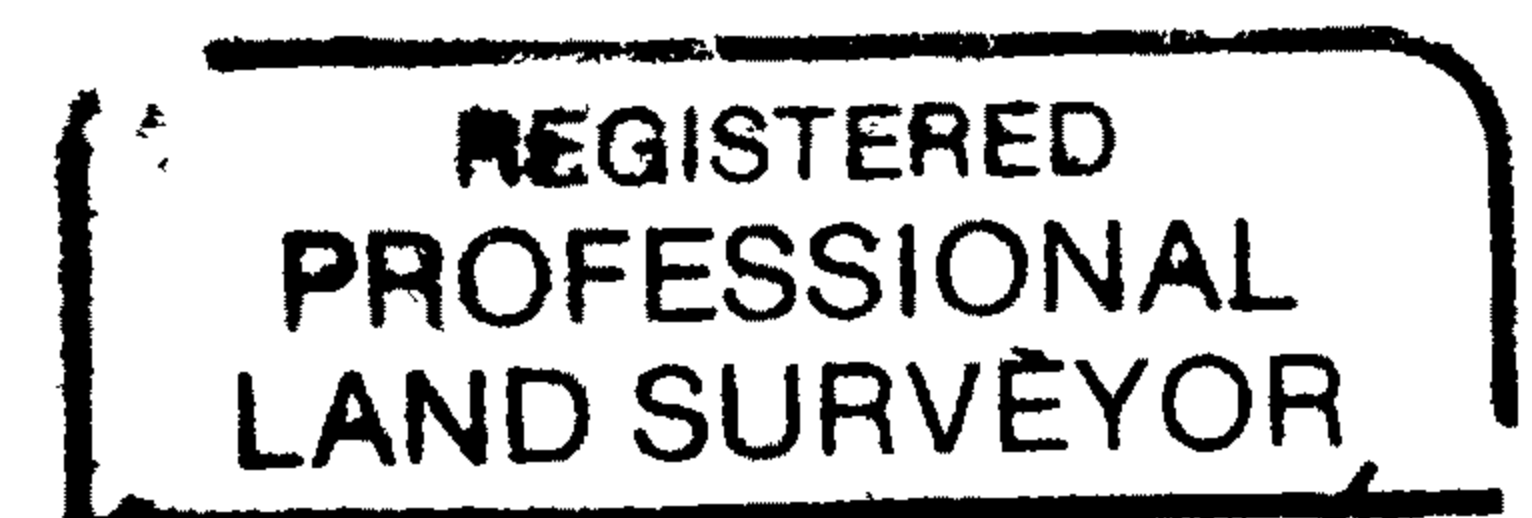

*Signature*  
RENEWAL 6-20-2014

