

GOVERNMENT CORNER RESTORATION FORM

FILED

TOWNSHIP 30S RANGE 04W SEC. 29 PLSS # 200200

Date: 3-4-2013 By: JC

This survey consists of:

DOUGLAS COUNTY OREGON

DATE FEB. 19, 2013

Map: _____

Narrative: _____

Corner Rpt: CS 67/38-18

Corner Designation

530 | 529
531 | 532

DOUGLAS COUNTY SURVEYOR

Previous Renewals 1951
Monument(s) Found: (Condition and Source)

- Condition Report
- Not Found
- Renewed
- Unrecorded
- Surveyed In
- Referenced Out

POSSIBLE ORIGINAL STONE (SEE DESCRIPTION BELOW)
IS LOOSE AND OUT OF POSITION.

MONUMENT DETAIL

1951 CORNER MONUMENT; A 1" x 30" PIPE NOW A
1 INCH O.D. x 23 INCH LONG IRON PIPE FIRMLY SET
PROTRUDING 10 INCHES ABOVE GROUND AND LEANING
APPROX 4 INCHES NORTHEASTERLY FROM PLUMB.
DEPRESSION IN GROUND INDICATES TOP OF PIPE
MAY HAVE BEEN CENTERED OVER ORIGINAL STONE
POSITION.

N/A

ABOVE NOTED LOOSE STONE IS N65°E, 1 1/2 FEET
DISTANT FROM TOP CENTER OF FOUND I.P. MONUMENT.
STONE IS 12 x 9 x 4 INCHES (ORIG. REC. 15 x 10 x 8 INS.)
AND HAS NO DISCERNIBLE MARKINGS. NO OTHER
STONES ARE FOUND NEARBY.

Accessories Found

EVIDENCE OF THE FOUR O.B.T.S.
NE LAUREL AND NW FIR NOW INDISTINCT ROOT-HOLES FOUND NEAR RECORD BEARING AND DISTANCE.
A FIR 14" DIA. NOW A MOSTLY ROTTEN AWAY 14 INCH DIAMETER 2 FOOT TALL FIR STUMP WITH THE
SCRIBING "S.3 VISIBLE ON A FRAGMENTARY BLAZE; BEARS S64°E, 51 1/2 FEET DISTANT
(RECORD S66 1/4°E, 51 1/2 FEET).
A LAUREL 10" DIA. NOW A DEAD, INTACT, 22 INCH DIAMETER MAMMONE WITH A FULLY HEALED
SINGLE BLAZE; BEARS S66 3/4°W, 22 1/2 FEET DISTANT (RECORD S66 3/4°W, 23 1/2 FT. A POSSIBLE SLOPE
MEASUREMENT).

EVIDENCE OF THREE OF THE FOUR 1951 RENEWAL B.T.S.
A FIR 20" DIA. NOW ROTTEN AWAY 16 INCH DIAMETER 2 FOOT TALL FIR STUMP; BEARS N83°E 24°
FEET DISTANT (RECORD N77°E, 26° FT; POSSIBLE MISREAD BEARING AND A GOOD SLOPE DISTANCE).
A CEDAR 14" DIA. NOW A 19 INCH DIAMETER INCENSE CEDAR WITH A HIGH, PARTIALLY HEALED,
SINGLE BLAZE SHOWING VISIBLE BUT ILLEGIBLE SCRIBING AND AN ATTACHED (TO FACE) B.T. TAG;
BEARS N16°W, 53° FEET DISTANT (RECORD N15°W, 53° FEET).
A FIR 18" DIAM. NOW A 2.8 INCH DIAMETER 2 FOOT TALL FIR STUMP WITH A ROTTEN CENTER SHOWING
EVIDENCE OF A HEALED BLAZE IN THE BARK BUT BLAZE FACE ITSELF WOULD BE ROTTEN AWAY;
BEARS S23 1/2°E, 64° FEET DISTANT (RECORD S25°E, 64° FEET).

Monument Set (Procedure and Description)

MONUMENT DETAIL

TOP CENTER POSITION OF FOUND IRON PIPE IS REFERENCE OUT AND PIPE IS REMOVED FROM GROUND. AT REFERENCED POSITION WE PLACE A 2 1/2 INCH DIAMETER BRASS CAP (MARKED AS AT RIGHT) ON A 1 INCH I.D., 32 INCH LONG IRON PIPE FIRMLY AND PLUMBLY SET PROTRUDING 8 INCHES ABOVE GROUND. FOUND 1951 IRON PIPE IS SET ON SOUTH EDGE OF B.C. MONUMENT AND PROTRUDES 6 INCHES. FOUND POSSIBLE ORIGINAL STONE IS SET ON NORTH EDGE OF B.C. MONUMENT AND PROTRUDES 3 INCHES.

DOUGLAS COUNTY SURVEYORS OFFICE

T30S

R4W

30 | 29
31 | 32

2013

New Accessories

3 BEARING TREES:


A 9 INCH DIAMETER DOUGLAS FIR SCRIBED "X" "CSBT" ON A HIGH-LOW DOUBLE BLAZE; BEARS N58 1/2° E, 13 3/4 FEET DISTANT.

AN 11 INCH DIAMETER DOUGLAS FIR SCRIBED "T30SR4WS32" "CSBT" ON A DOUBLE BLAZE; BEARS S17° E, 9 3/4 FEET DISTANT.

A 23 INCH DIAMETER PISTOL BUTT DOUGLAS FIR SCRIBED "T30SR4WS31" "CSBT" ON A DOUBLE BLAZE; BEARS (TO DISCERNIBLE C.R.C.) S64° W, 18 3/4 FEET DISTANT.

Sketch of Monument, Accessories, and General Area

Location & Comments

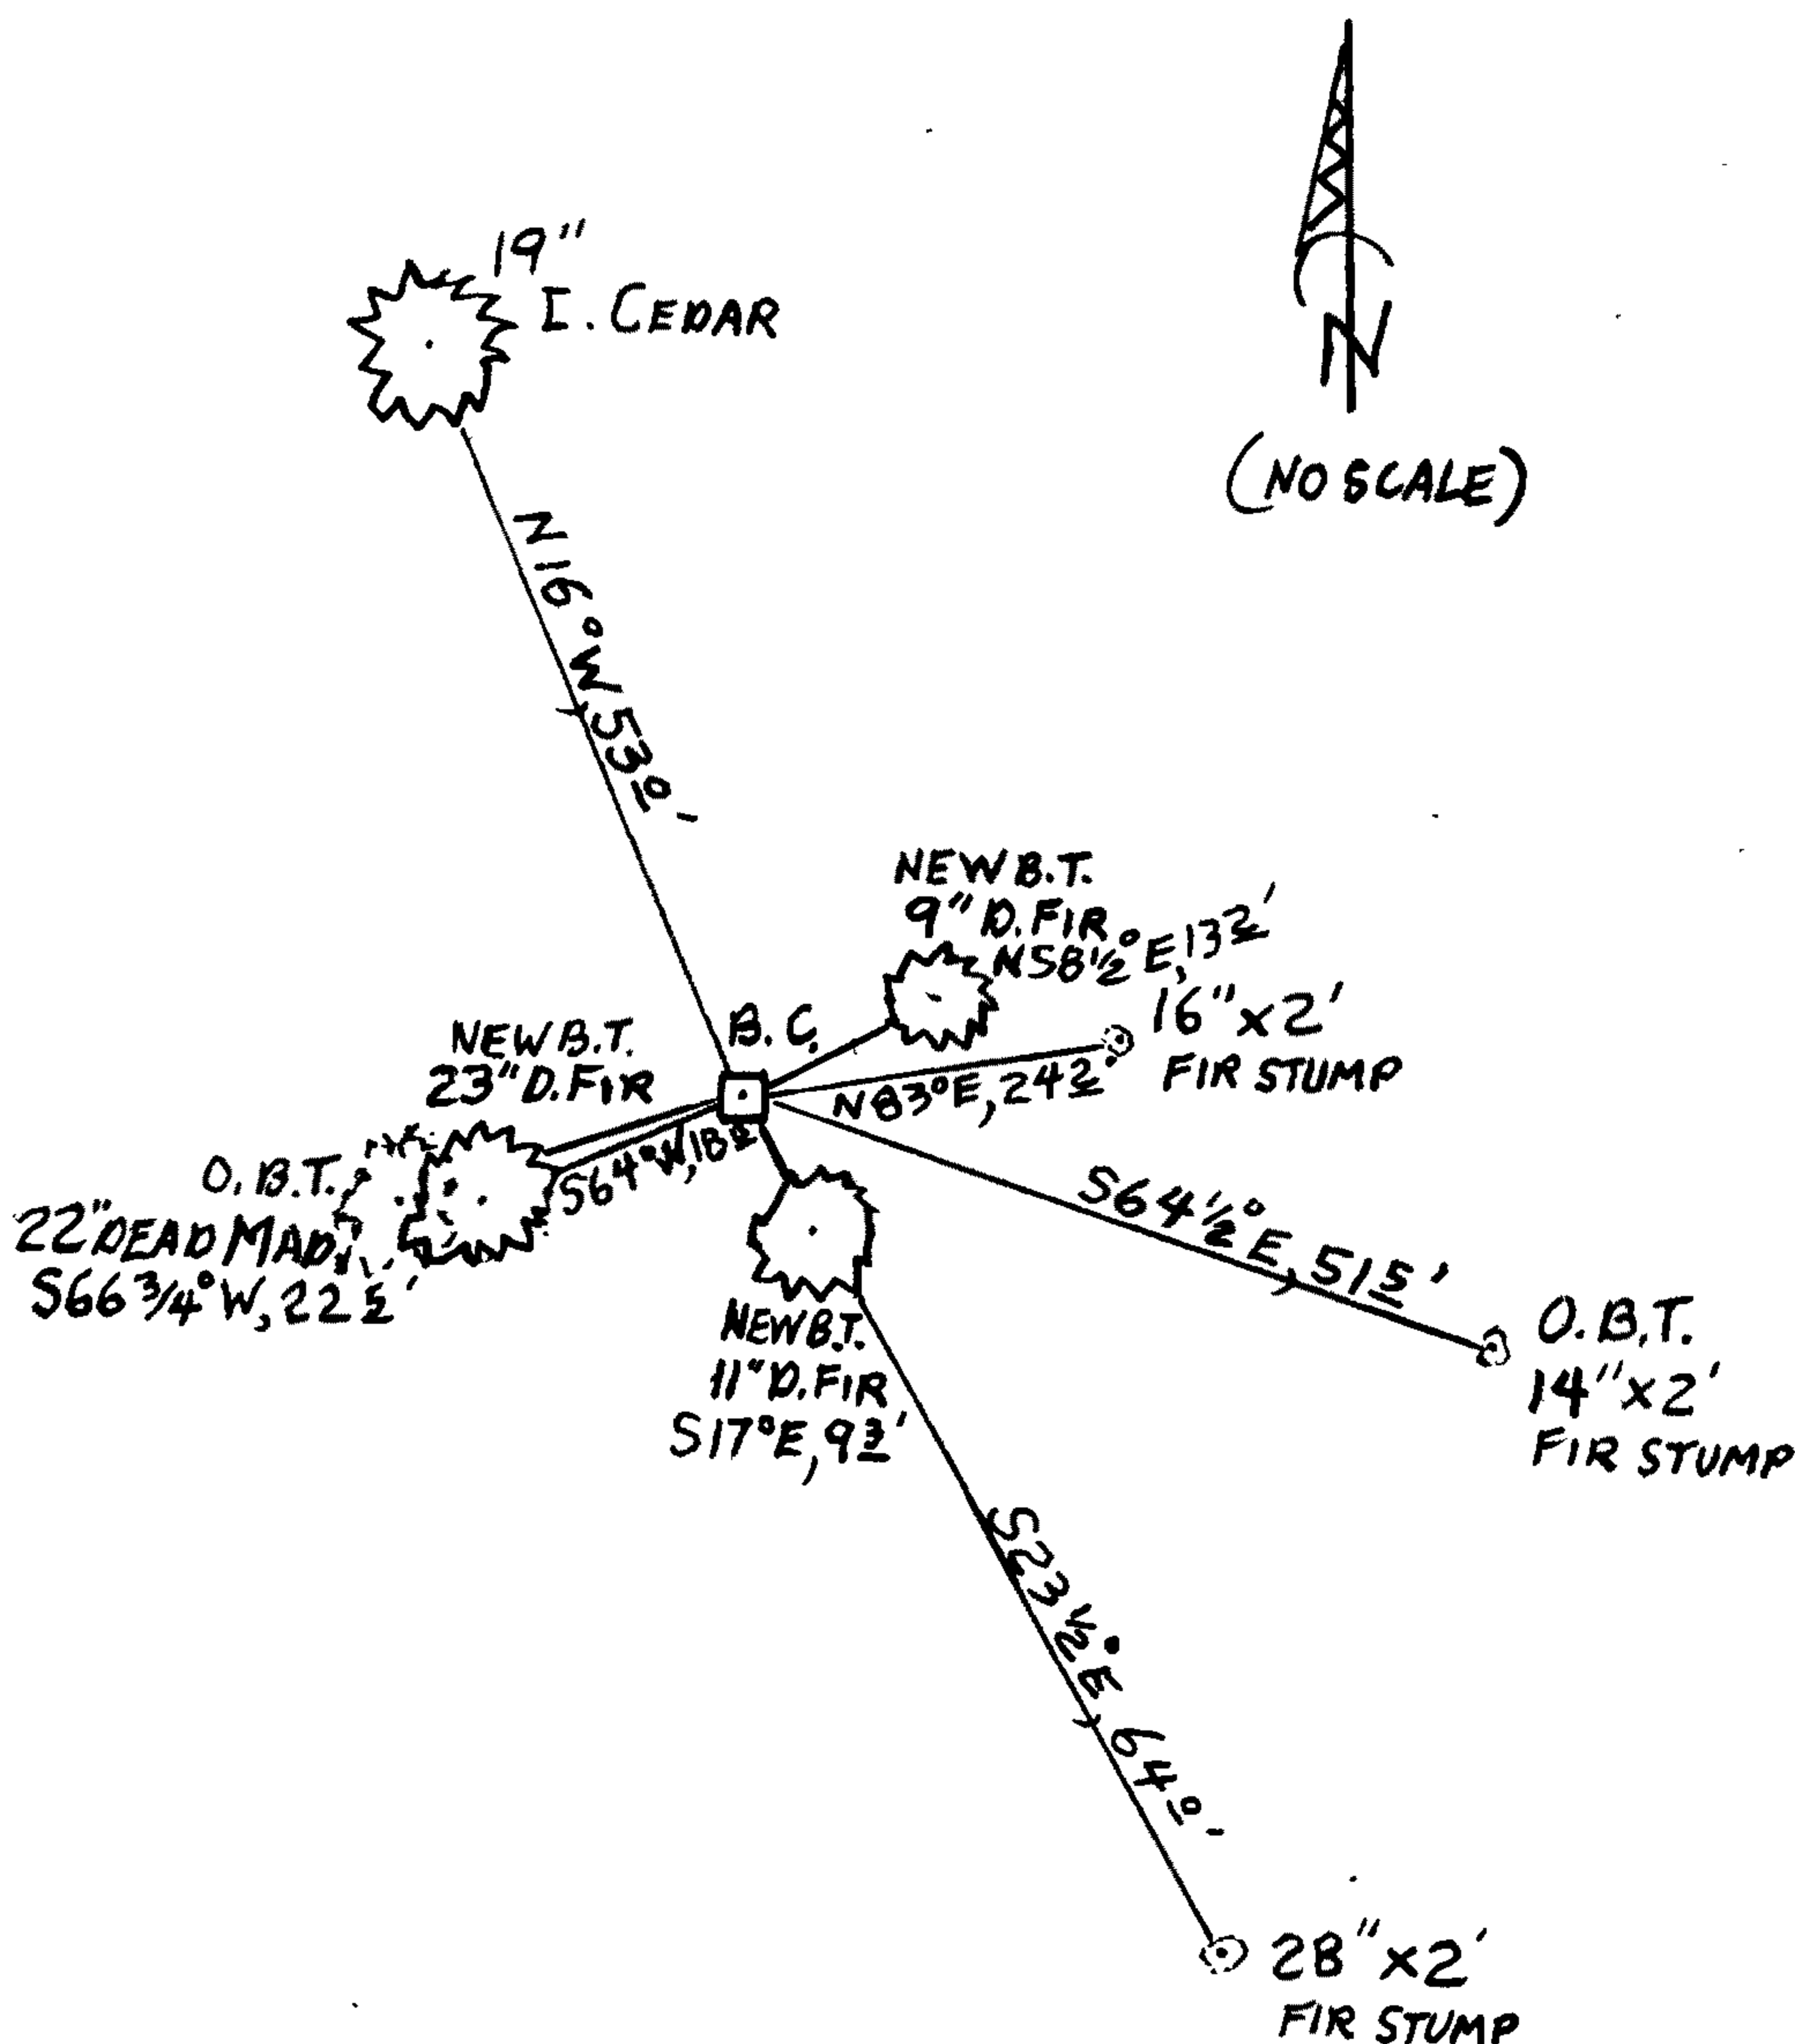

MONUMENT IS ON MODERATELY STEEP WESTERLY SLOPE IN OLD REPROD FIR FOREST WITH SCATTERED CEDAR AND MADRONE.

Comp. Decline. 15 1/2° E
Agency DCSD
Party Chief STEPHEN JOHN FLAUSE
Note keeper Stephen John Flause
Witnesses MIKE S. KOCH

Surveyor's Seal

REGISTERED PROFESSIONAL LAND SURVEYOR

Randall W. Smith

OREGON
JULY 25, 1990
RANDALL W. SMITH
2488

Revised 6-30-14