

GOVERNMENT CORNER RESTORATION FORM

TOWNSHIP 22S RANGE 05W SEC. 02 PLSS # 500600

FILED  
Date: 5/6/2013 By: SC  
This survey consists of:

DOUGLAS COUNTY OREGON DATE APRIL 24, 2013

Map: \_\_\_\_\_  
Narrative: \_\_\_\_\_  
Corner Rpt: CS 67/38-26

Corner Designation

DOUGLAS COUNTY SURVEYOR

53 | S2  
S10 | S11

- Condition Report
- Not Found
- Renewed
- Unrecorded
- Surveyed In
- Referenced Out

Previous Renewals 1952, 1958, 1990  
Monument(s) Found: (Condition and Source)

MONUMENT DETAIL

ORIGINAL 12" STONE AND 1952 IRON PIPE NOT SEEN (WE DID NOT DISTURB FOUND MONUMENT TO SEARCH)

FROM THE 1958 RENEWAL A 2 1/2 INCH DIAM. BRASS CAP (MARKED AS AT RIGHT) ON A 1 INCH I.D. IRON PIPE FIRMLY AND PLUMBLY SET PROTRUDING APPROX. 9 INCHES ABOVE GROUND.

COUNTY SURVEYORS OFFICE  
T 22 S

53 | S2  
S10 | S11  
R 5W  
1958

Accessories Found

EVIDENCE OF ONE ORIGINAL B.T.  
A CEDAR 48" DIA. NOW A 57 INCH DIAM. 7 FOOT TALL CEDAR STUMP WITH NO BLAZES OR MARKS VISIBLE; BEARS N 72° E, 18 1/2 FEET DISTANT (ORIGINAL DISTANCE OF 17 1/2 FEET WOULD BE A GOOD ORIGINAL FACE MEASUREMENT).

EVIDENCE OF THREE 1958 RENEWAL B.T.s.  
A 10" R. FIR NOW A 29 INCH DIAM. 4 FOOT TALL FIR STUMP WITH A FULLY-HEALED DOUBLE BLAZE; BEARS N 31 1/2° E, 39 1/2 FEET DISTANT (RECORD N 34° E, 39 1/2 FT.).

AN 11" R. FIR NOW A 35 INCH DIAM. DOUGLAS FIR WITH A FULLY HEALED DOUBLE BLAZE; BEARS N 13° W, 21 1/2 FEET DISTANT (AS PER RECORD). THIS TREE WAS ERRONEOUSLY DESCRIBED AS BLOWN DOWN IN A 1999 CONDITION REPORT. THIS TREE WILL BE CUT TO A LOW STUMP SOON.

A 6" R. FIR NOW A 30 INCH DIAM. 1 1/2 FOOT TALL FIR STUMP SHOWING SOME BLAZE HEALING OVER A ROTTEN AWAY FACE; BEARS S 65 1/4° E, 120.8 FEET DISTANT (BEARING AGREES WITH 1990 MEAS. DISTANCE IS RECORD).

AN 8" R. FIR NOW A 36 INCH DIAM. DOUGLAS FIR WITH A FULLY HEALED SINGLE BLAZE; BEARS S 5 1/2° W, 53 1/2 FEET DISTANT (DISTANCE AGREES WITH 1990 RECORD).

THE 1990 RENEWAL BEARING TREE A 9" D. FIR NOW A 16 INCH DIAM. DOUGLAS FIR WITH A FULLY-HEALED DOUBLE BLAZE; BEARS S 53 1/2° E, 61 1/2 FEET DISTANT (AS PER RECORD).

Monument Set (Procedure and Description)

MONUMENT DETAIL

N/A

N/A

New Accessories


AN 8 INCH DIAM. DOUGLAS FIR SCRIBED "T22SR5WS10CS" "BT" ON A DOUBLE BLAZE; BEARS S27°W, 352 FEET DISTANT.

Sketch of Monument, Accessories, and General Area

Location & Comments

SKETCH SHOWS LIVE B.T.S AND O.B.T. STUMP ONLY.

MONUMENT IS ON GENERALLY FLAT GROUND WITH A GENTLE SLOPE COMING DOWN FROM SOUTHEAST IN OLD RE-GROWTH FIR FOREST

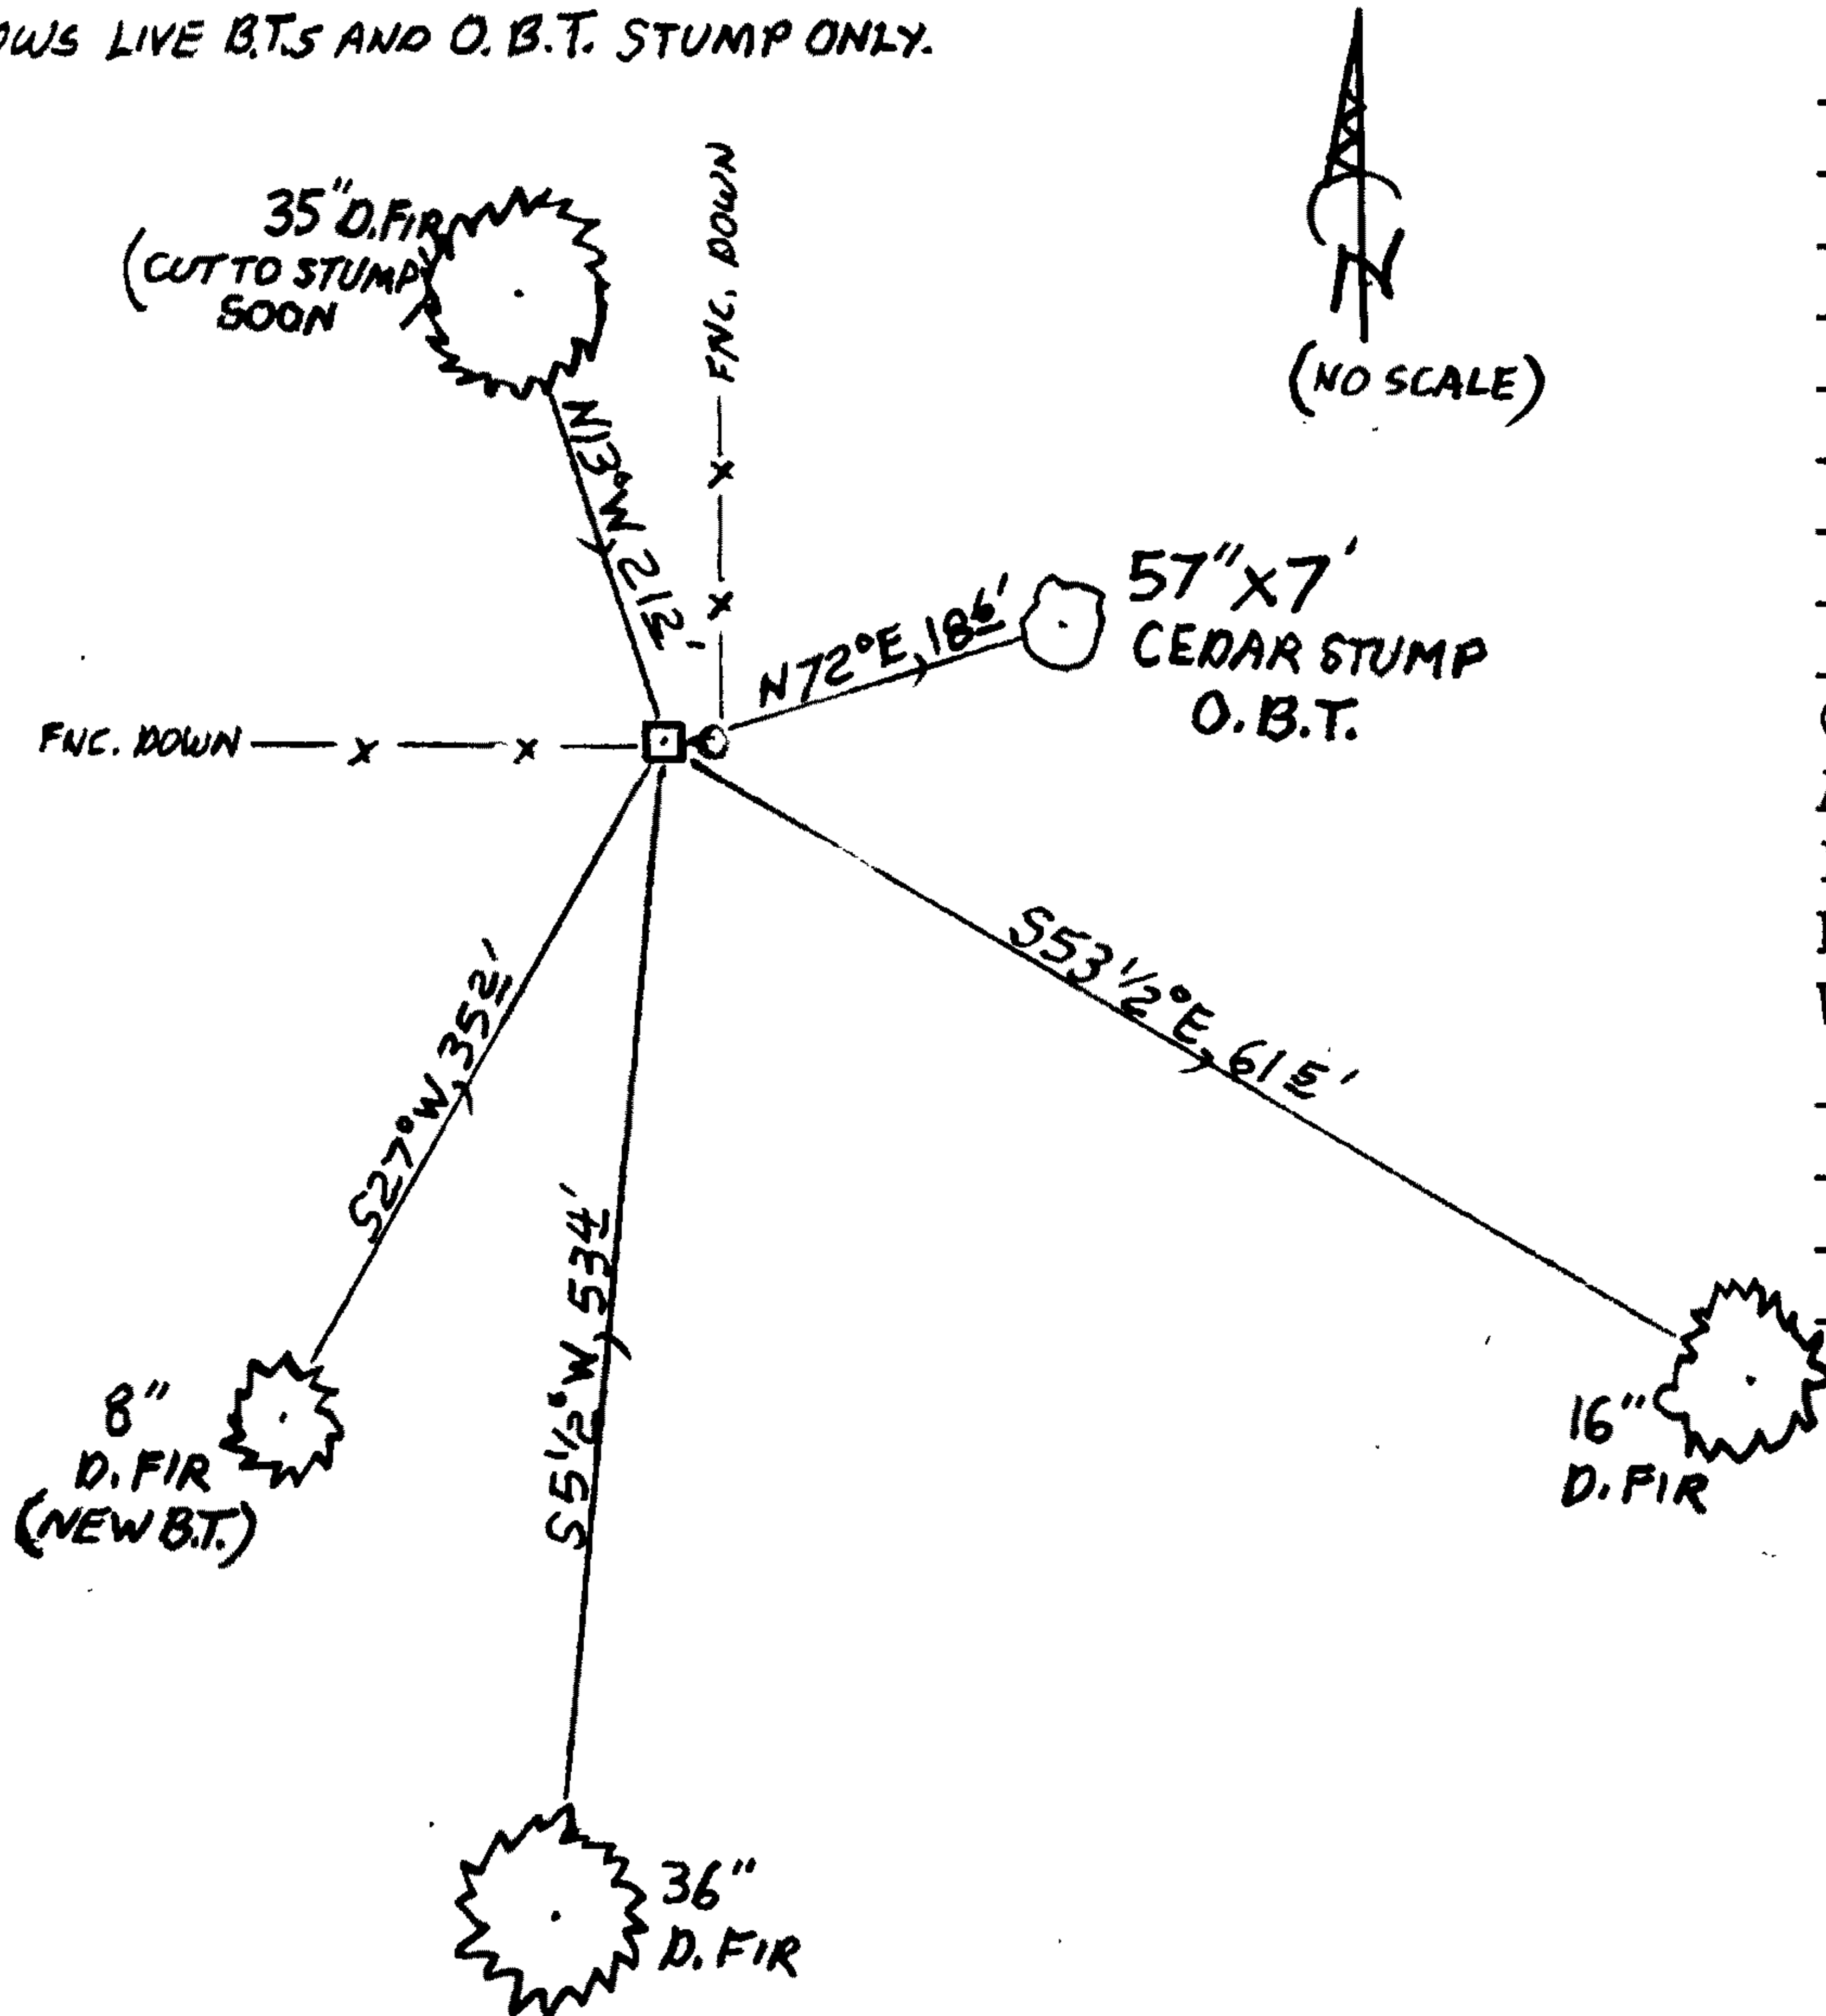

Comp. Decline. 15 1/2° E  
 Agency DCSO  
 Party Chief STEPHEN JOHN FLAISE  
 Note keeper Stephen John Flaise  
 Witnesses MIKE S. KOCH

Surveyor's Seal

REGISTERED  
 PROFESSIONAL  
 LAND SURVEYOR

*Randall W. Smith*

OREGON  
 JULY 25, 1980  
 RANDALL W. SMITH  
 2489

*Roller 6-30-2012*