

GOVERNMENT CORNER RESTORATION FORM

FILED

TOWNSHIP 21S RANGE 04W SEC. 07 PLSS # 200540

Date: 7/17/2013 By: SC
This survey consists of:

DOUGLAS COUNTY OREGON

DATE JULY 8, 2013

Map: _____

Corner Designation

Narrative: _____
Corner Rpt: CS 67/38-36

DOUGLAS COUNTY
SURVEYOR

Previous Renewals 1923, 1969
Monument(s) Found: (Condition and Source)

- Condition Report
- Not Found
- Renewed
- Unrecorded
- Surveyed In
- Referenced Out


NO EVIDENCE OF CEDAR POST FOUND IN 1969 REMAINS.

MONUMENT DETAIL

FROM THE 1969 RENEWAL A 2 1/2 INCH DIAMETER BRASS CAP (MARKED AS AT RIGHT) ON A 1/4 INCH I.D. IRON PIPE IS FIRMLY AND PLUMBLY SET PROTRUDING 8 INCHES ABOVE GROUND.

COUNTY SURVEYORS OFFICE

T 21 S

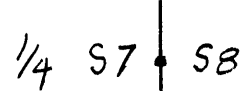

R4W

1969

Accessories Found

NO EVIDENCE OF O.B.T.S REMAINS.

NO EVIDENCE OF 1923 RENEWAL B.T.S REMAINS

ONE 1969 RENEWAL B.T.
A 16" D. FIR NOW A 33 INCH DIAMETER DOUGLAS FIR WITH A FULLY HEALED DOUBLE BLAZE; BEARS S87°E, 58 FEET DISTANT (AS PER RECORD).

C.S. File 67/38-36

RENEWAL

Monument Set (Procedure and Description)

MONUMENT DETAIL

N/A

N/A

New Accessories


A 5 INCH DIAM. DOUGLAS FIR SCRIBED "XCS" "BT" ON A HIGH-LOW BLAZE; BEARS N24 1/2° E, 18° FEET DISTANT.

A 4 INCH DIAM. DOUGLAS FIR SCRIBED "X" "CSBT" ON A HIGH-LOW BLAZE; BEARS N54° W, 15 1/2 FEET DISTANT.

A 21 INCH DIAM. DOUGLAS FIR SCRIBED "1/4 57CS" "BT" ON A DOUBLE BLAZE; BEARS N16 1/2° W, 24 1/2 FEET DISTANT.

Sketch of Monument, Accessories, and General Area

Location & Comments

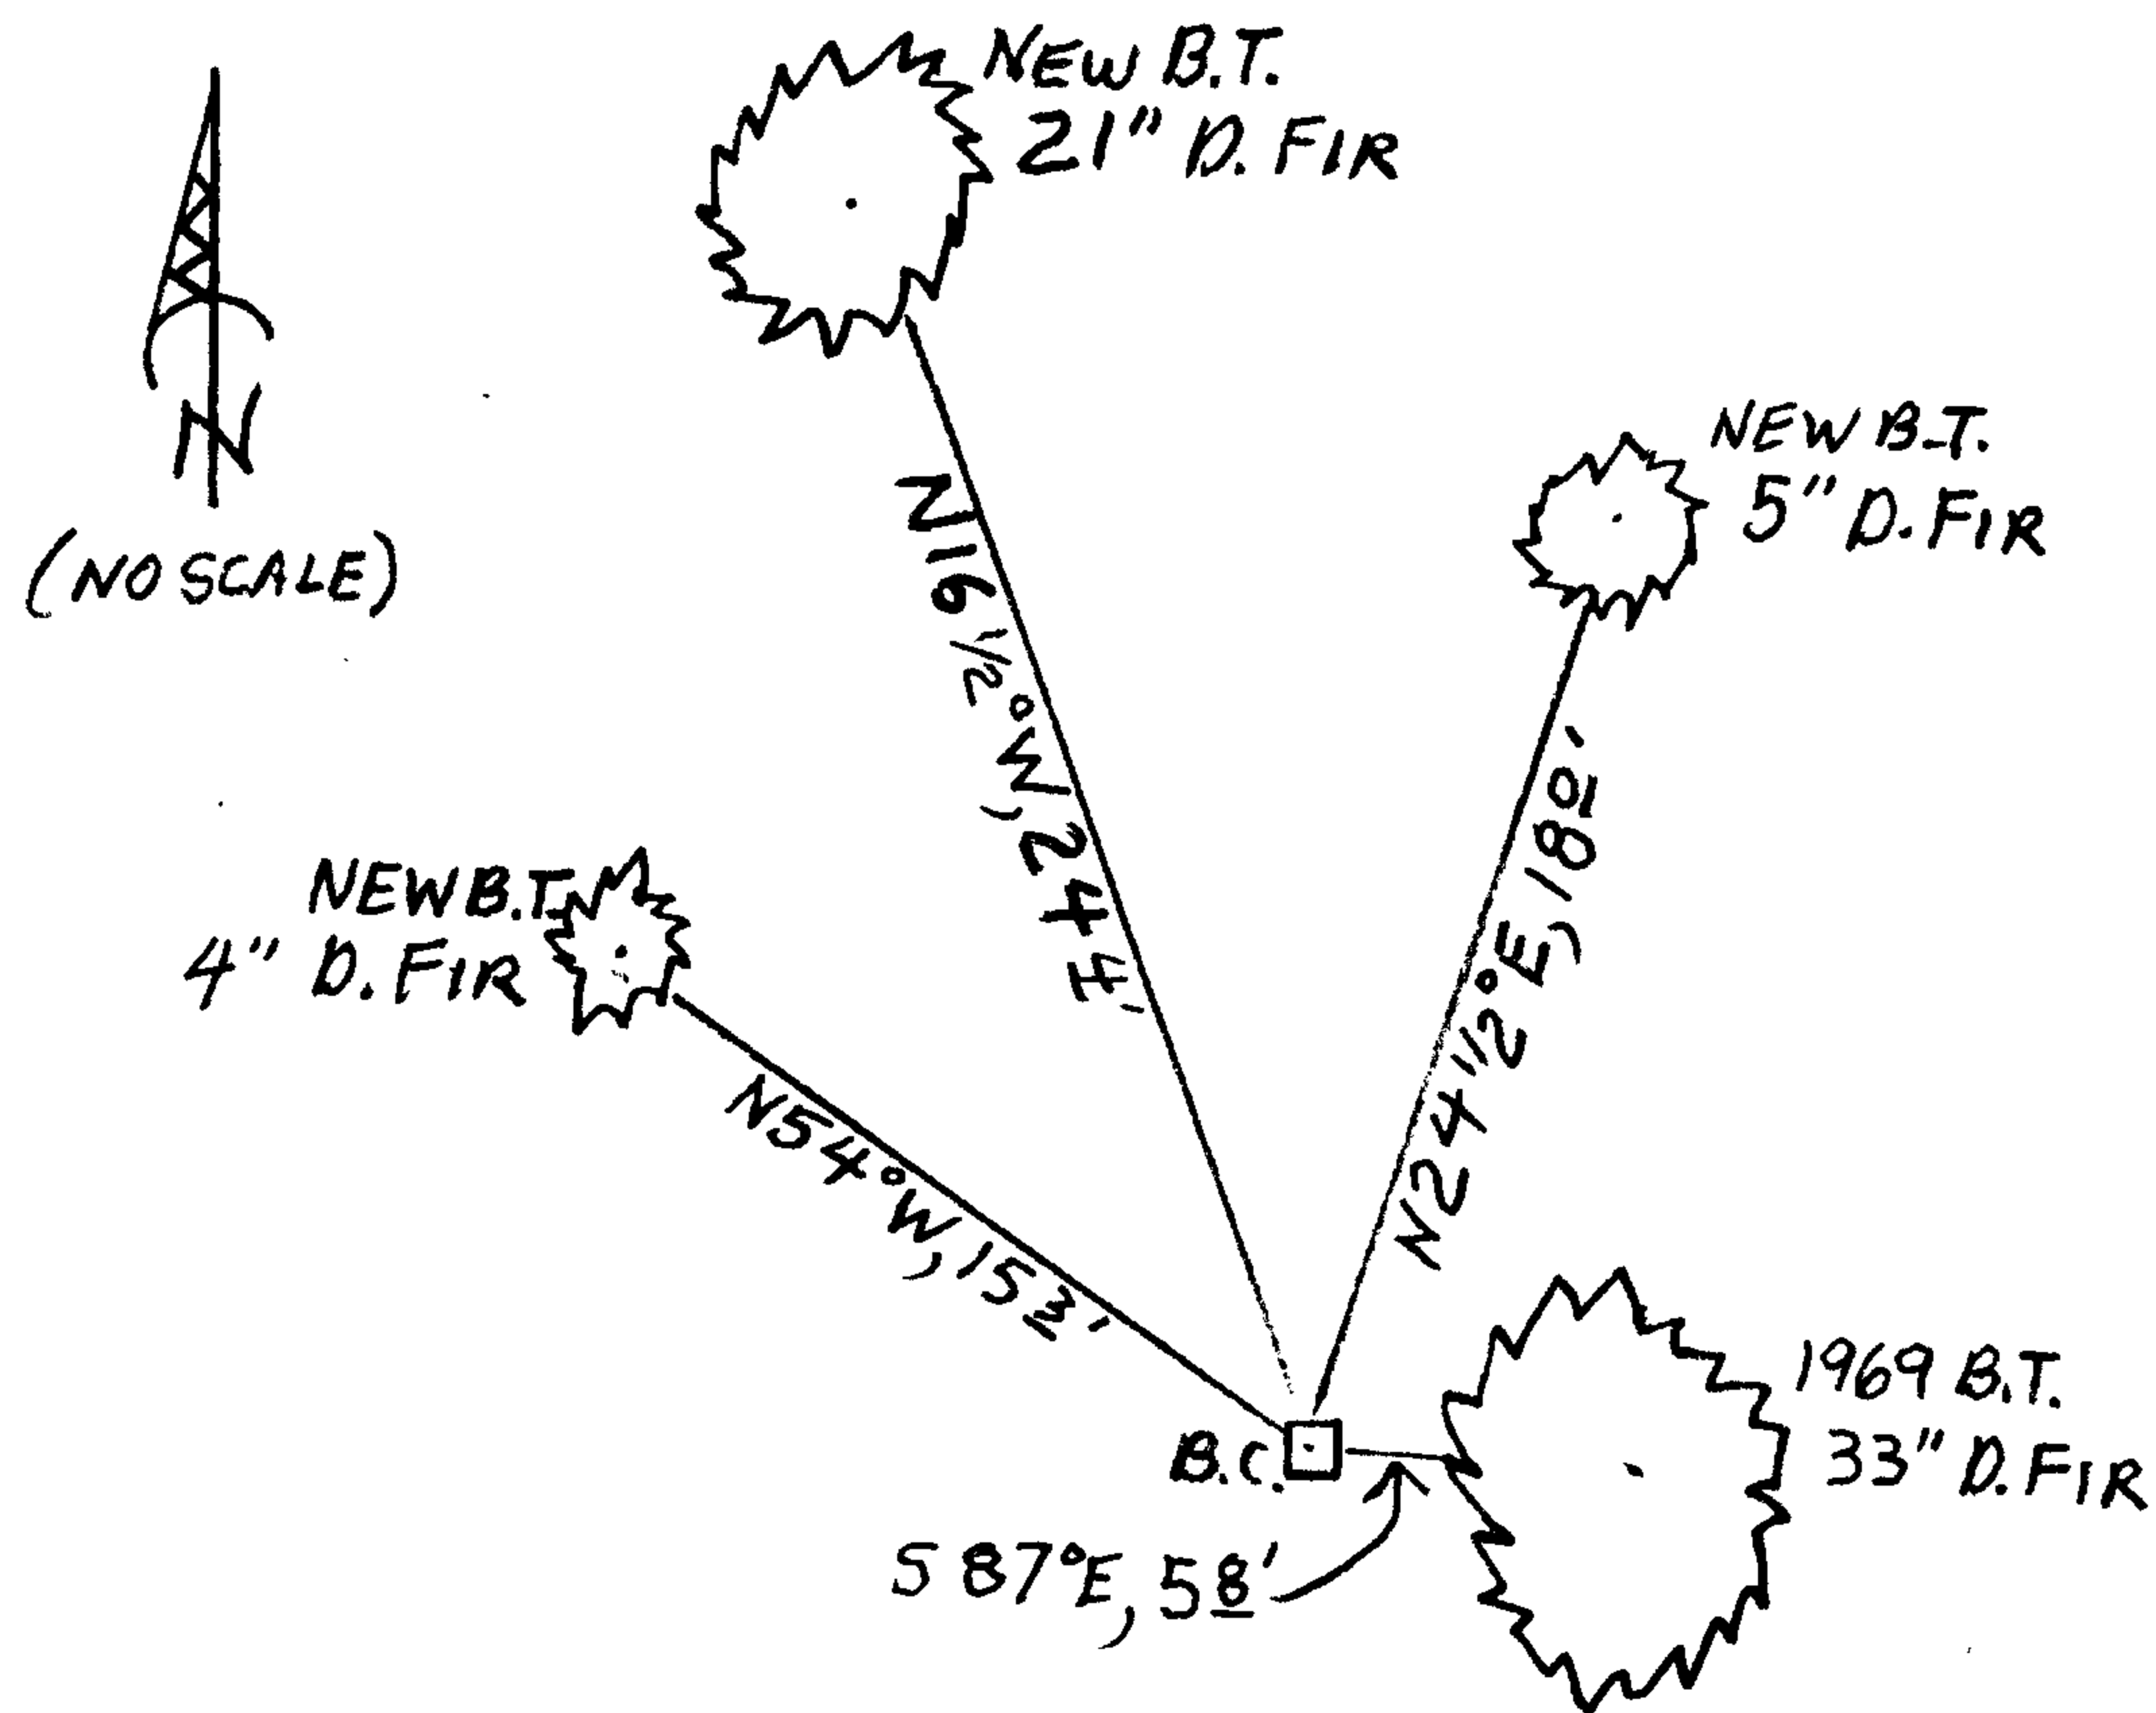

MONUMENT IS ON GROUND SLOPING GENTLY EAST AT EAST EDGE OF VERY OLD, OPEN SECOND GROWTH FIR FOREST AND WEST EDGE OF OPEN 20+ YEAR OLD FIR REPROD. MONUMENT IS 45 FEET EAST FROM A GRAVELLED FOREST ACCESS RD.

Comp. Decline. 15 1/2° E
Agency D.C.S.O.
Party Chief STEPHEN JOHN FLAUSE
Note keeper Stephen John Flause
Witnesses MIKE S. KOCH

Surveyor's Seal

REGISTERED PROFESSIONAL LAND SURVEYOR

Randall W. Smith

OREGON JULY 25, 1990 RANDALL W. SMITH 2488

ROWWA 6-30-2014