

Monument Set (Procedure and Description)

MONUMENT DETAIL

N/A

N/A

New Accessories

B.T. TAGS ARE RENAILED. MONUMENT AND B.T.s ARE REFLAGGED.

Sketch of Monument, Accessories, and General Area


Location & Comments

N/A

MONUMENT IS ON NORTH EDGE OF 30+ YEAR OLD REPROD. FIR FOREST AT SOUTH EDGE OF OLD SECOND GROWTH FIR FOREST ON A MODERATE SOUTHERLY SLOPE.

Comp. Decline. 15 1/2° E
Agency D.C.S.O.
Party Chief STEPHEN JOHN FLAUSE
Note keeper Stephen John Flause
Witnesses MIKE S. KOCH

Surveyor's Seal

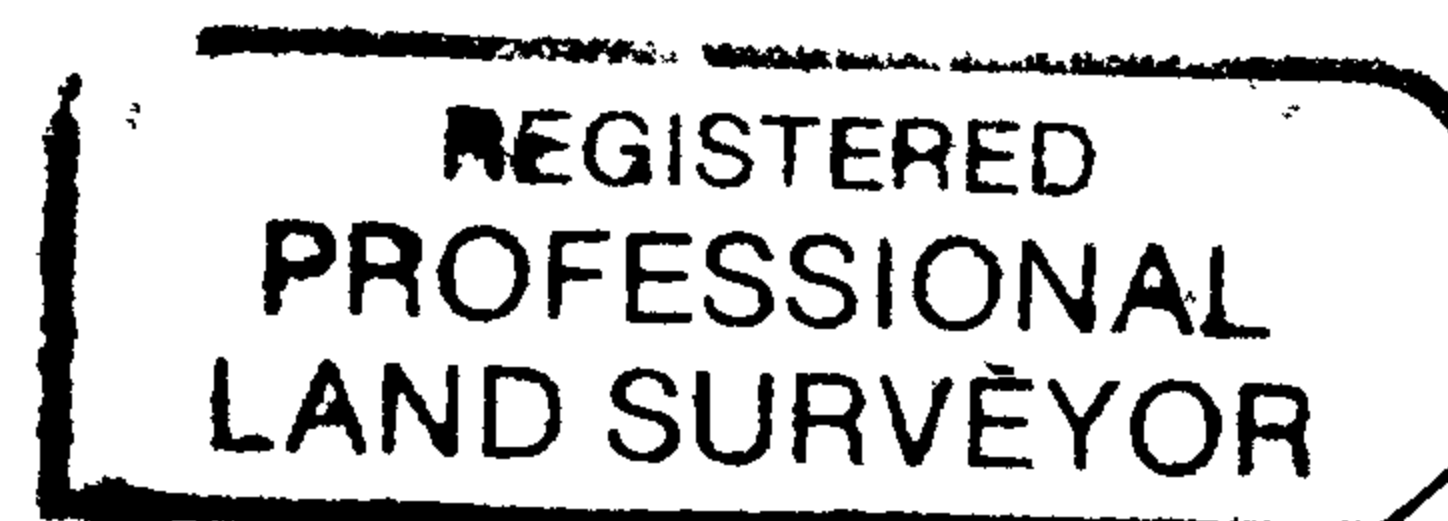

Signature
RENEWAL 6-30-2014
OREGON
JULY 25, 1990
RANDALL W. SMITH
2400