

GOVERNMENT CORNER RESTORATION FORM

TOWNSHIP 21S RANGE 4W SEC. 17 PLSS # 220440

DOUGLAS COUNTY OREGON

DATE JULY 18, 2013

FILED  
Date: 7/29/2013 By: SC

This survey consists of:

Map: \_\_\_\_\_

Narrative: \_\_\_\_\_

Corner Rpt: CS 67/38-42

Corner Designation

C  $\frac{W}{16}$  C

FD  
OK

DOUGLAS COUNTY  
SURVEYOR

Previous Renewals NONE  
Monument(s) Found: \_\_\_\_\_ (Condition and Source)

AS DESCRIBED

- Condition Report
- Not Found
- Renewed
- Unrecorded
- Surveyed In
- Referenced Out

MONUMENT DETAIL

N/A

Accessories Found

AS DESCRIBED

Monument Set (Procedure and Description)

MONUMENT DETAIL

N/A

N/A

New Accessories

RENAIL B.T. TAGS, REFLAG MONUMENT AND B.T.'S

Sketch of Monument, Accessories, and General Area


Location & Comments

N/A

MONUMENT IN VERY OLD SECOND GROWTH FOREST ON MODERATE WEST SLOPE

Comp. Decline. 15 1/2° E  
Agency D.C.S.D.  
Party Chief STEPHEN JOHN FLAUSE  
Note keeper Stephen John Flause  
Witnesses MIKE S. KOCH

Surveyor's Seal

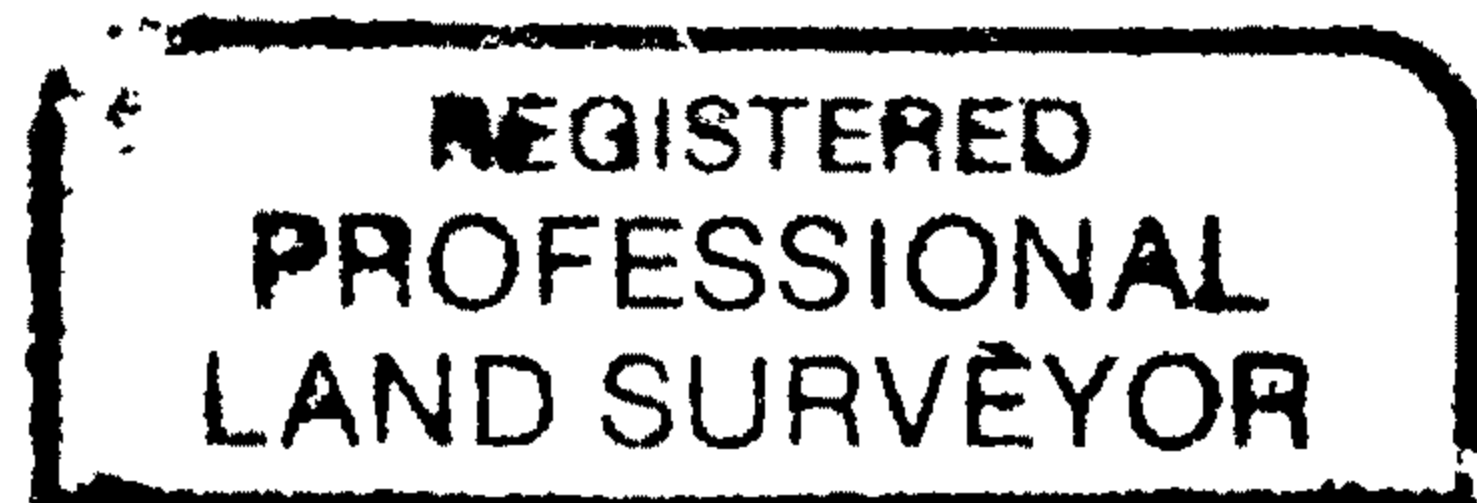

*Randall W. Smith*  
RENEWAL 6-30-2014

