

GOVERNMENT CORNER RESTORATION FORM

TOWNSHIP 21S RANGE 04W SEC. 17 PLSS # 240440

DOUGLAS COUNTY OREGON

DATE JULY 18, 2013

Corner Designation

C 1/4 S17

Previous Renewals MONUMENT ESTB. 1988
Monument(s) Found: (Condition and Source)

A 3 1/4 INCH DIAMETER BRASS CAP (MARKED AS AT RIGHT) ON A 2 1/2 INCH I.D. STEEL PIPE, FIRMLY AND PLUMBLY SET, PROTRUDING 4 INCHES ABOVE GROUND.

FILED
Date: 7/29/2013 By: JC
This survey consists of:
Map: _____
Narrative: _____
Corner Rpt: CS 67/38-43

DOUGLAS COUNTY
SURVEYOR

- Condition Report
- Not Found
- Renewed
- Unrecorded
- Surveyed In
- Referenced Out

MONUMENT DETAIL

U.S. DEPT. OF THE INTERIOR
T21S R4W
C1/4 S17
1988
BUR. OF LAND MANAGEMENT

Accessories Found

THE THREE 1988 REFERENCES. TREES ARE O.B.T.S.

A FIR 11" DIA. NOW A DEAD AND PARTLY ROTTED 11 INCH DIAM. APPROX 30 FOOT TALL FIR SNAG WITH A PARTIALLY HEALED BUT ROTTED BLAZE (NO FACE OR SCRIBING REMAINS); BEARS N29°E, 18[±] FEET DISTANT (AS PER RECORD).

A FIR 33" DIA. NOW A 38 INCH DIA. DOUGLAS FIR WITH A FULLY HEALED DOUBLE BLAZE; BEARS S67°W, 34[±] FEET DISTANT (AS PER RECORD).

A FENCE CORNER NOW A FENCE CORNER POST WITH BRACING POSTS (FENCES ARE DOWN); BEARS N27 1/4°E, 48[±] FEET DISTANT (RECORD N27 1/4°E, 46[±] FEET).

Monument Set (Procedure and Description)

MONUMENT DETAIL

N/A

N/A

New Accessories


A 15 INCH DIAM. WHITE FIR SCRIBED "C1/4 S17" "CSBT" ON A DOUBLE BLAZE; BEARS N56°E, 42 FEET DISTANT.

A 12 INCH DIAM. WHITE FIR SCRIBED "C1/4 S17CS" "BT" ON A DOUBLE BLAZE; BEARS S75 1/4°E, 17 1/2 FEET DISTANT.

A 6 INCH DIAM. DOUGLAS FIR SCRIBED "C1/4 S17CS" "BT" ON A DOUBLE BLAZE; BEARS N51 1/2°W, 28 FEET DISTANT.

Sketch of Monument, Accessories, and General Area

Location & Comments

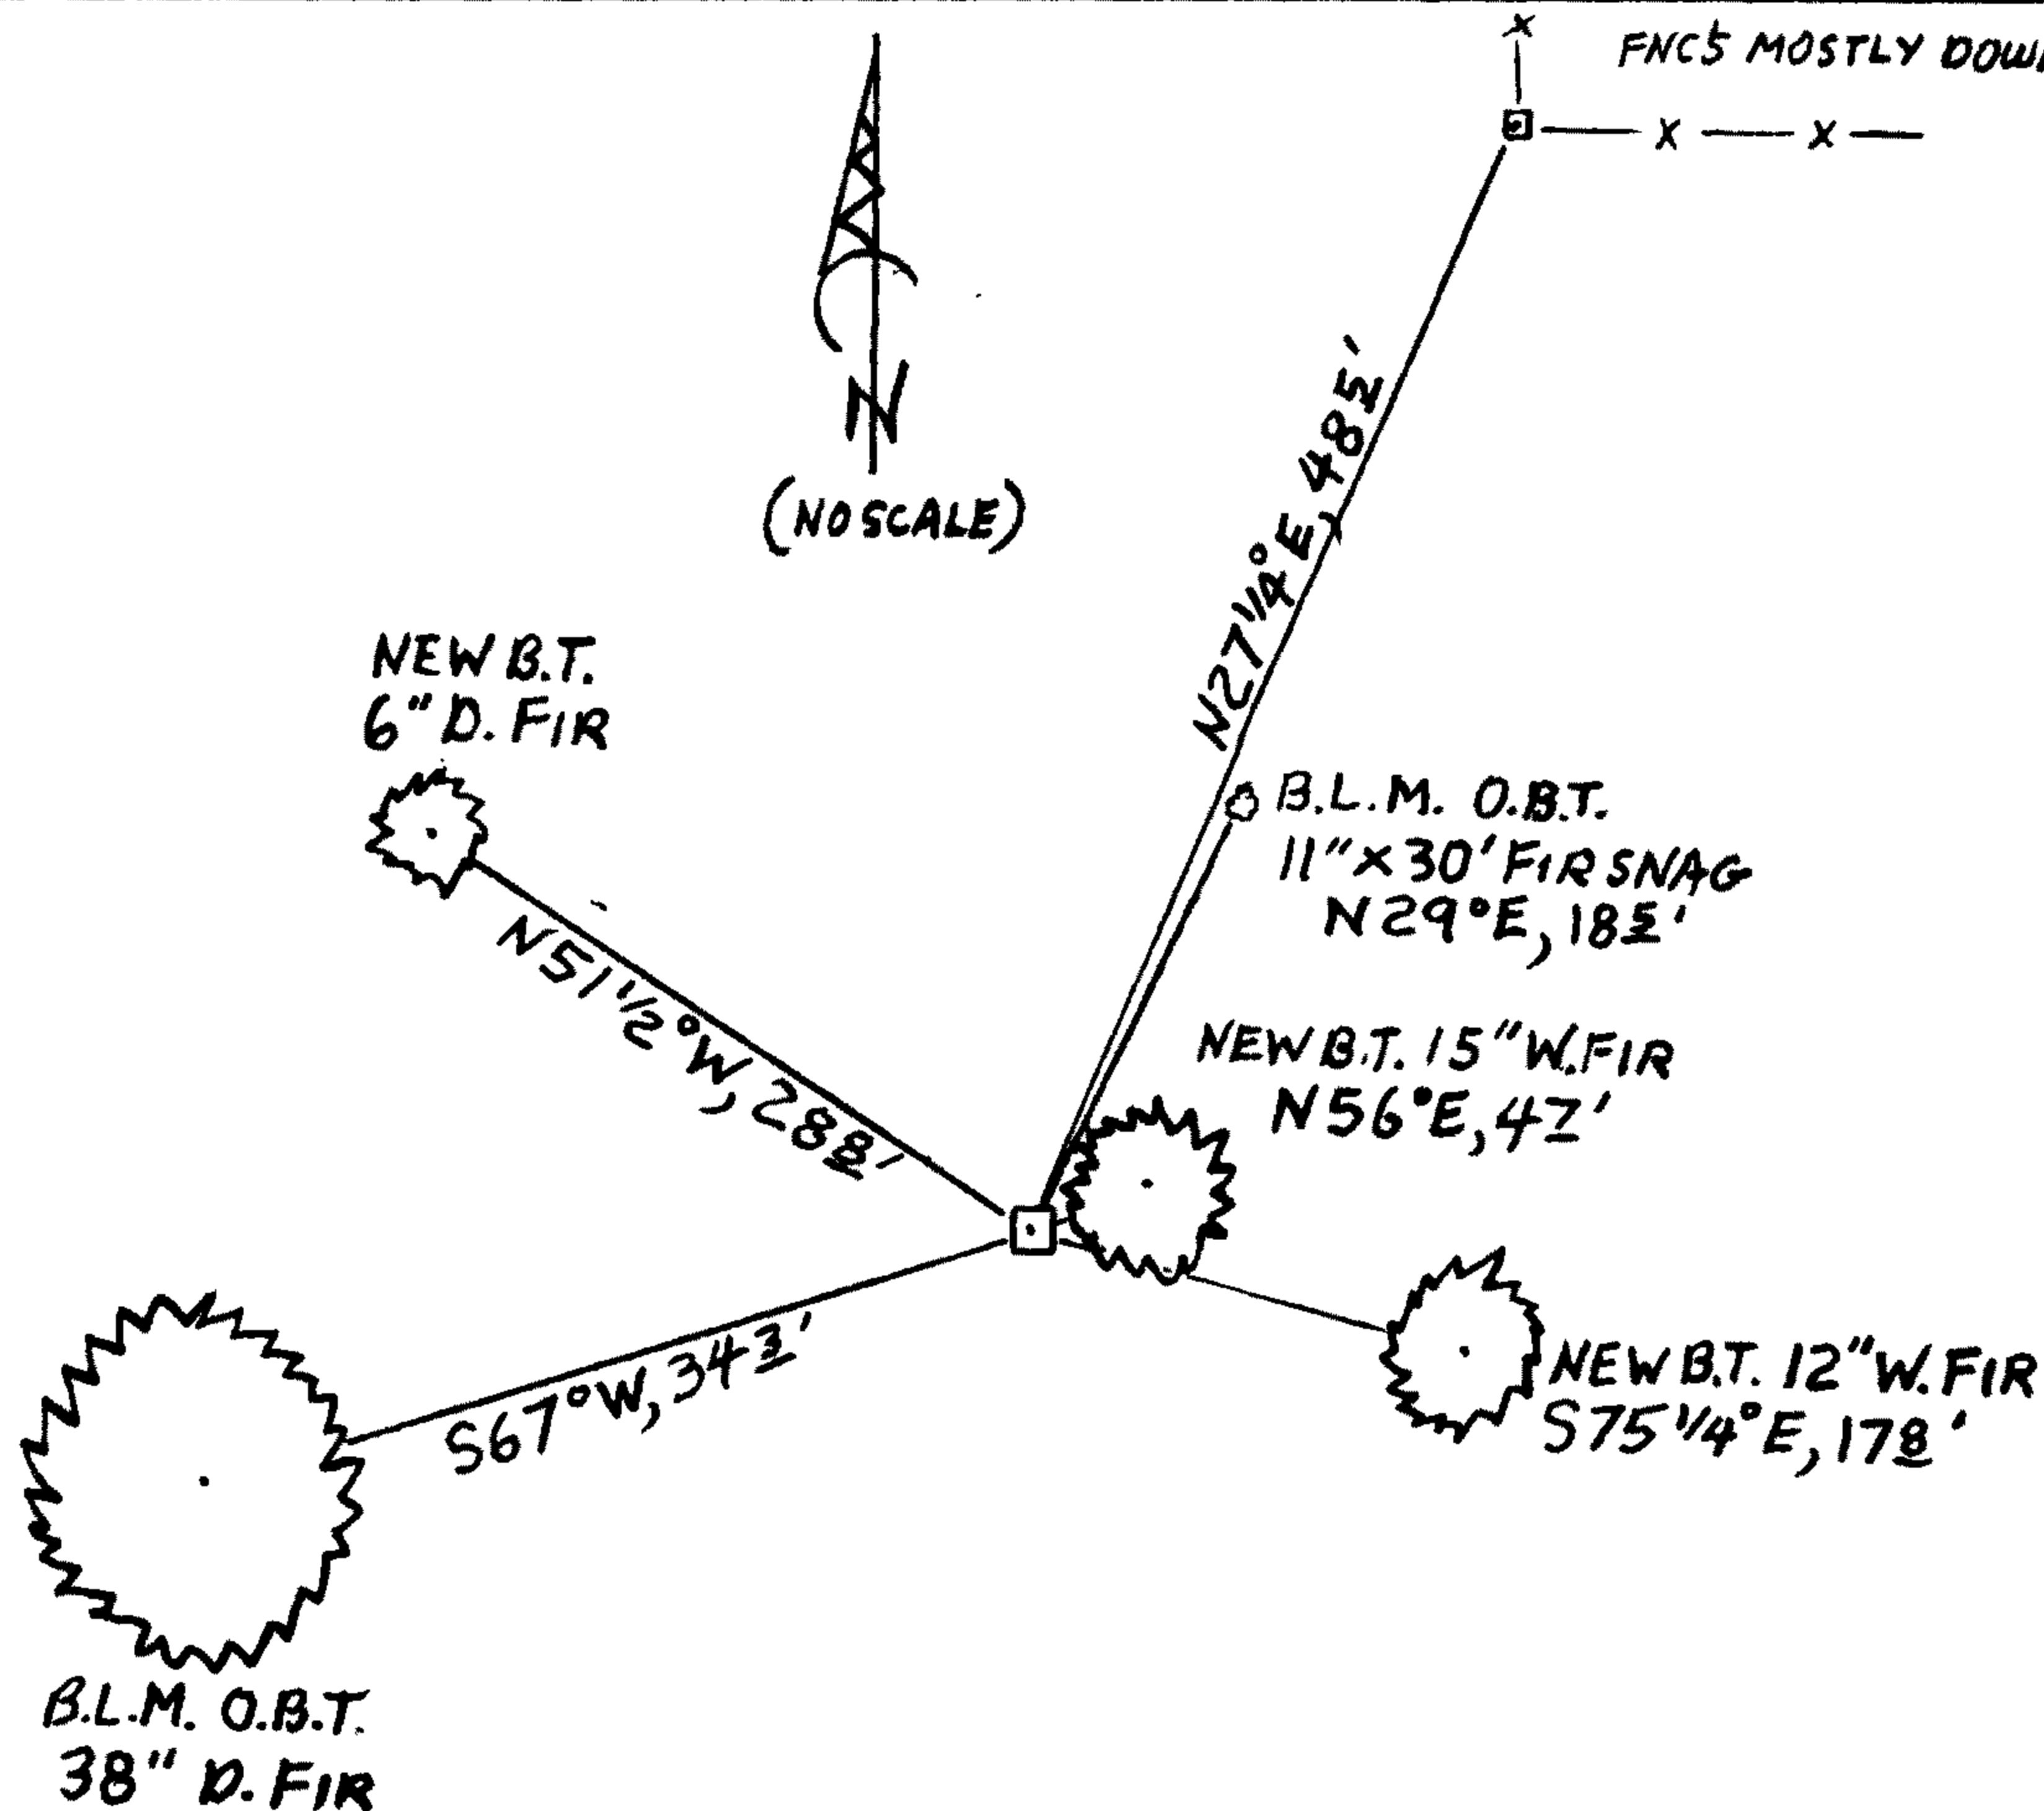

MONUMENT IS ON MODERATE NE'LY SLOPE IN MIXED FIR REPROD AND BRUSH. MONUMENT IS ABOUT 75 FEET EAST FROM A FOREST ACCESS ROAD.

Comp. Decline. 15 1/2°E
Agency D.C.S.O.
Party Chief STEPHEN JOHN FLAUSE
Note keeper Stephen John Flauser
Witnesses MIKE S. KOCH

Surveyor's Seal

REGISTERED PROFESSIONAL LAND SURVEYOR

Randall W. Smith

OREGON
JULY 25, 1990
RANDALL W. SMITH
2400

Renewal 6-30-2014