



Monument Set (Procedure and Description)

MONUMENT DETAIL

N/A

N/A

New Accessories

REMAINED 13T TAGS, FLAGGED MONUMENT AND ACCESSORIES


Sketch of Monument, Accessories, and General Area

Location & Comments


N/A

Comp. Decline. 15 1/2° E  
Agency DCSO  
Party Chief STEPHEN JOHN FLAUSE  
Note keeper Stephen John Flause  
Witnesses MIKE S. KOCH

Surveyor's Seal

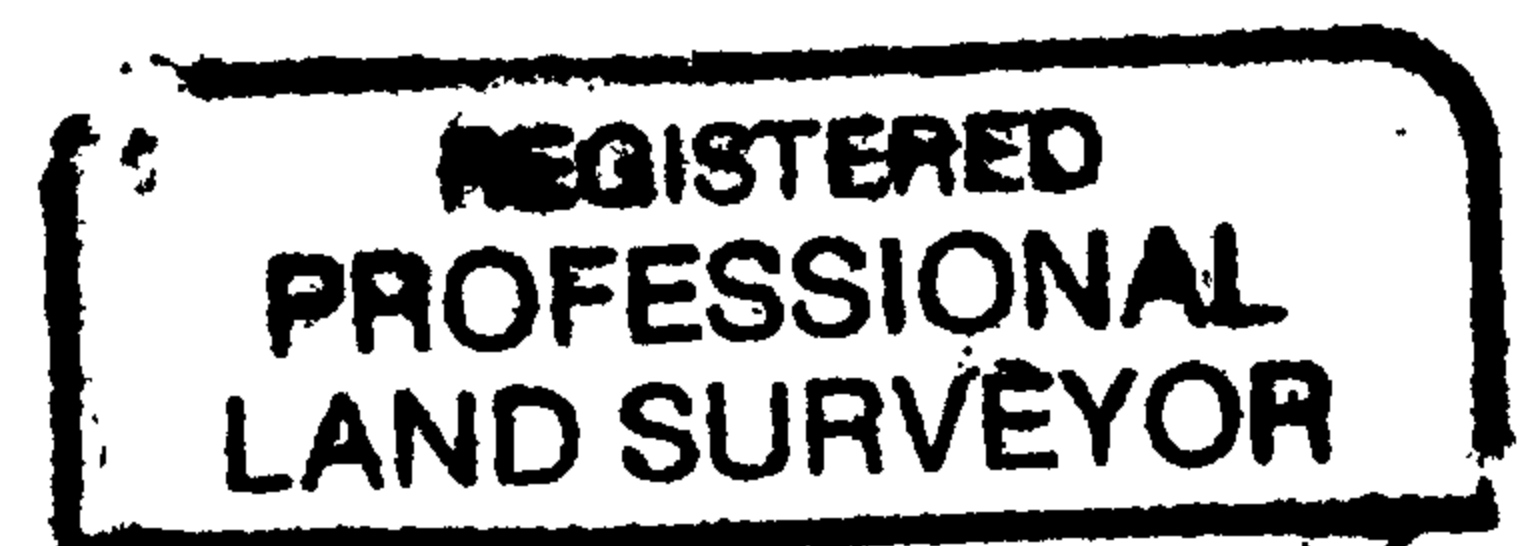

*Handwritten signature of Randall W. Smith*

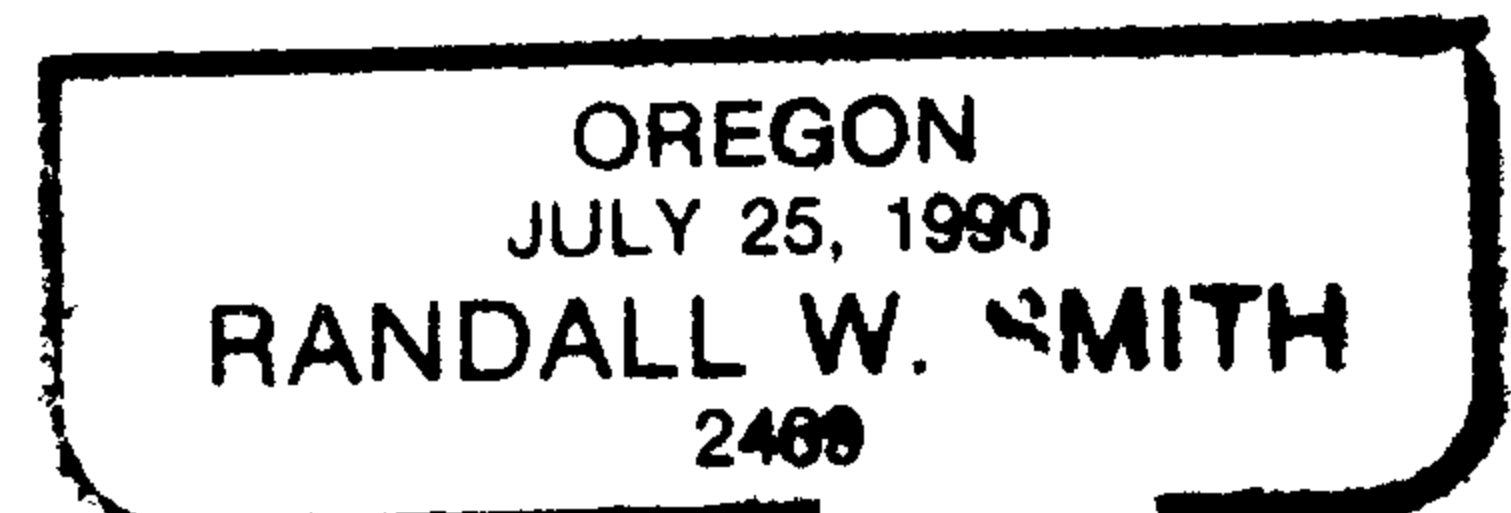

RENEWAL - 6-30-2014