

GOVERNMENT CORNER RESTORATION FORM

FILED

TOWNSHIP 28 S RANGE 05 W SEC. 32 PLSS # 240100

Date: 8-20-2013 By: JC

This survey consists of:

DOUGLAS COUNTY OREGON

DATE JULY 24, 2013

Map: _____

Narrative: _____

Corner Rpt: CS 67/38-49

DOUGLAS COUNTY SURVEYOR

Corner Designation

T 28 S
1/4 $\frac{S 32}{S 5}$ R 5 W
T 29 S

Previous Renewals EPPSTEIN (NO DATE), RESURVEY 1980
Monument(s) Found: (Condition and Source)

- Condition Report
- Not Found
- Renewed
- Unrecorded
- Surveyed In
- Referenced Out

FROM 1980 RUPPERT SURVEY THE REESTABLISHED CORNER,
A 2 1/2 INCH DIAMETER BRASS CAP (MARKED AS
AT RIGHT) ON A 1 INCH I.D. IRON PIPE IS FIRMLY
AND PLUMBLY SET. BRASS CAP IS 1 INCH BELOW
GROUND.

MONUMENT DETAIL

T 28 S
1/4 $\frac{S 32}{S 5}$ R 5 W
T 29 S
PLS 866
1980

Accessories Found

NO EVIDENCE OF ORIGINAL SW BEARING TREE REMAINS. A LARGE FALLEN AND ROTTED OAK
WITH NO BLAZE OR SCRIBE EVIDENCE IS FOUND IN VICINITY OF ORIGINAL NW BEARING TREE.

NO EVIDENCE OF EPPSTEIN'S ALDER RENEWAL B.T. REMAINS.

EVIDENCE OF THE TWO 1980 BEARING TREES
AN 8" W. OAK NOW A 23 INCH DIAM. WHITE OAK WITH BLAZING NO LONGER VISIBLE; BEARS
S 77° W 27² FEET DISTANT (AS PER RECORD).
AN 8" W. OAK NOW A 9 INCH DIAM. 2 FOOT TALL VERY ROTTED OAK STUMP WITH THE REMAINS
OF A PARTIALLY HEALED BLAZE SHOWING A SCRIBED "T"; BEARS N 21³/₄° E, 107¹/₂ FEET
DISTANT (AS PER RECORD).

Monument Set (Procedure and Description)

MONUMENT DETAIL

N/A N/A

New Accessories



TWO NEW BEARING TREES.

A 13 INCH DIAM. WHITE OAK SCRIBED "1/4 S 32 CS" "BT" ON A DOUBLE BLAZE; BEARS N13°E, 93^o FEET DISTANT.

A 20 INCH DIAM. MAPLE SCRIBED "1/4 S 32 CS" "BT" ON A DOUBLE BLAZE; BEARS N29°W, 8⁵ FEET DISTANT.

Sketch of Monument, Accessories, and General Area

Location & Comments

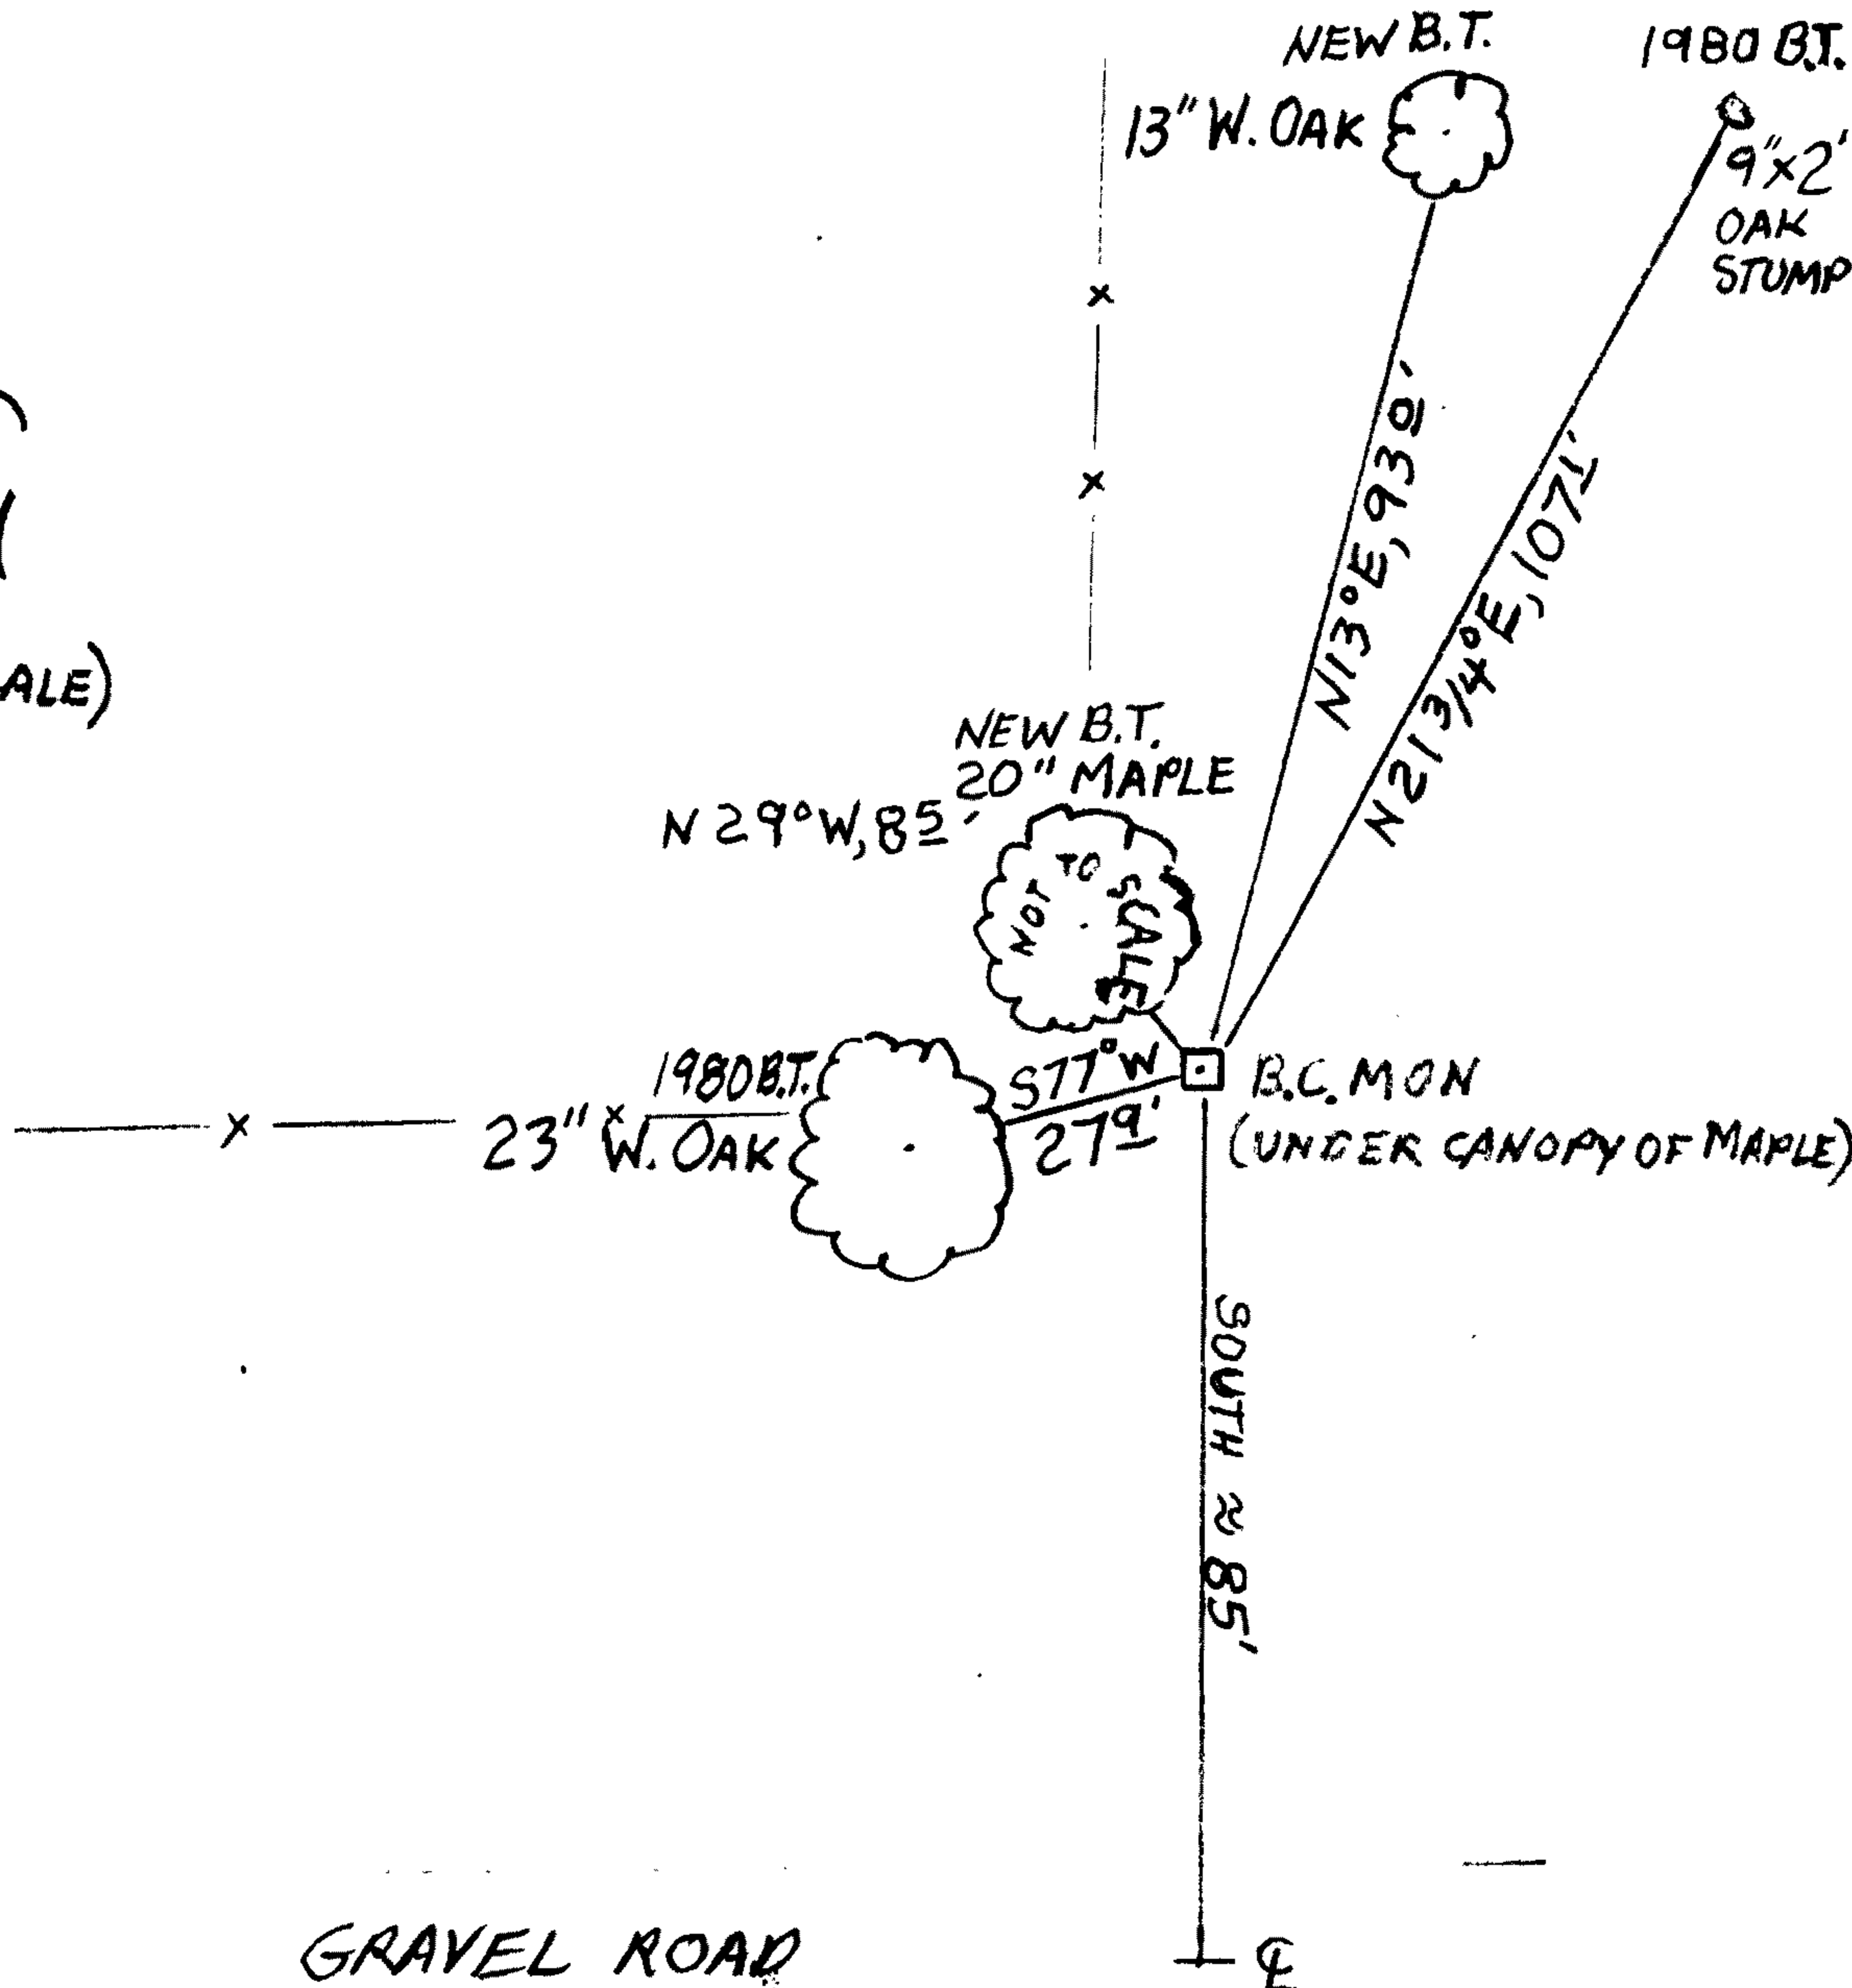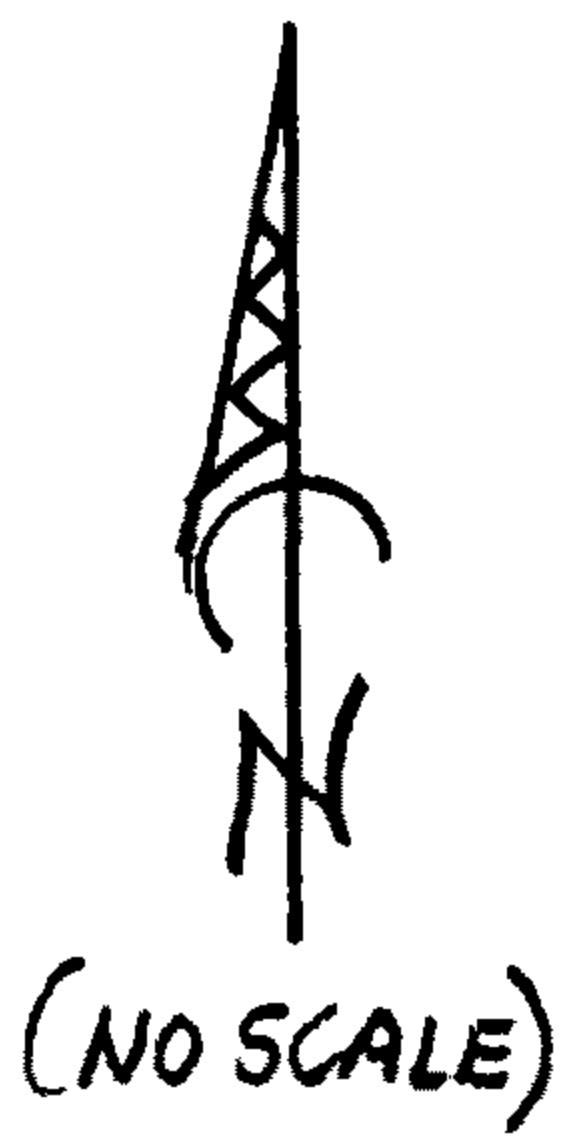

MONUMENT IS ON GENTLY SOUTH SLOPING GROUND AND JUST WEST OF A PLOWED FIELD.

Comp. Decline. 15 1/2° E
 Agency D.C.S.O.
 Party Chief STEPHEN JOHN FLOUSE
 Note keeper Stephen John FLOUSE
 Witnesses MIKE S. KOCH

Surveyor's Seal
 REGISTERED
 PROFESSIONAL
 LAND SURVEYOR

Handwritten signature: Randall W. Smith

OREGON
 JULY 25, 1990
 RANDALL W. SMITH
 2400

RENEWAL 6-30-2014