

GOVERNMENT CORNER RESTORATION FORM

FILED

TOWNSHIP 22 S RANGE 05 W SEC. 33 PLSS # 360140

Date: 8/20/2013 By: JK

This survey consists of:

DOUGLAS COUNTY OREGON

DATE AUG 5, 2013

Map: _____

Narrative: _____

Corner Rpt: CS 67138-51

Corner Designation

DOUGLAS COUNTY
SURVEYOR

C E 1/16 C

- _____ Condition Report
- _____ Not Found
- Renewed
- _____ Unrecorded
- _____ Surveyed In
- _____ Referenced Out

Previous Renewals NONE
Monument(s) Found: _____ (Condition and Source)

MONUMENT DETAIL

THE ORIGINAL 1983 BLM MONUMENT. A 3 1/4
INCH DIAMETER ALUMINUM CAP (MARKED AS A RIGHT)
ON A 2 1/2 INCH O.D. ALUMINUM PIPE, FIRMLY AND
PLUMBLY SET PROTRUDING 3 INCHES ABOVE GROUND.

DEPARTMENT OF INTERIOR

C E 1/16 C
533

CADASTRAL SURVEY
BUR. OF LAND MANAGEMENT

Accessories Found

EVIDENCE OF THE TWO ORIGINAL BEARING TREES.
A FIR, 8 INS. DIAM. NOW A 13 INCH DIAM. DOUGLAS FIR WITH A FULLY HEALED HIGH-LOW BLAZE;
BEARS N 9 3/4° E, 29 1/2 FEET DISTANT (RECORD N 9 3/4° E, 28 1/2 FEET).

A FIR, 11 INS. DIAM. NOW AN 11 INCH DIAM., 7 FOOT TALL, ROTTEN FIR STUMP WITH EVIDENCE IN BARK OF
PARTIALLY HEALED BLAZE, FACE IS ROTTED AWAY NO SCRIBING REMAINS. THIS TREE BEARS
BEARS S 45 1/2° E, 41 1/2 FEET DISTANT (AS PER RECORD).

N/A


N/A

New Accessories

A 6 INCH DIAM. DOUGLAS FIR SCRIBED "X" "CSBT" ON A HIGH-LOW BLAZE; BEARS S 48 3/4° E, 22 3/4 FEET DISTANT.

Sketch of Monument, Accessories, and General Area

Location & Comments

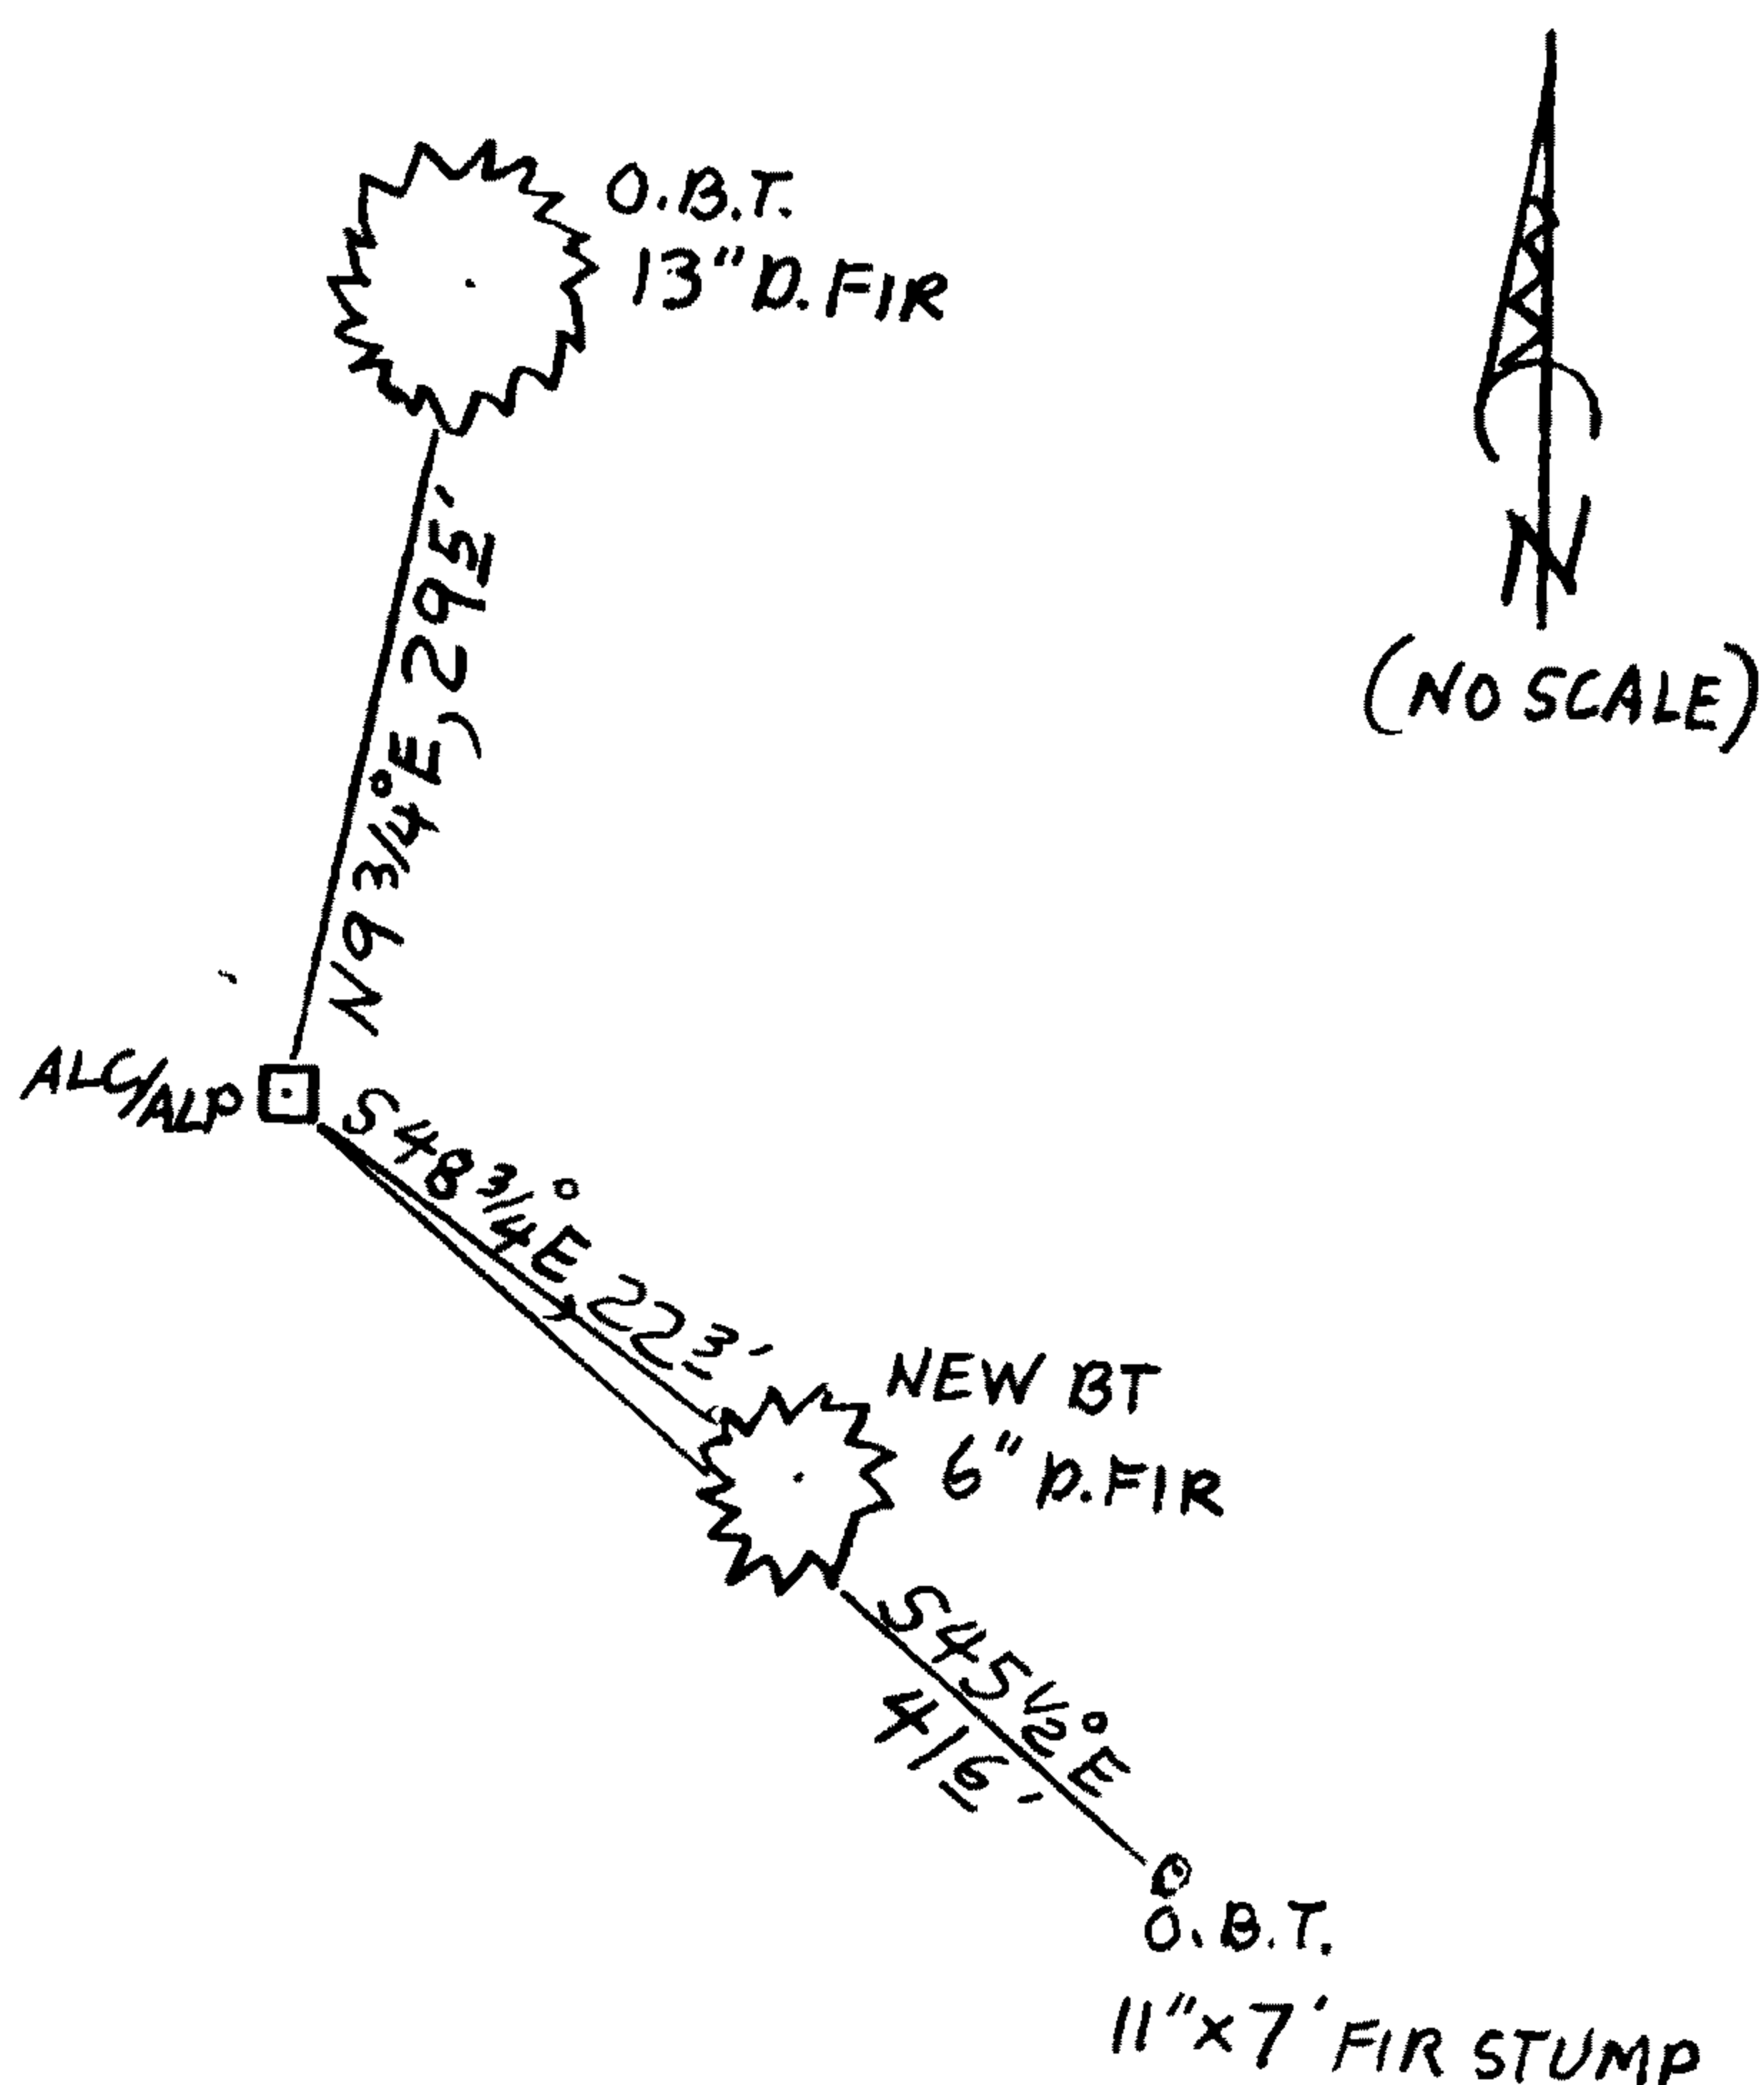

MONUMENT IS ON MODERATE NE SLOPE AND ON WESTERLY EDGE OF A SHALLOW RAVINE. MONUMENT IS IN OLDER REPROD FIR FOREST WITH SOME MAPLE, ALDER AND WILLOW.

Comp. Decline. 15 1/2° E
Agency D.C.S.O.
Party Chief STEPHEN JOHN FLAUSE
Note keeper Stephen John Flause
Witnesses MIKE S. KOCH

Surveyor's Seal

REGISTERED PROFESSIONAL LAND SURVEYOR

Handwritten signature

OREGON
JULY 25, 1990
RANDALL W. SMITH
2400

Revised 6-14-2013