

GOVERNMENT CORNER RESTORATION FORM

FILED

TOWNSHIP 30S RANGE 06W SEC. 26 PLSS # 042010

Date: 10-16-2013 By: SC

This survey consists of:

DOUGLAS COUNTY OREGON

DATE SEPT 18, 2013

Map: _____

Narrative: _____

Corner Designation

Corner Rpt: CS 67/40-7

DOUGLAS COUNTY SURVEYOR

NNE
DLC 42

- ___ Condition Report
- ___ Not Found
- ___ Renewed
- ___ Unrecorded
- ___ Surveyed In
- ___ Referenced Out

Previous Renewals 1910, 1947
Monument(s) Found: _____ (Condition and Source)

MONUMENT DETAIL

FROM THE 1947 RENEWAL A 2 1/2 INCH DIAMETER BRASS CAP (MARKED AS AT RIGHT) ON A 1 INCH I.D. IRON PIPE IS SET PLUMB WITH TOP OF BRASS CAP 13 INCHES BELOW GROUND SURFACE.

COUNTY SURVEYORS

ALSO A 1 INCH DIAM IRON PIPE (OF UNKNOWN ORIGIN) SET PLUMB WITH TOP OF PIPE 2 INCHES BELOW GROUND SURFACE; BEARS S60°W, 0³⁵ FEET FROM ABOVE NOTED B.C. MONUMENT. THIS PIPE WAS IDENTIFIED AS THE D.L.C. CORNER IN A SURVEY FILED AS M119-68 IN THE D.C.S.O. RECORDS.

SE
DLC
44
OFFICE

Accessories Found

NO EVIDENCE OF O.B.T.S

TWO 1947 RENEWAL BEARING TREES:
A 10" ASH NOW A 25 INCH DIAM. ASH WITH A FULLY HEALED DOUBLE BLAZE IS NOW PART OF A TRIPLE TRUNK ASH; THE ROOT CROWN OF WHICH BEARS S10 3/4° W, 107 1/2 FEET DISTANT (RECORD S10°W, 107° FEET IS GOOD TO BASE OF SCRIBED TRUNK).
A 16" ASH NOW A 25 INCH DIAM. ASH WITH A PARTIALLY HEALED DOUBLE BLAZE (SCRIBING NO LONGER VISIBLE) IS NOW PART OF A DOUBLE TRUNK ASH; THE ROOT CROWN OF WHICH BEARS N84°E, 117 1/2 FEET DISTANT (RECORD N83 1/2°E, 117 1/2 FEET IS GOOD TO BASE OF SCRIBED TRUNK).

Monument Set (Procedure and Description)

MONUMENT DETAIL

N/A

N/A


New Accessories

A 23 INCH DIAMETER WHITE OAK SCRIBED "NNE DLC 42 CS" "BT" ON A DOUBLE BLAZE; BEARS S41 3/4° E, 154 6 FEET DISTANT.

A 5/8 INCH DIAM. IRON ROD SET PLUMB WITH TOP FLUSH WITH GROUND SURFACE (SEE DETAIL OF SURVEY M119-68); BEARS S22 3/4° W, 140 9 FEET DISTANT.

Sketch of Monument, Accessories, and General Area

Location & Comments

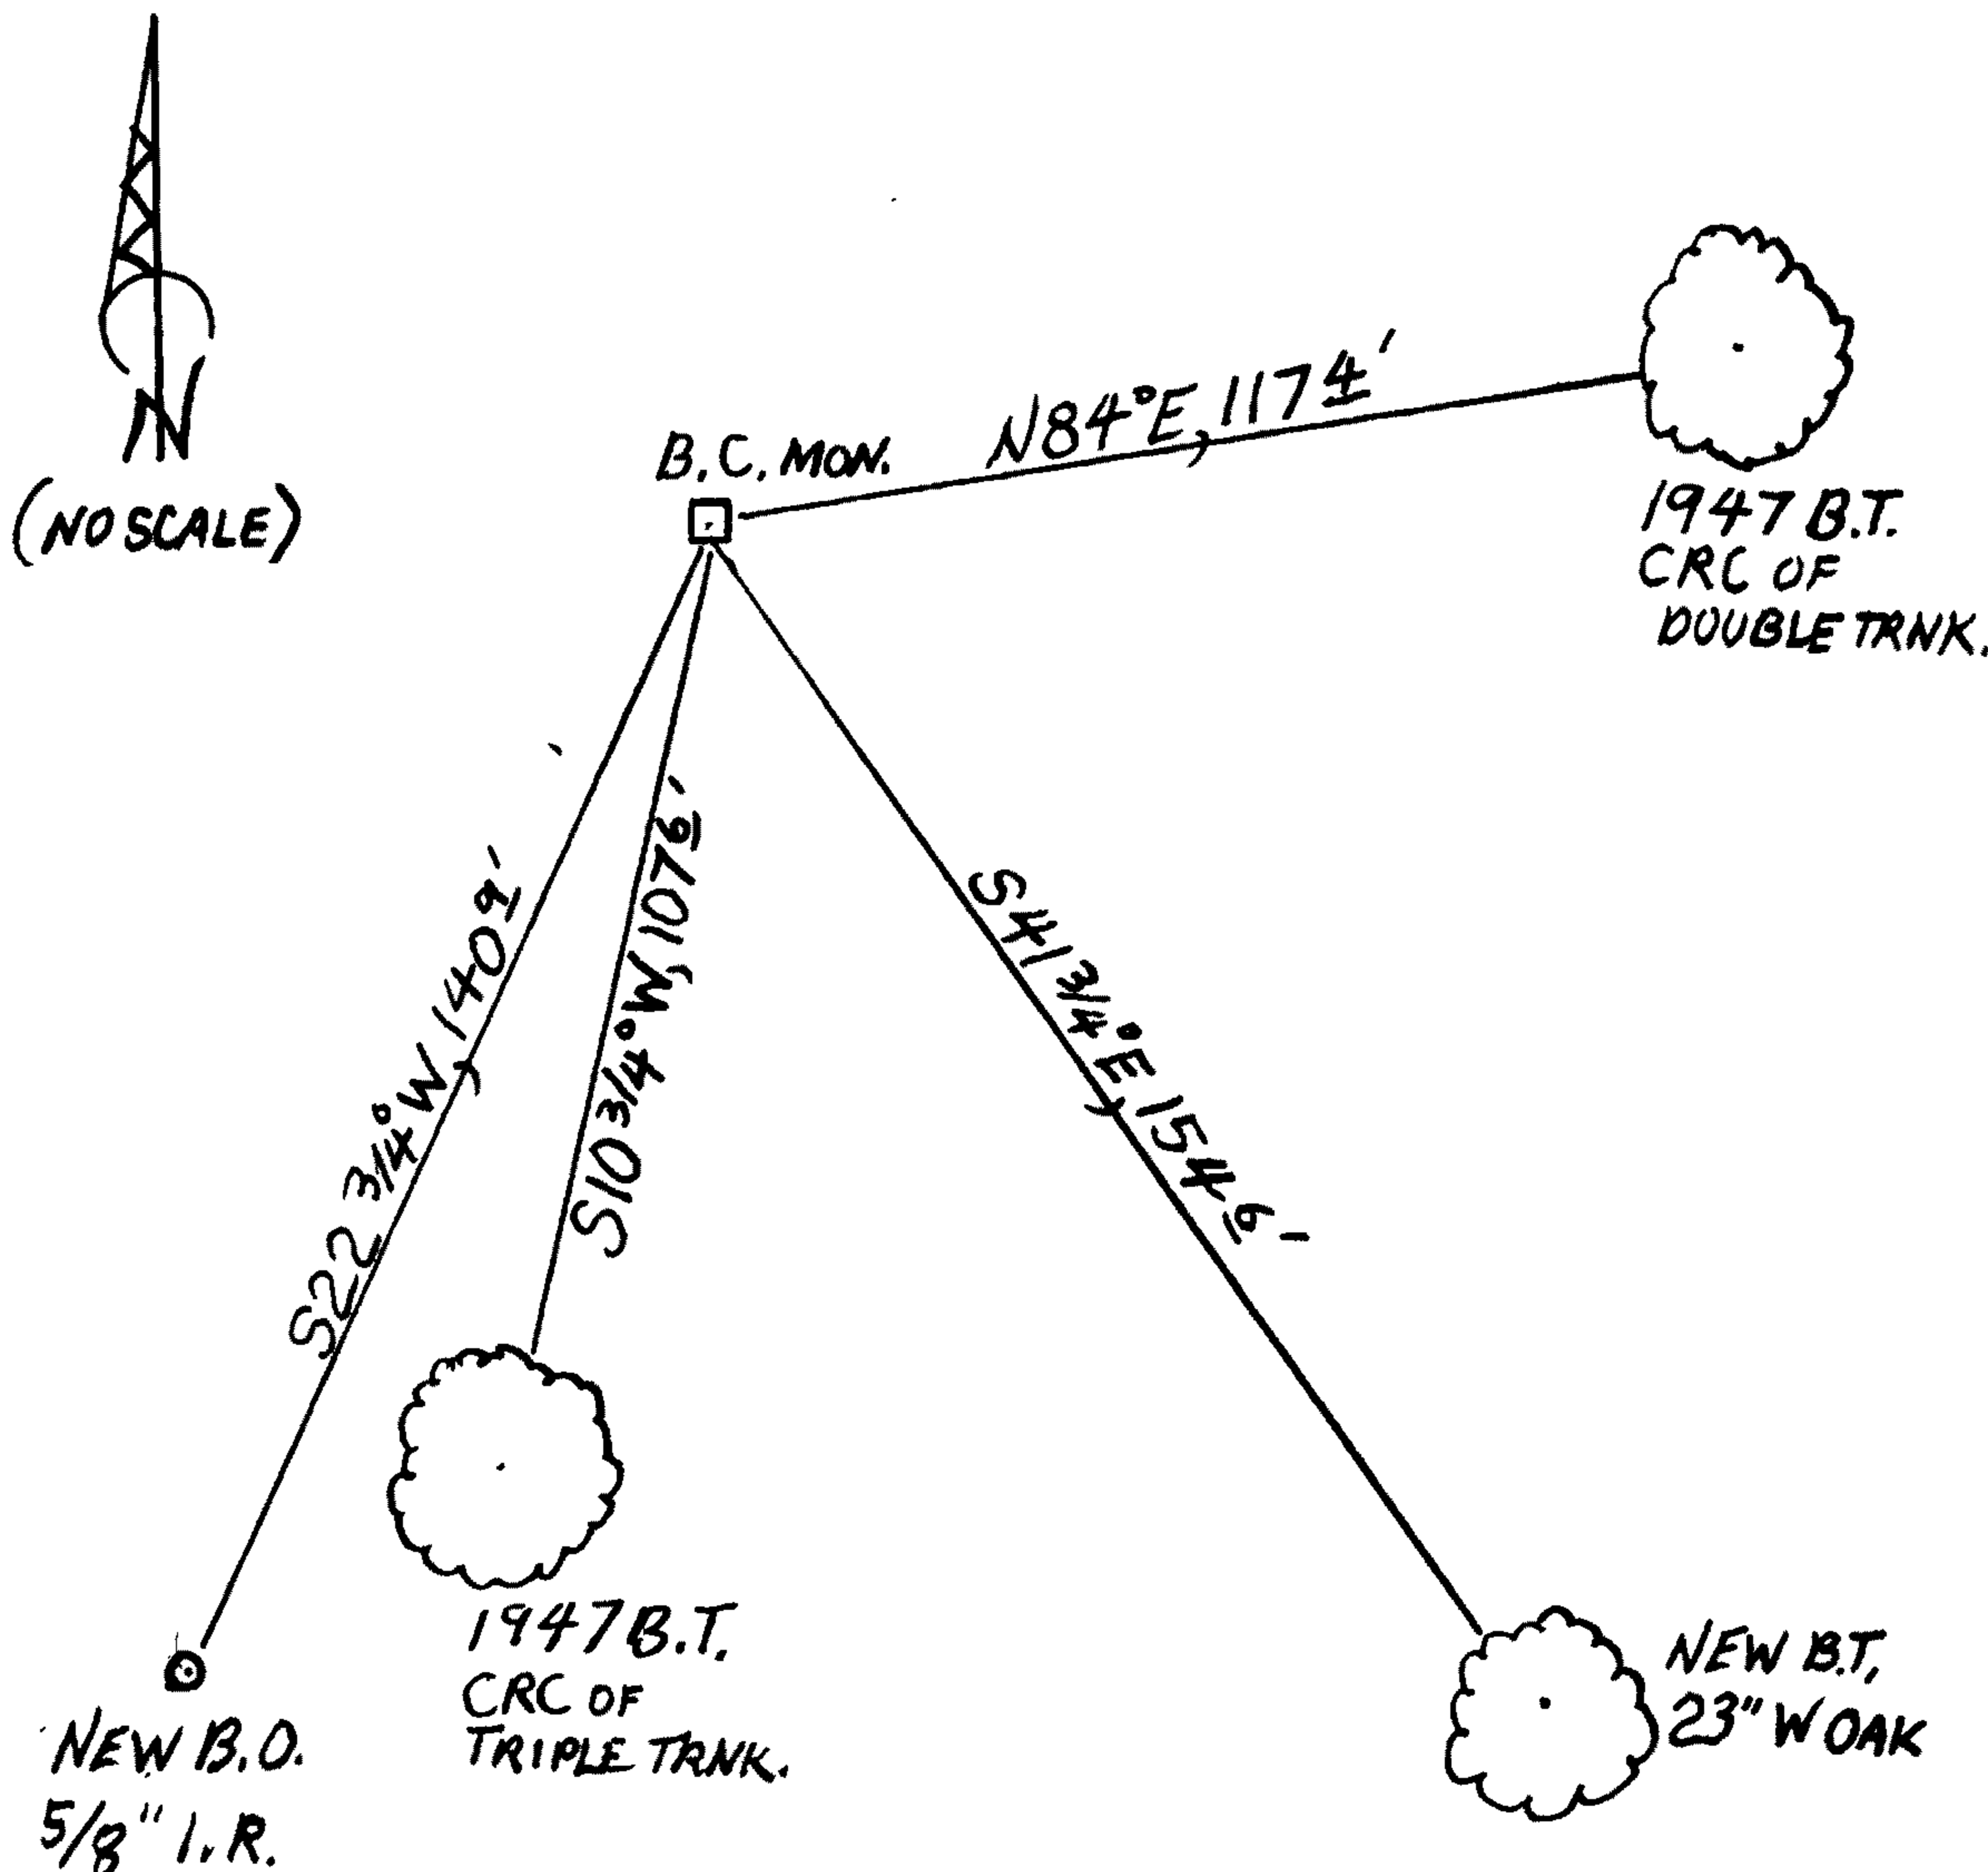

MONUMENT IS IN FLAT OPEN PASTURE WITH SCATTERED ASH AND SOME OAK TREES. A WOOD POST AND ELECTRIC WIRE FENCE RUNNING N-S IS WEST ≈ 60 FT. FROM THE CORNER.

Comp. Decline. 15 1/2° E
Agency D. C. S. O.
Party Chief STEPHEN JOHN FLAISE
Note keeper Stephen John Flaiss
Witnesses MIKE S. KOCH

Surveyor's Seal
REGISTERED
PROFESSIONAL
LAND SURVEYOR

Randall W. Smith
OREGON
JULY 25, 1990
RANDALL W. SMITH
2468

RENEWAL 6-30-2014