

GOVERNMENT CORNER RESTORATION FORM

FILED

TOWNSHIP 32 S RANGE 08 W SEC. 23 PLSS # 600300

Date: 11/12/2013 By: DC  
This survey consists of:

DOUGLAS COUNTY OREGON

DATE OCTOBER 29, 2013

Map: \_\_\_\_\_

Corner Designation

Narrative: \_\_\_\_\_  
Corner Rpt: CS 67/40-17

DOUGLAS COUNTY  
SURVEYOR

- \_\_\_\_\_ Condition Report
- \_\_\_\_\_ Not Found
- Renewed
- \_\_\_\_\_ Unrecorded
- \_\_\_\_\_ Surveyed In
- \_\_\_\_\_ Referenced Out

S23	S24
S26	S25

Previous Renewals 1968  
Monument(s) Found: \_\_\_\_\_ (Condition and Source)

THE 1968 RENEWAL MONUMENT: A 2 1/2 INCH DIAMETER BRASS CAP (MARKED AS AT RIGHT) ON A 1 INCH I.D. IRON PIPE PROTRUDING 5 INCHES FROM A ROUGH MOUND OF STONE.

MONUMENT DETAIL

COUNTY SURVEYORS OFFICE

T 32 S R 8 W

S23	S24
S26	S25
1968	

Accessories Found

EVIDENCE OF TWO ORIGINAL B.T.'S  
A FIR 40" DIA. NOW A 72 INCH DIAMETER DOUGLAS FIR WITH THE REMAINS OF THE 1968 BARK RE-SCRIBING "T 32 S R 8 W" (REST OF RECORD SCRIBING IS BURNED OFF DUE TO RECENT FIRE). THIS TREE BEARS N. 50° E, 19.8 FEET DISTANT (AS PER RECORD).  
A FIR 40" DIA. NOW AN APPROX. 24 INCH DIAM., 3 FOOT TALL BROKEN AND BURNED FIR STUMP WITH NO BLAZING OR SCRIBING REMAINING; BEARS S 34° E, 19.8 FEET DISTANT (ORIGINAL RECORD S 30° E, 21.2 FEET COULD BE TO ORIGINAL FACE OF THIS PISTOL BUTT STUMP). NO EVIDENCE OF ORIGINAL SW AND NW BEARING TREES REMAINS.

THE TWO 1968 RENEWAL BEARING TREES.  
A 10" D. FIR NOW A 19 INCH DIAM. DOUGLAS FIR WITH A FULLY HEALED DOUBLE BLAZE; BEARS S 26° W, 45.2 FEET DISTANT (AS PER RECORD).  
A 24" D. FIR NOW A DEAD AND BURNED 35 INCH DIAM. APPROX 70 FOOT TALL DOUGLAS FIR SNAG SHOWING A PARTIAL BLAZE SCAR BUT WITH FACE AND SCRIBING BURNED AWAY; BEARS S 80 1/2° E, 47.8 FEET DISTANT (RECORD S 85° E, 47.8). NO EVIDENCE OF A TREE EVER AT RECORD BEARING, PROBABLY AN ERROR IN NOTES.

C.S. File 67/40-17

RENEWAL

Monument Set (Procedure and Description)

MONUMENT DETAIL

ROUGH STONE MOUND IS BUILT UP AND REINFORCED. B.C. MONUMENT NOW PROTRUDES 3 INCHES ABOVE STONES.

N/A


New Accessories

A 9 INCH DIAM. MAPLE SCRIBED "SW 24 BT" ON A LOW BLAZE (REST OF TRUNK TOO GNARLED TO SCRIBE); BEARS N15°E, 40' FEET DISTANT.

A DOUBLE TRUNK LIVE OAK, THE MOST NORTHERLY 10 INCH DIAM. TRUNK OF WHICH IS SCRIBED "BT" ON A LOW BLAZE. THE C.R.C. OF THE DOUBLED TRUNK BEARS S 37 1/2° W, 34' FEET DISTANT. THE SCRIBED TRUNK HAS AN ALUMINUM CORNER LOCATION TAG WITH THE MARKS "2 A" SCRATCHED ON ITS SURFACE. THE TAG IS GROWN INTO TREE APPROX. 4 1/2 FEET ABOVE GROUND.

Sketch of Monument, Accessories, and General Area

Location & Comments

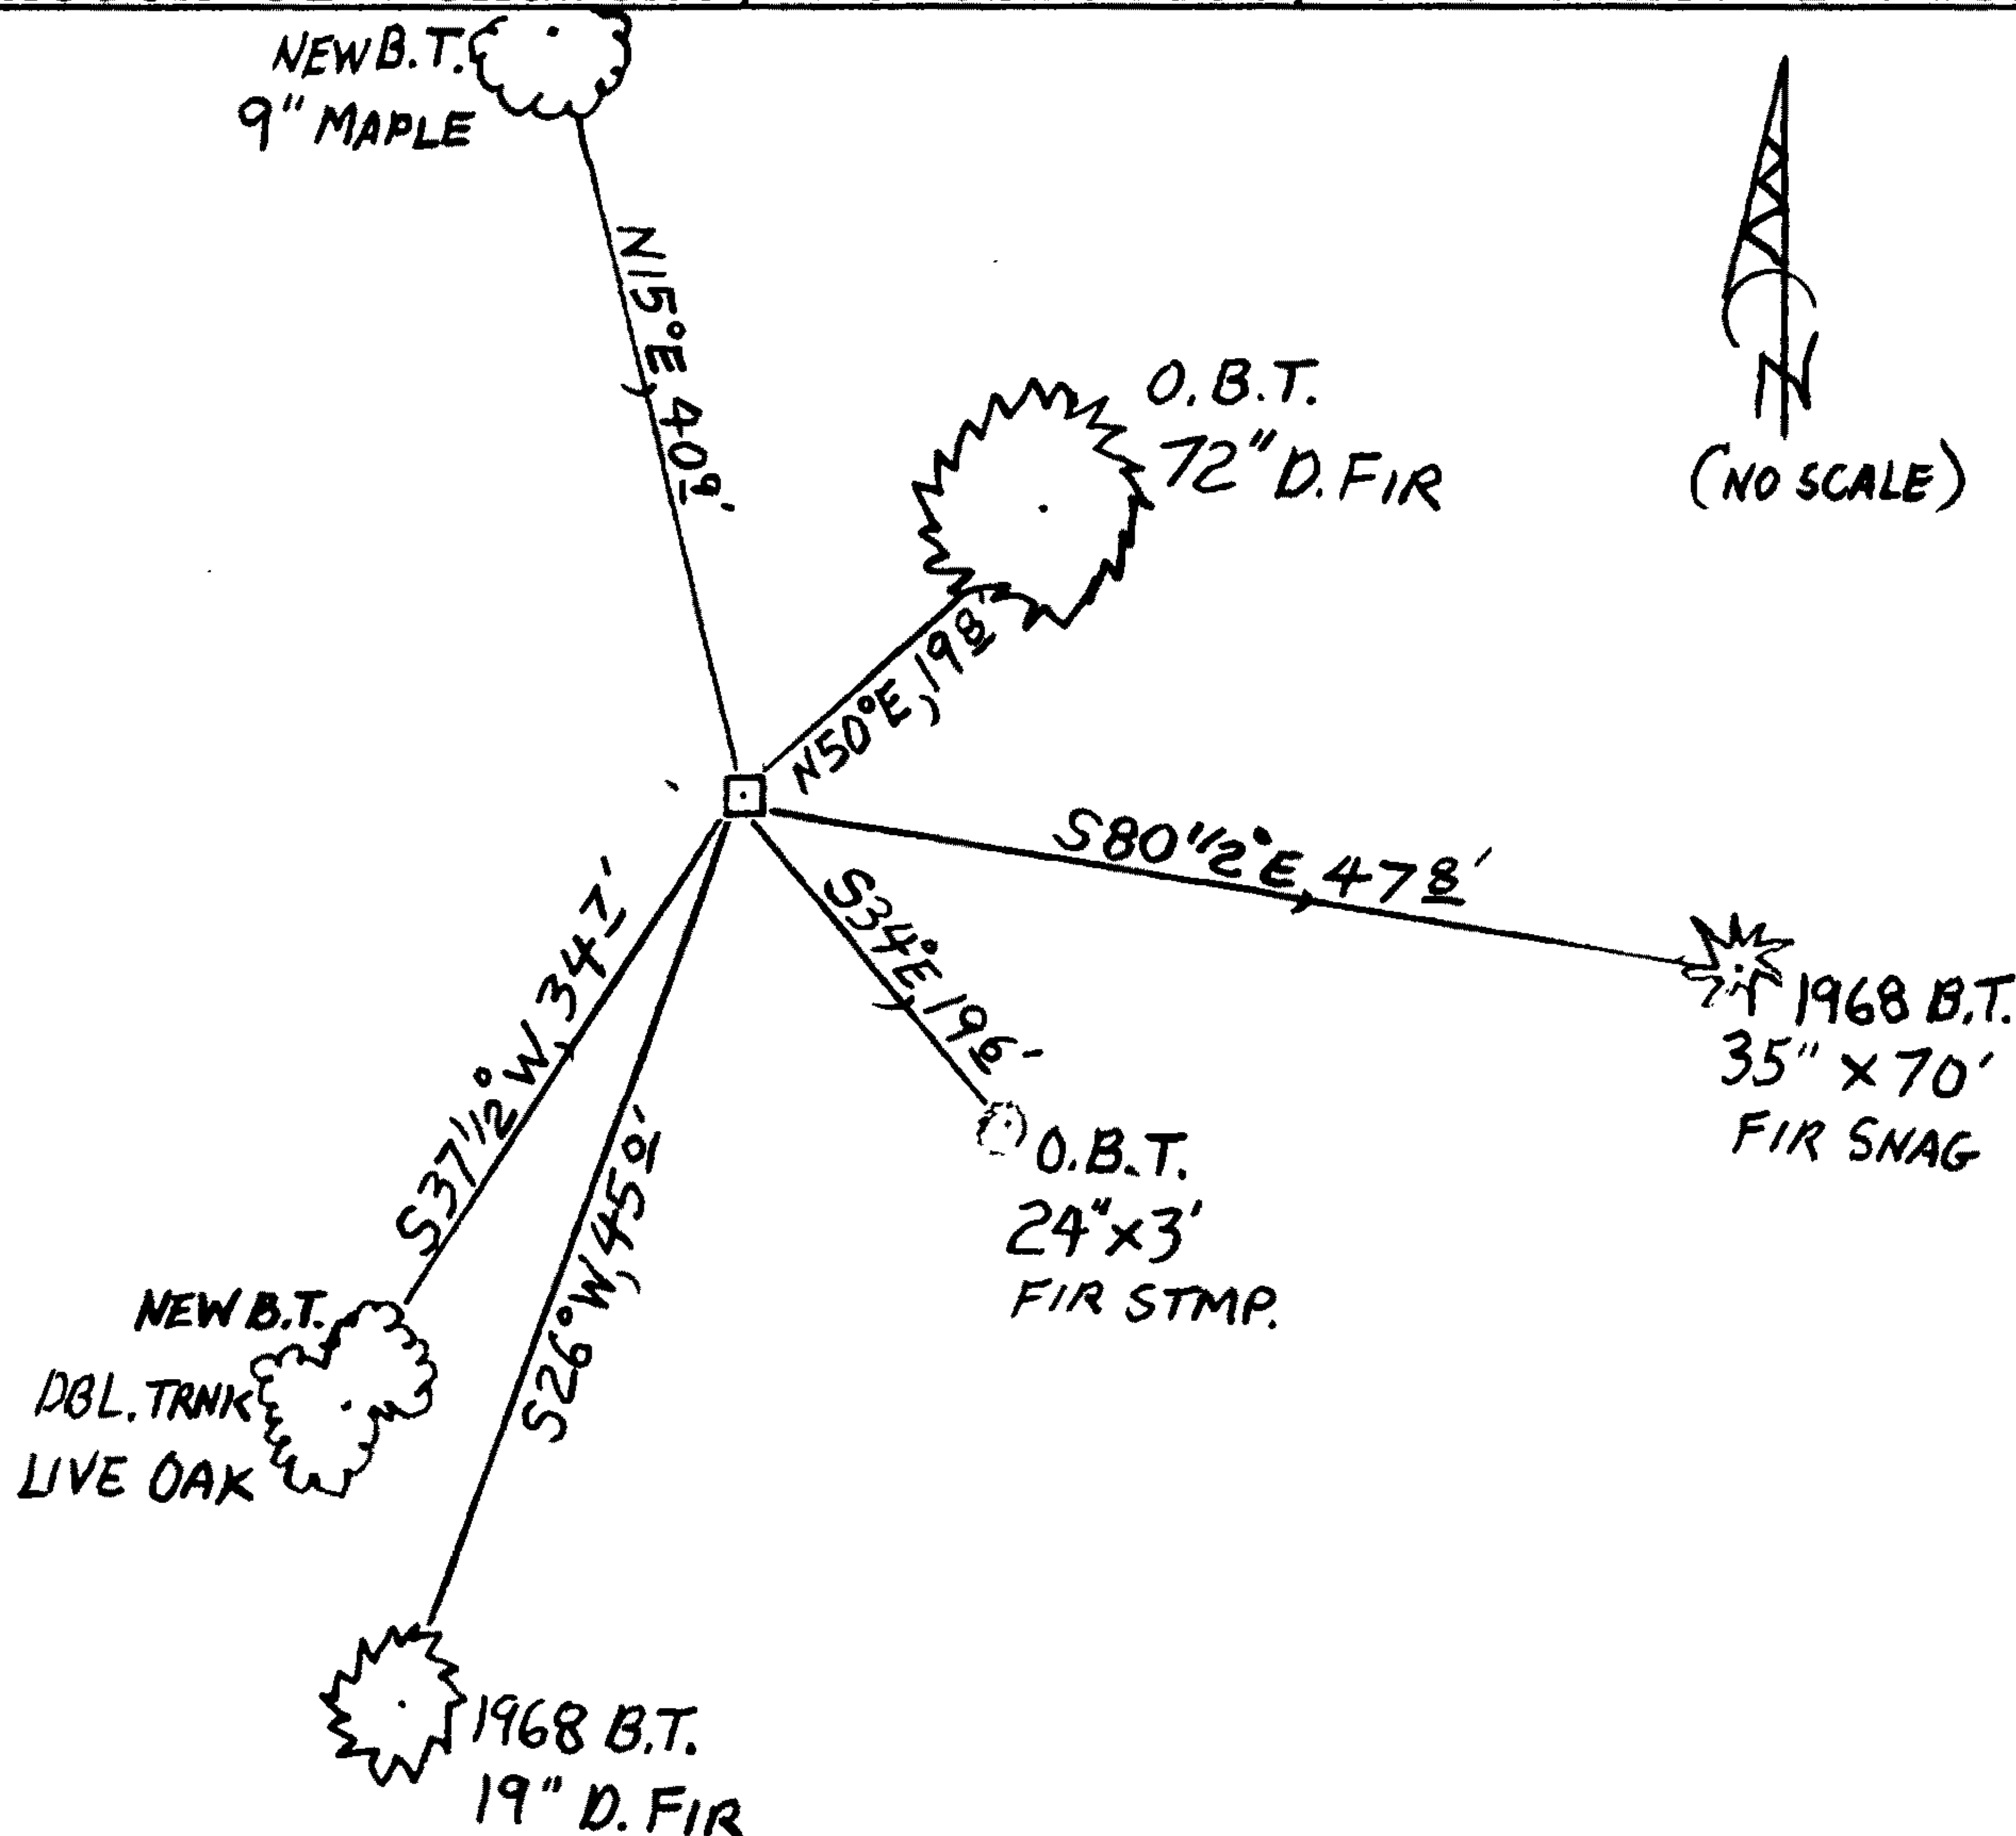

MONUMENT IS ON VERY STEEP AND ROCKY NW SLOPE IN AN OPEN AND RECENTLY BURNED FOREST OF FIR, OAK AND MAPLE.

Comp. Decline. 15 1/2° E  
Agency D.C.S.O.  
Party Chief STEPHEN JOHN FLAUSE  
Note keeper Stephen John Flause  
Witnesses MIKE S. KOCH

Surveyor's Seal

REGISTERED PROFESSIONAL LAND SURVEYOR

Randall W. Smith  
6-30-2014

OREGON  
JULY 25, 1990  
RANDALL W. SMITH  
2400

567/40-17