

GOVERNMENT CORNER RESTORATION FORM

FILED

TOWNSHIP 24S RANGE 04W SEC. 28 PLSS # 045050

Date: 1-7-2014 By: SC

This survey consists of:

DOUGLAS COUNTY OREGON

DATE DEC. 4, 2013

Map: _____

Narrative: _____

Corner Rpt: CS 67/41-3

Corner Designation

DOUGLAS COUNTY SURVEYOR

INT SE
DLC 45

- _____ Condition Report
- _____ Not Found
- Renewed
- _____ Unrecorded
- _____ Surveyed In
- _____ Referenced Out

Previous Renewals 1963
Monument(s) Found: _____ (Condition and Source)

MONUMENT DETAIL

FROM THE 1963 RENEWAL A 2 1/2 INCH DIAMETER BRASS CAP (MARKED AS AT RIGHT) ON A 1 INCH I.D. IRON PIPE PROTRUDING 10 INCHES ABOVE GROUND

COUNTY SURVEYORS OFFICE

T. 24 S.

INT. L. COR.

D.L.C. | 45

R. 4 W.

1963

Accessories Found

EVIDENCE OF THE TWO D.B.T.S'
AN OAK 18" DIA. NOW A ROTTEN AND FALLEN OAK 16 INCHES DIA. WITH A PREVIOUSLY OPENED SINGLE BLAZE (NO EVIDENCE OF 1963 FOUND SCRIBING REMAINS), THE STILL INTACT CENTER OF ROOT-CROWN OF THIS TREE BEARS N 70° E, 198 FEET DISTANT (AS PER RECORD).
AN OAK 18" DIA. NOW A 3 1/4 INCH DIA. WHITE OAK BEARS S 63° E, 117 1/2 FEET DISTANT (AS PER 1963 RECORD). THIS TREE HAS EVIDENCE OF A PREVIOUSLY OPENED BLAZE, BUT THE FACE AND SCRIBING SEEN IN 1963 ARE ROTTED AWAY.
TWO 1963 BEARING TREES.
AN 11" W. OAK NOW A FALLEN AND PARTLY ROTTEN 15 INCH DIA. WHITE OAK WITH A FULLY HEALED DOUBLE BLAZE THE ROOT-HOLE OF WHICH BEARS N 24° W, 5° FEET DISTANT (AS PER RECORD).
A 10" W. OAK NOW A DOUBLE TRUNK WHITE OAK THE SCRIBED TRUNK OF WHICH NOW SHOWS A FULLY HEALED DOUBLE BLAZE AND IS 11 INCHES IN DIA. THE ROOT-CROWN OF THE SCRIBED TRUNK BEARS S 29° E, 195 FEET DISTANT (AS PER RECORD). THE CENTER OF NOW DOUBLE TRUNK ROOT-CROWN BEARS S 27 1/4° E, 20 1/2 FEET DISTANT.

C.S. File 67/41-3

Monument Set (Procedure and Description)

MONUMENT DETAIL

N/A

N/A

New Accessories


A 13 INCH DIAM. WHITE OAK SCRIBED "INTL DLC 45 CS" "BT" ON A DOUBLE BLAZE BEARS N60 1/2° E, 32 1/2 FEET DISTANT.

AN 11 INCH DIAM. DOUGLAS FIR SCRIBED "INTL DLC 45 CS" "BT" ON A DOUBLE BLAZE BEARS S54° W, 19 1/2 FEET DISTANT.

A DOUBLE TRUNK WHITE OAK THE 13 INCH DIAM. MOST SOUTHERLY TRUNK OF WHICH IS SCRIBED "INTL DLC 45" "CS BT" ON A DOUBLE BLAZE. THE CENTER OF THE ROOT-CROWN OF THE DOUBLE TRUNK BEARS N14° W, 19 1/2 FEET DISTANT.

Sketch of Monument, Accessories, and General Area

Location & Comments

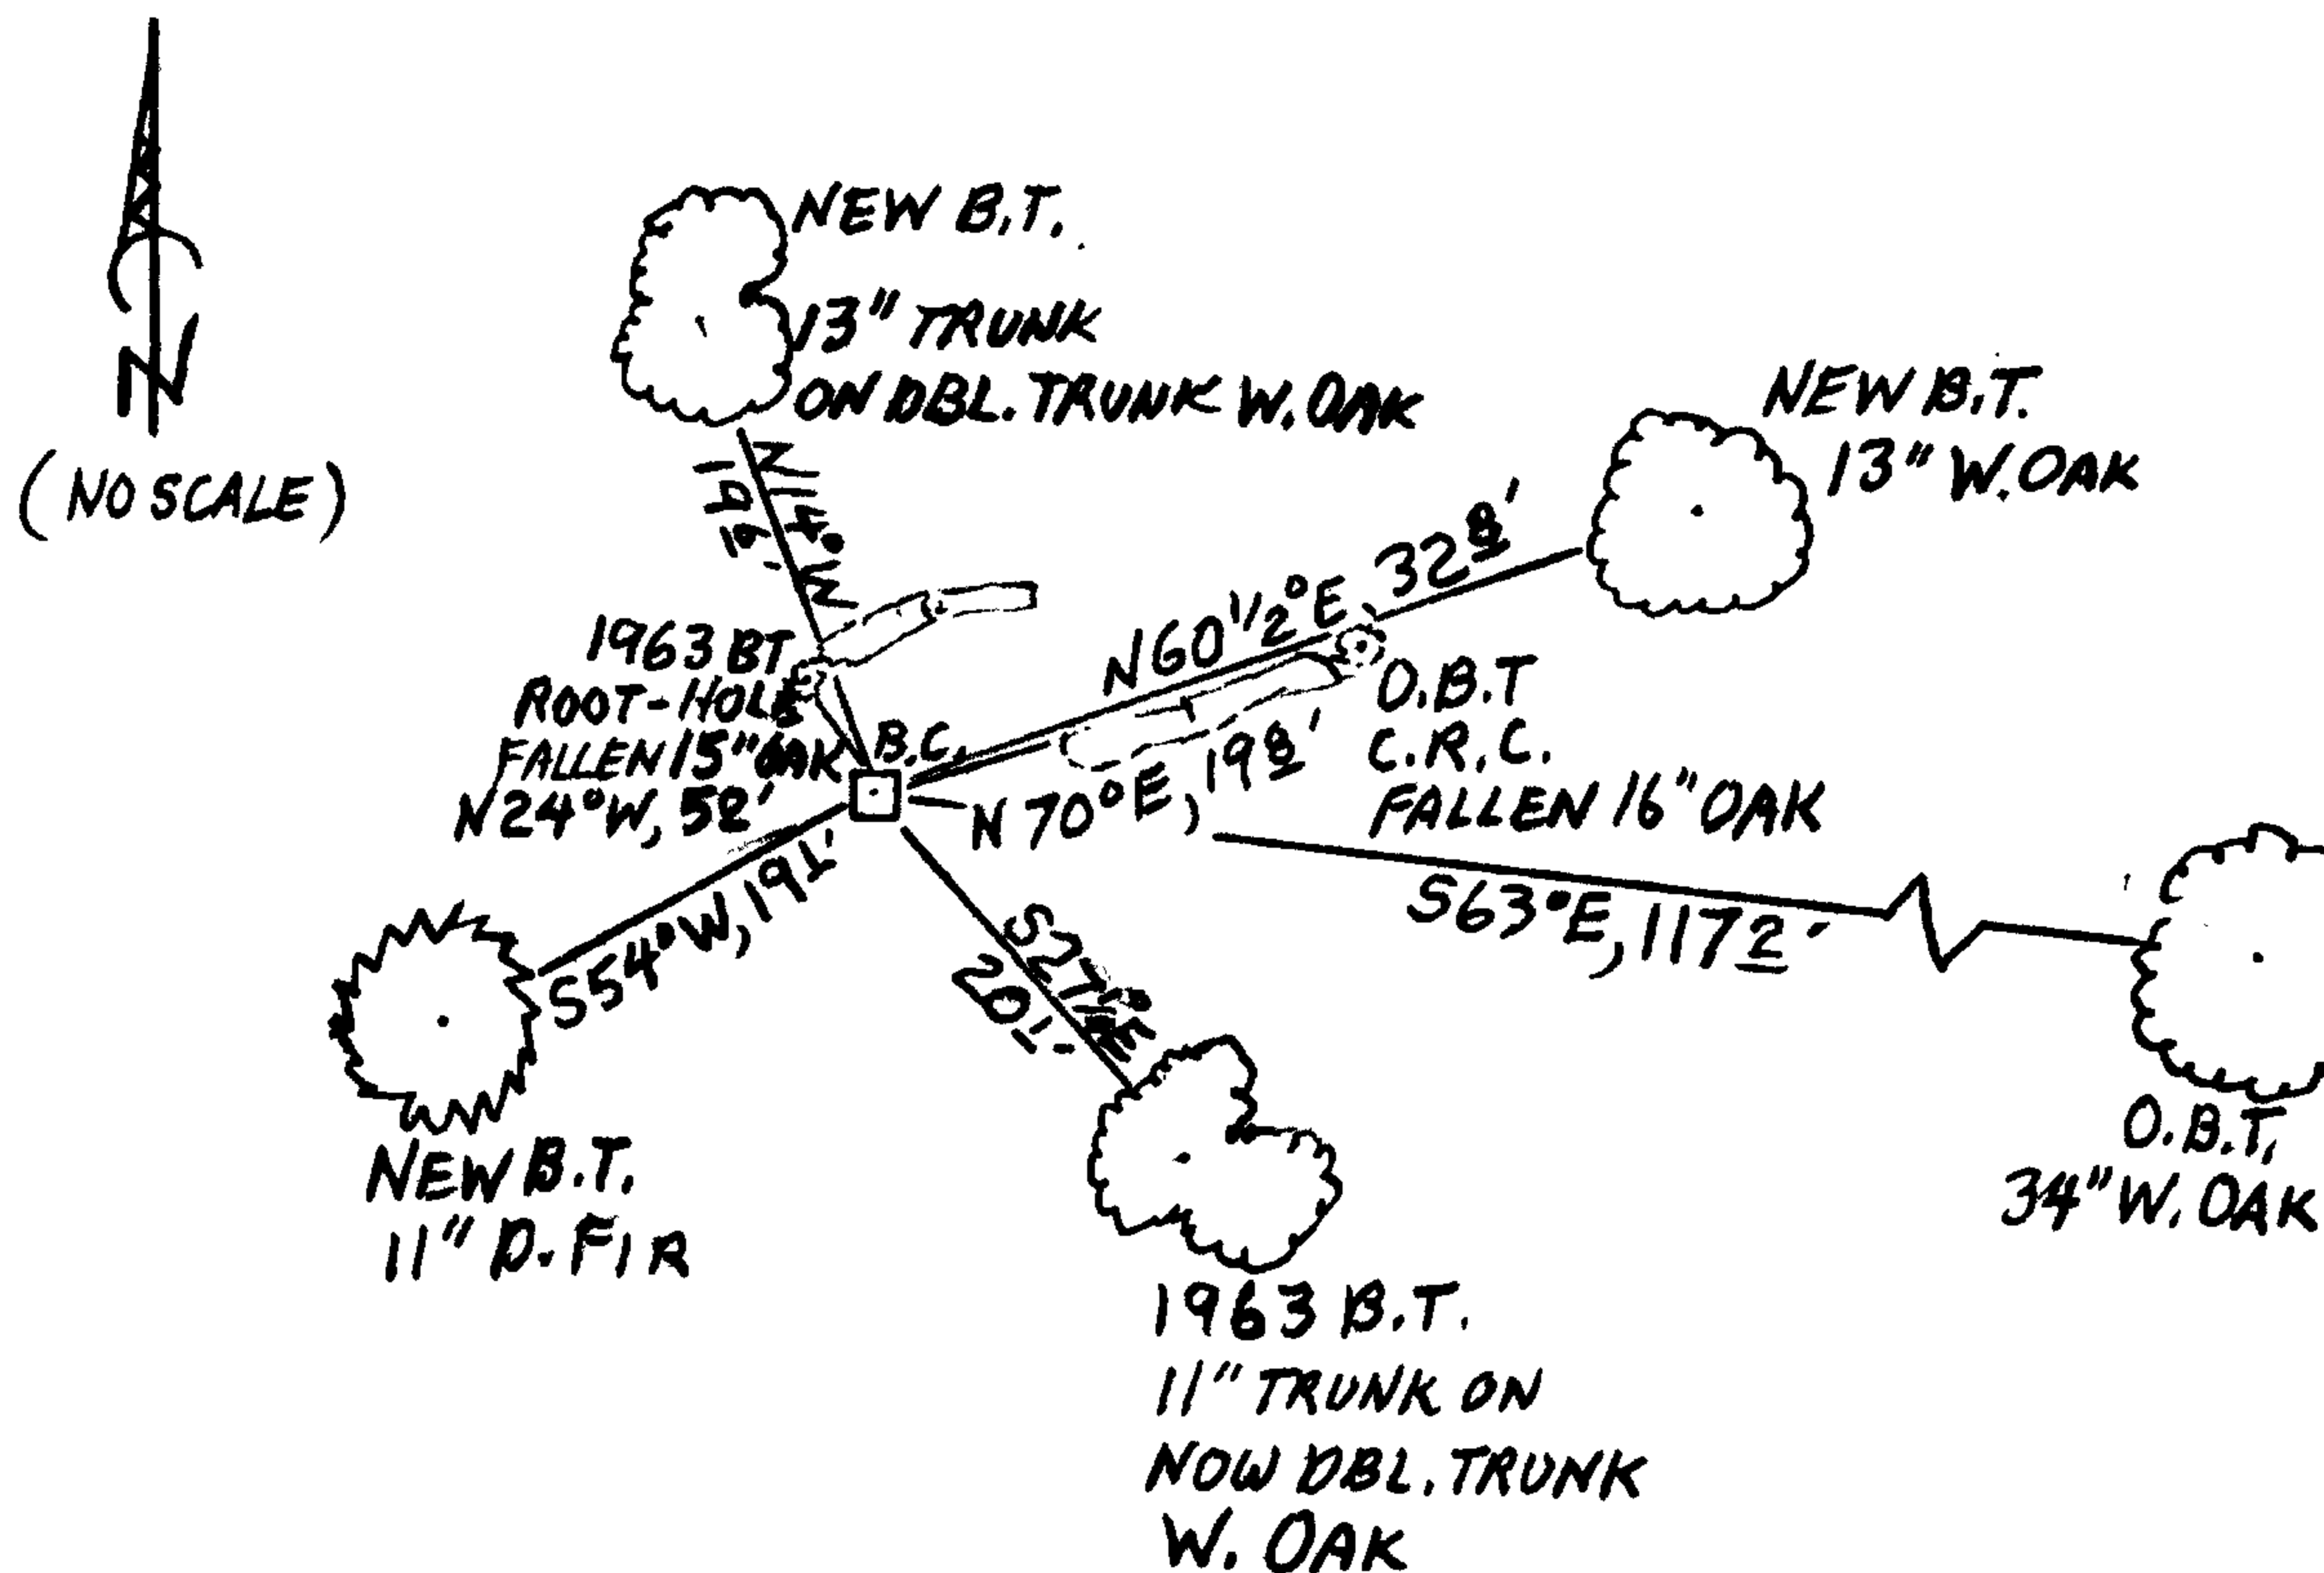

MONUMENT IS APPROX 10 FEET SOUTH AND 18 FEET WEST FROM A SMALL STREAM FLOWING WESTERLY. MONUMENT IS IN A GENTLY ROLLING STREAM BOTTOM IN AN OAK AND FIR WOODLAND.

Comp. Decline. 15 1/2° E
Agency D.C.S.O.
Party Chief STEPHEN JOHN FLAUSE
Note keeper Stephen John Flause
Witnesses MIKE S. KOCH

Surveyor's Seal

REGISTERED PROFESSIONAL LAND SURVEYOR

Randall W. Smith
R070004-6-30-2014

OREGON
JULY 25, 1990
RANDALL W. SMITH
2400