

GOVERNMENT CORNER RESTORATION FORM

FILED

TOWNSHIP 24S RANGE 04W SEC. 27 PLSS # 044040

Date: 1-7-2014 By: JC
This survey consists of:

DOUGLAS COUNTY OREGON

DATE DEC. 10, 2013

Map: _____

Narrative: _____

Corner Designation

Corner Rpt: CS 67/41-5

DOUGLAS COUNTY
SURVEYOR

INTL
NE | DLC 44
DLC 45 |

- _____ Condition Report
- _____ Not Found
- Renewed
- _____ Unrecorded
- _____ Surveyed In
- _____ Referenced Out

Previous Renewals 1963
Monument (s) Found: _____ (Condition and Source)

MONUMENT DETAIL

FROM THE 1963 RENEWAL:
A 2 1/2 INCH DIAMETER BRASS CAP (MARKED AS AT RIGHT)
ON A 1 INCH I.D. IRON PIPE FIRMLY SET, PROTRUDING
10 INCHES ABOVE GROUND.

COUNTY SURVEYORS OFFICE
T 24 S
R 4 W

INTL
NE | DLC
DLC | 44
45 |

1963

Accessories Found

EVIDENCE OF THE ONE ORIGINAL BEARING TREE.
A FIR, 50" DIA. NOW A ROTTED FIR STUMP AVERAGING 43 INCHES IN DIAM. AND 4 FEET
TALL WITH A PREVIOUSLY OPENED BLAZE SHOWING THE ORIGINAL SCRIBING "BT"; BEARS
S 51° E, 216 6 FEET DISTANT (ORIGINAL RECORD S 51° E, 214 5 FT. IS A GOOD FACE MEASUREMENT).

THE TWO 1963 RENEWAL BEARING TREES.
A 12" W. OAK, NOW A 13 INCH DIAM. WHITE OAK WITH A FULLY HEALED DOUBLE BLAZE; BEARS S 42° E,
11 3 FEET DISTANT (AS PER RECORD).
A 18" W. OAK, NOW A 26 INCH DIAM. WHITE OAK WITH A FULLY HEALED DOUBLE BLAZE; BEARS S 14° W,
35 6 FEET DISTANT (AS PER RECORD).

N/A

N/A


New Accessories

AN 18 INCH DIAM. DOUGLAS FIR SCRIBED "INTL DLC 44CS" "BT" ON A DOUBLE BLAZE;
BEARS S80°12'E, 28⁶ FEET DISTANT.

A 16 INCH DIAM. DOUGLAS FIR SCRIBED "NE DLC 45" "CS BT" ON A DOUBLE BLAZE;
BEARS S39°W, 10³ FEET DISTANT.

Sketch of Monument, Accessories, and General Area

Location & Comments

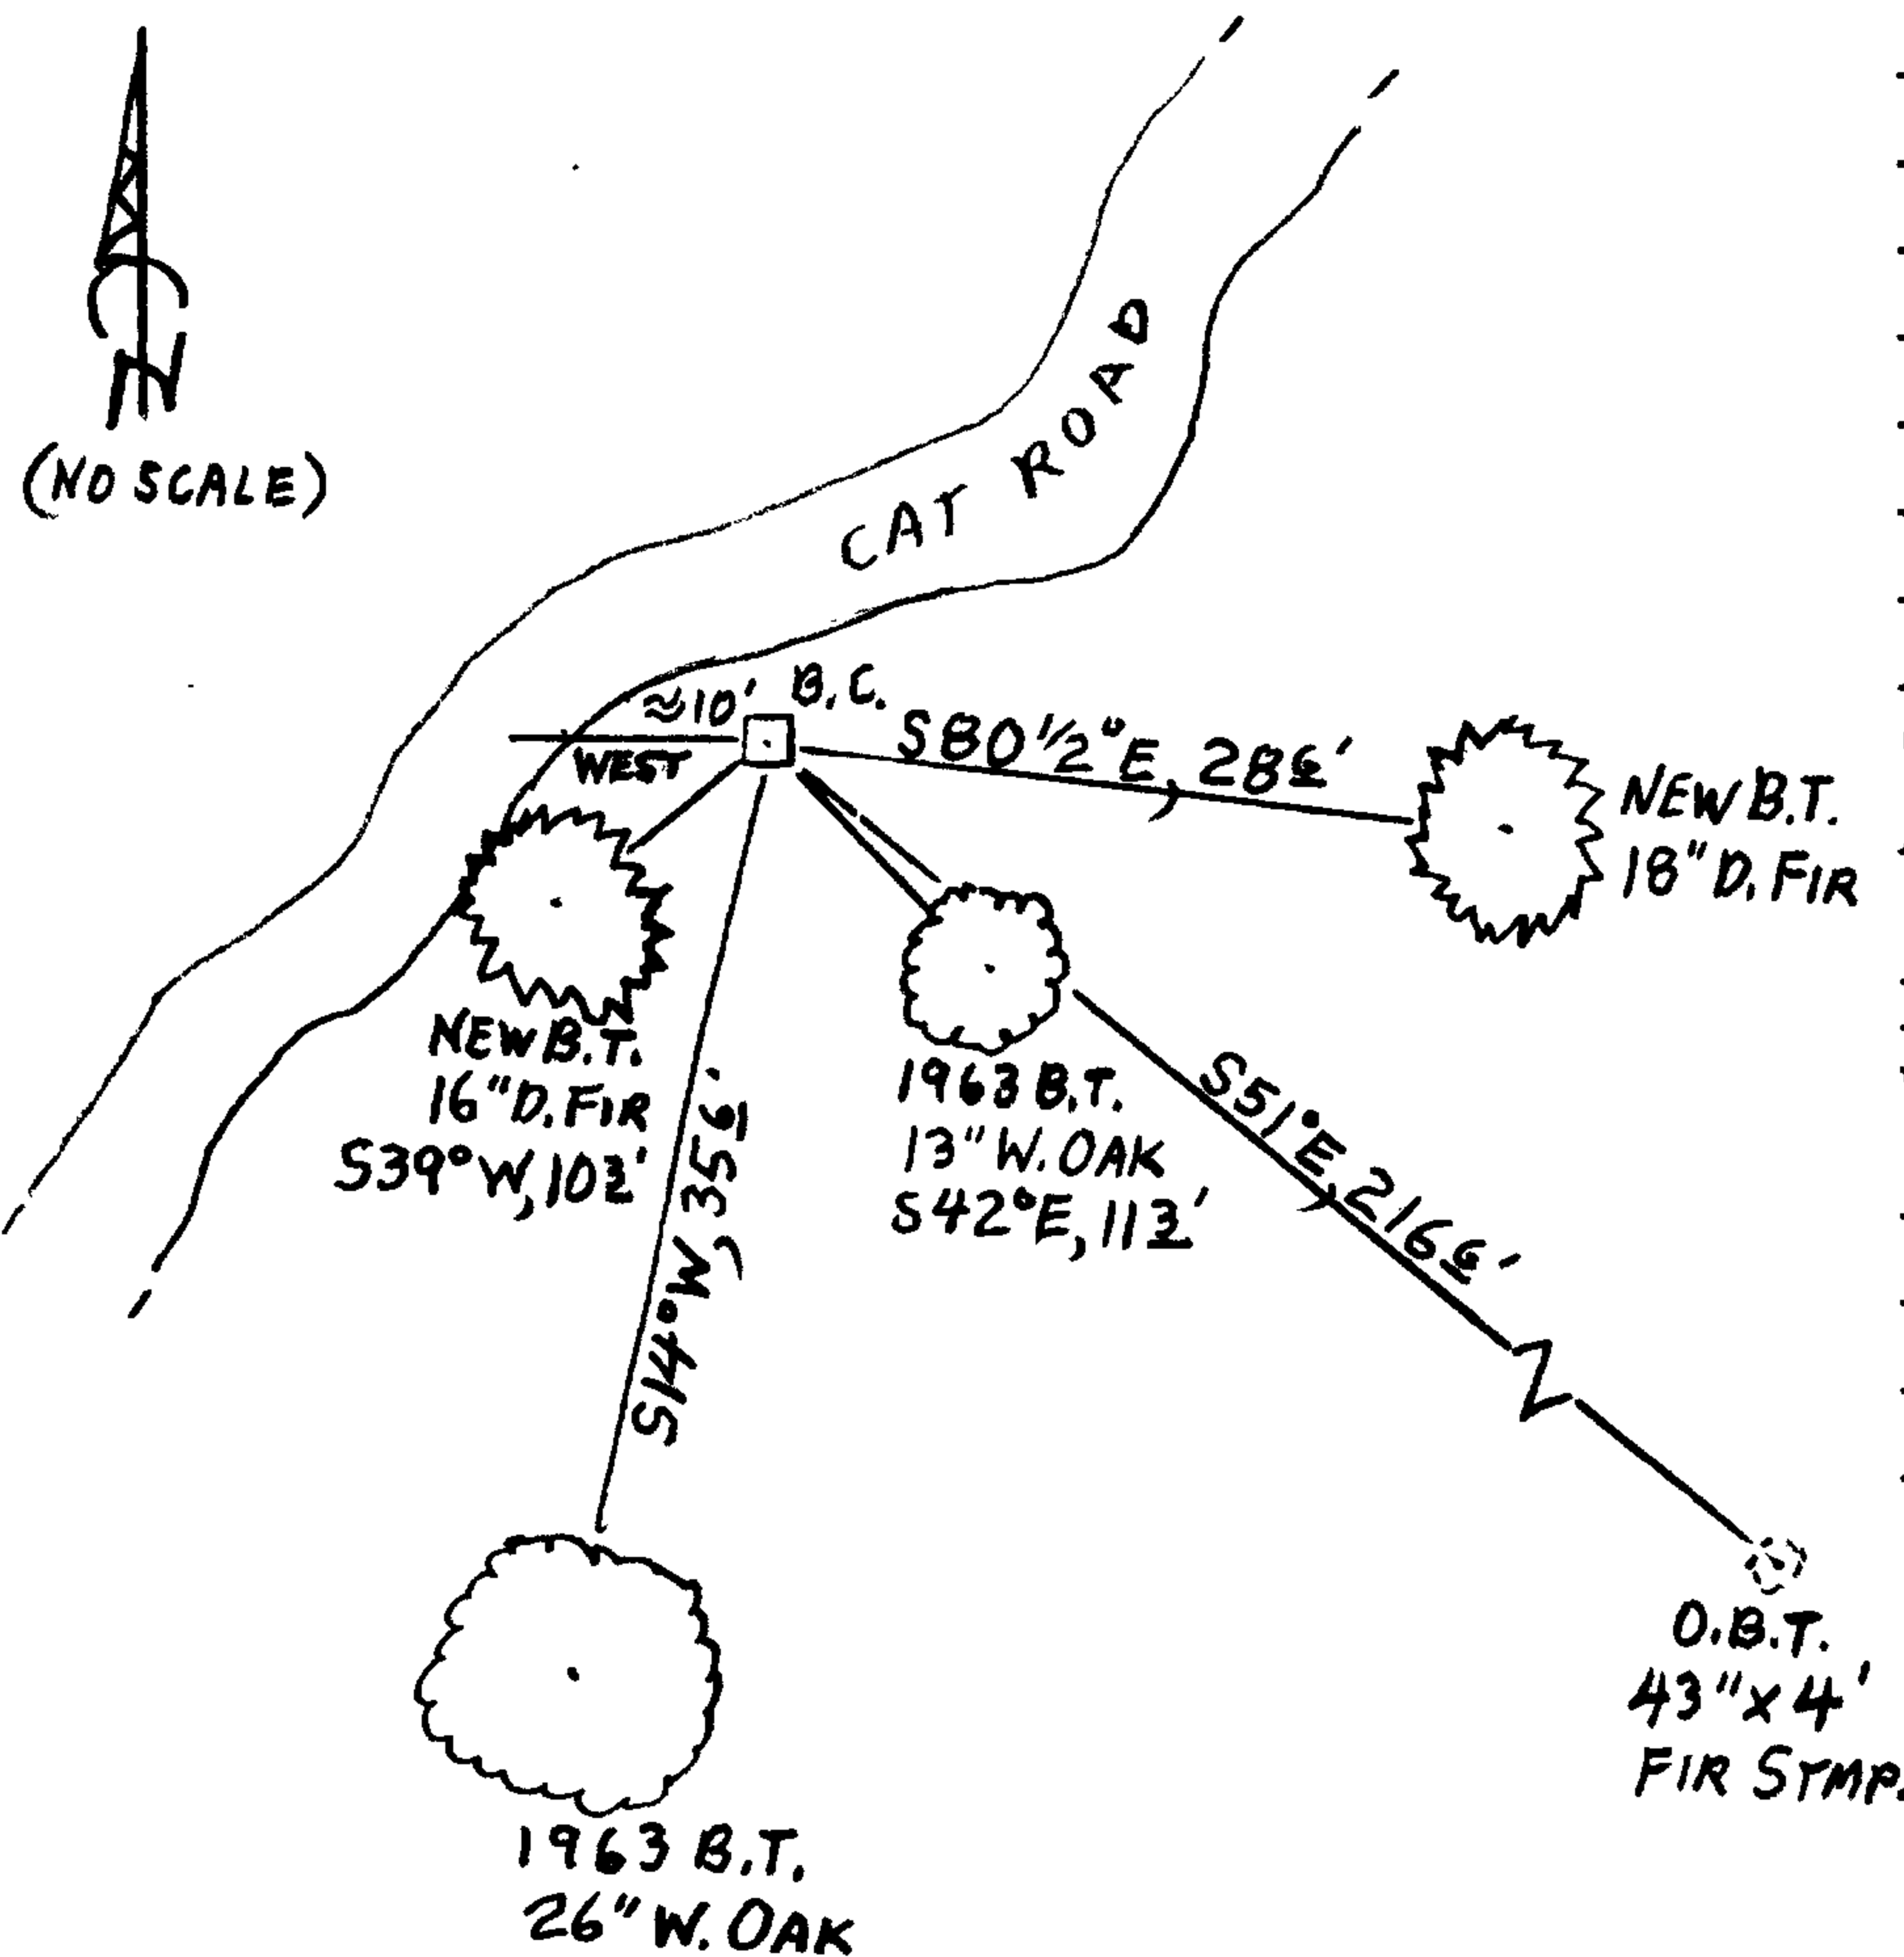

B.C. MONUMENT IS ABOUT 10 FEET EAST OF A MEANDERING, GENERALLY N-S RUNNING CAT ROAD AND ON A VERY GENTLE NW SLOPE IN AN OLD SECOND GROWTH FIR AND OAK WOODLAND.

Comp. Decline. 15°12'E
Agency D.C.S.U.
Party Chief STEPHEN JOHN FLAUSE
Note keeper Stephen John Flouse
Witnesses MIKE S. KOCH

Surveyor's Seal

REGISTERED PROFESSIONAL LAND SURVEYOR

Randall W. Smith

OREGON
JULY 25, 1990
RANDALL W. SMITH
2400

Lowon AL 6-30-2017