

GOVERNMENT CORNER RESTORATION FORM

FILED

TOWNSHIP 24S RANGE 04W SEC. 27 PLSS # 044050

Date: 1-7-2014 By: X

This survey consists of:

DOUGLAS COUNTY OREGON

DATE DEC. 11, 2013

Map: \_\_\_\_\_

Narrative: \_\_\_\_\_

Corner Designation

Corner Rpt: CS 67/41-6

DOUGLAS COUNTY SURVEYOR

ESE | SSW  
DLC45 | DLC44

Previous Renewals 1963  
Monument(s) Found: \_\_\_\_\_ (Condition and Source)

- \_\_\_\_\_ Condition Report
- \_\_\_\_\_ Not Found
- Renewed
- \_\_\_\_\_ Unrecorded
- \_\_\_\_\_ Surveyed In
- \_\_\_\_\_ Referenced Out

FROM THE 1963 RENEWAL:  
A 2 1/2 INCH DIAMETER BRASS CAP (MARKED AS AT RIGHT)  
ON A 1 1/2 INCH I.D. IRON PIPE FIRMLY SET AND PRO-  
TRUDING 8 INCHES ABOVE GROUND.

MONUMENT DETAIL

COUNTY SURVEYOR'S OFFICE  
T. 24 S.

E.S.E. | S.S.W.  
D.L.C.45 | D.L.C. 44  
R. 4 W.  
1963

Accessories Found

EVIDENCE OF ONE ORIGINAL BEARING TREE.  
A FIR, 50" DIA. NOW A FALLEN AND ROTTEN 50+ INCH DIAMETER DOUGLAS FIR WITH A PREVIOUSLY  
OPENED BLAZE SHOWING THE ORIGINAL SCRIBING "BT". THE BROKEN 3 FOOT TALL STUMP OF THIS  
TREE BEARS N24°W, 244<sup>9</sup> FEET DISTANT (AS PER RECORD).  
NO EVIDENCE OF ORIGINAL SW BEARING TREE IS FOUND.

TWO 1963 RENEWAL BEARING TREES.  
A 10" D. FIR NOW A 19 INCH DIAM. DOUGLAS FIR WITH A FULLY HEALED DOUBLE BLAZE ; BEARS  
N43°E, 3.3 FEET DISTANT (AS PER RECORD).  
AN 8" D. FIR NOW AN 11 INCH DIAM. DOUGLAS FIR WITH A FULLY HEALED DOUBLE BLAZE ; BEARS  
N67°W, 8<sup>5</sup> FEET DISTANT (AS PER RECORD).

C.S. File 67/41-6

N/A

N/A


New Accessories

A 15 INCH DIAM. DOUGLAS FIR SCRIBED "SSW DLG 44 CS" "BT" ON A DOUBLE BLAZE; BEARS S46°E, 11' FEET DISTANT.

A 7 INCH DIAM. DOUGLAS FIR SCRIBED "X" "CSBT" ON A HIGH-LOW BLAZE; BEARS S67½°W, 26' FEET DISTANT.

Sketch of Monument, Accessories, and General Area

Location & Comments

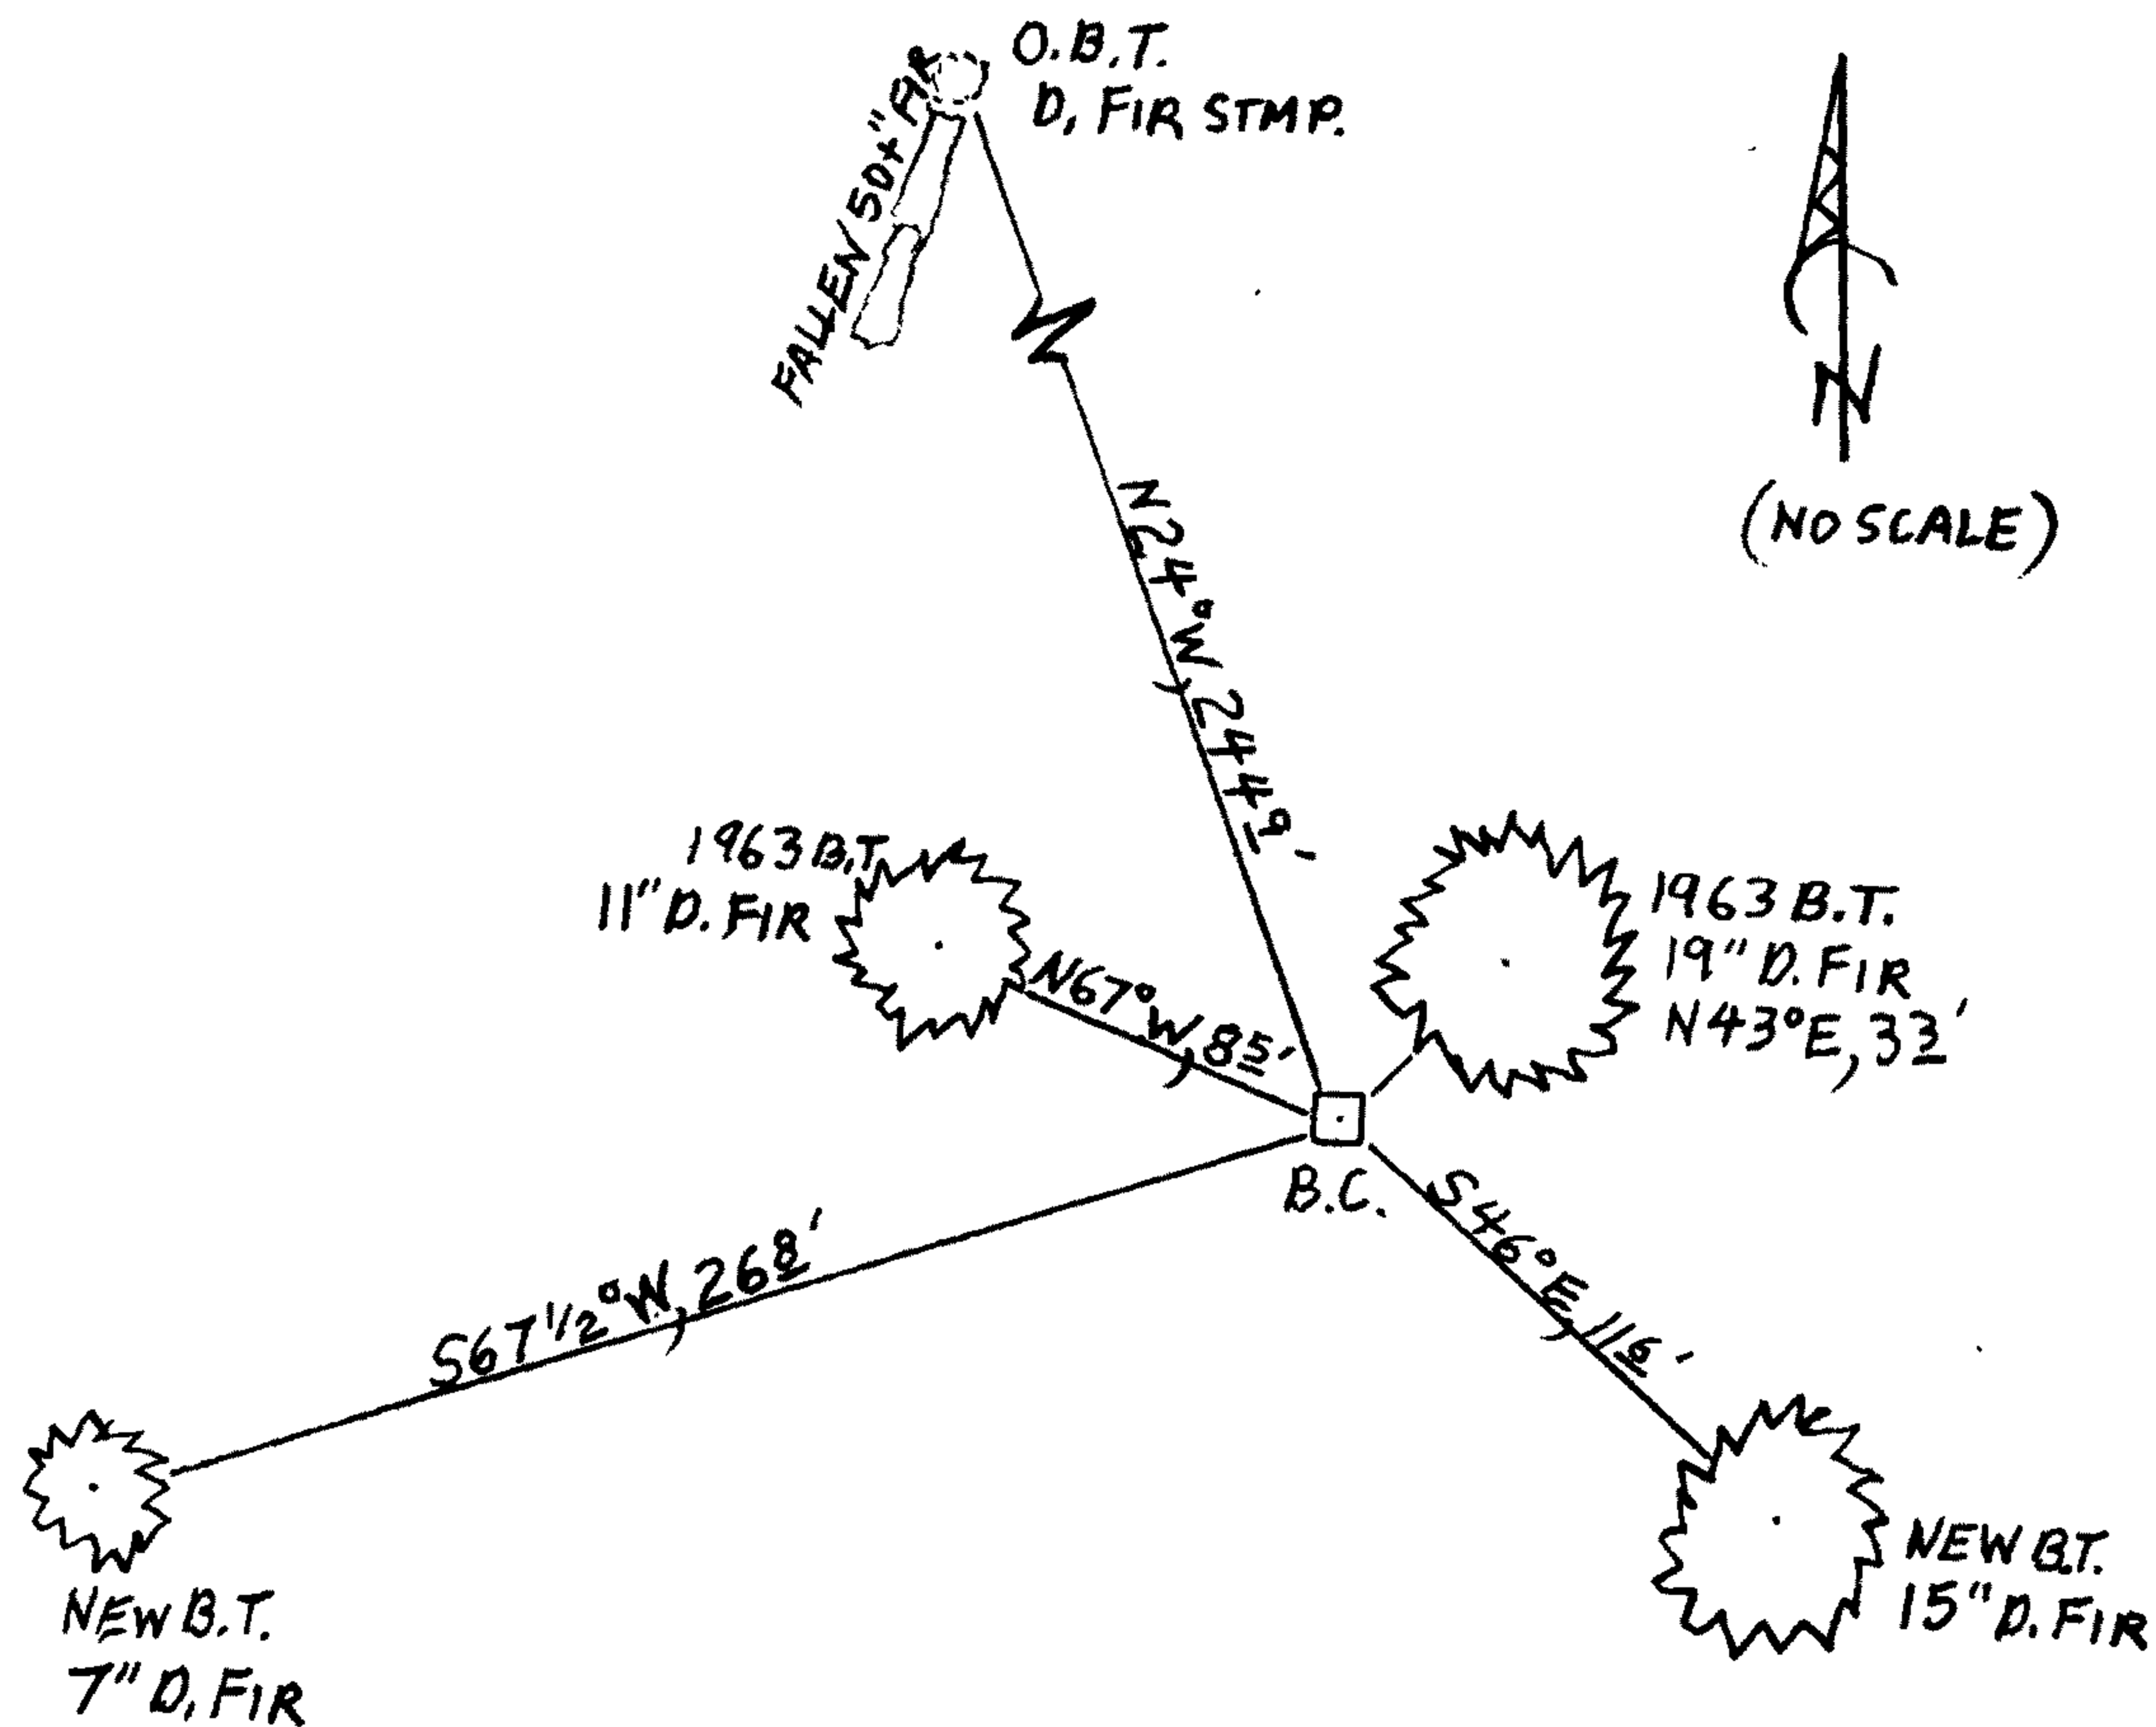

B.C. MONUMENT IS ON MODERATE NW SLOPE NEAR NORTH EDGE OF THINNED OLDER REPROD FIR FOREST.

Comp. Decline. 15½°E  
Agency D.C.S.O.  
Party Chief STEPHEN JOHN FLAUSE  
Note keeper Stephen John Flause  
Witnesses MIKE S. KOCH

Surveyor's Seal

REGISTERED PROFESSIONAL LAND SURVEYOR

*Randall W. Smith*

OREGON  
JULY 25, 1990  
RANDALL W. SMITH  
2488

RENEWAL 6-30-2014