

GOVERNMENT CORNER RESTORATION FORM

FILED

TOWNSHIP 24S RANGE 04W SEC. 28 PLSS # 043030

Date: 1-13-2014 By: JC

This survey consists of:

DOUGLAS COUNTY OREGON

DATE DEC. 17, 2013

Map: _____

Narrative: _____

Corner Rpt: CS 67/41-10

Corner Designation

DOUGLAS COUNTY SURVEYOR

SW
DLC43

- Condition Report
- Not Found
- Renewed
- Unrecorded
- Surveyed In
- Referenced Out

Previous Renewals 1963
Monument(s) Found: _____ (Condition and Source)

MONUMENT DETAIL

THE 1963 RENEWAL MONUMENT:
A 2 1/2 INCH DIAMETER BRASS CAP (MARKED AS AT RIGHT)
ON A 1 INCH I. D. IRON PIPE PROTRUDING 10 INCHES
ABOVE GROUND AND LEANING SOUTHERLY 06+ FEET.

COUNTY SURVEYOR'S OFFICE
T. 24S,

S.W. |
COR. |
DLC. 43
R 4W
1963

Accessories Found (ACCESSORIES ARE MEASURED FROM PLUMB POSITION OF BC MON.)

NO EVIDENCE REMAINS OF THE ORIGINAL B.T.

TWO 1963 BEARING TREES ARE IN GOOD CONDITION

AN 8" W. OAK NOW 17 INCH DIAM. WHITE OAK WITH A FULLY HEALED DOUBLE BLAZE; BEARS S69°E,
55± FEET DISTANT (AS PER RECORD).

A 26" D. FIR NOW A 50 INCH DIAM. DOUGLAS FIR WITH A FULLY HEALED DOUBLE BLAZE; BEARS S26°W,
77± FEET DISTANT (AS PER RECORD).

RENEWAL

Monument Set (Procedure and Description)

MONUMENT DETAIL

N/A

A 6 INCH AND 10 INCH DIAMETER FIR ROOT THAT CAUSED B.C. MONUMENT TO TILT SOUTHERLY ARE AXED AND CHAIN-SAWN AWAY AND MONUMENT IS RETURNED TO ITS PLUMB POSITION. MONUMENT NOW PROTRUDES 11 INCHES ABOVE GROUND.


New Accessories

A 16 INCH DIAM. DOUGLAS FIR SCRIBED "SW DLC 43 CS BT" ON A DOUBLE BLAZE; BEARS N 22° E, 15 1/2 FEET DISTANT.

A 10 INCH DIAM. DOUGLAS FIR SCRIBED "SW DLC 43 CS BT" ON A DOUBLE BLAZE; BEARS N 36 1/2° W, 16 1/2 FEET DISTANT

Sketch of Monument, Accessories, and General Area

Location & Comments

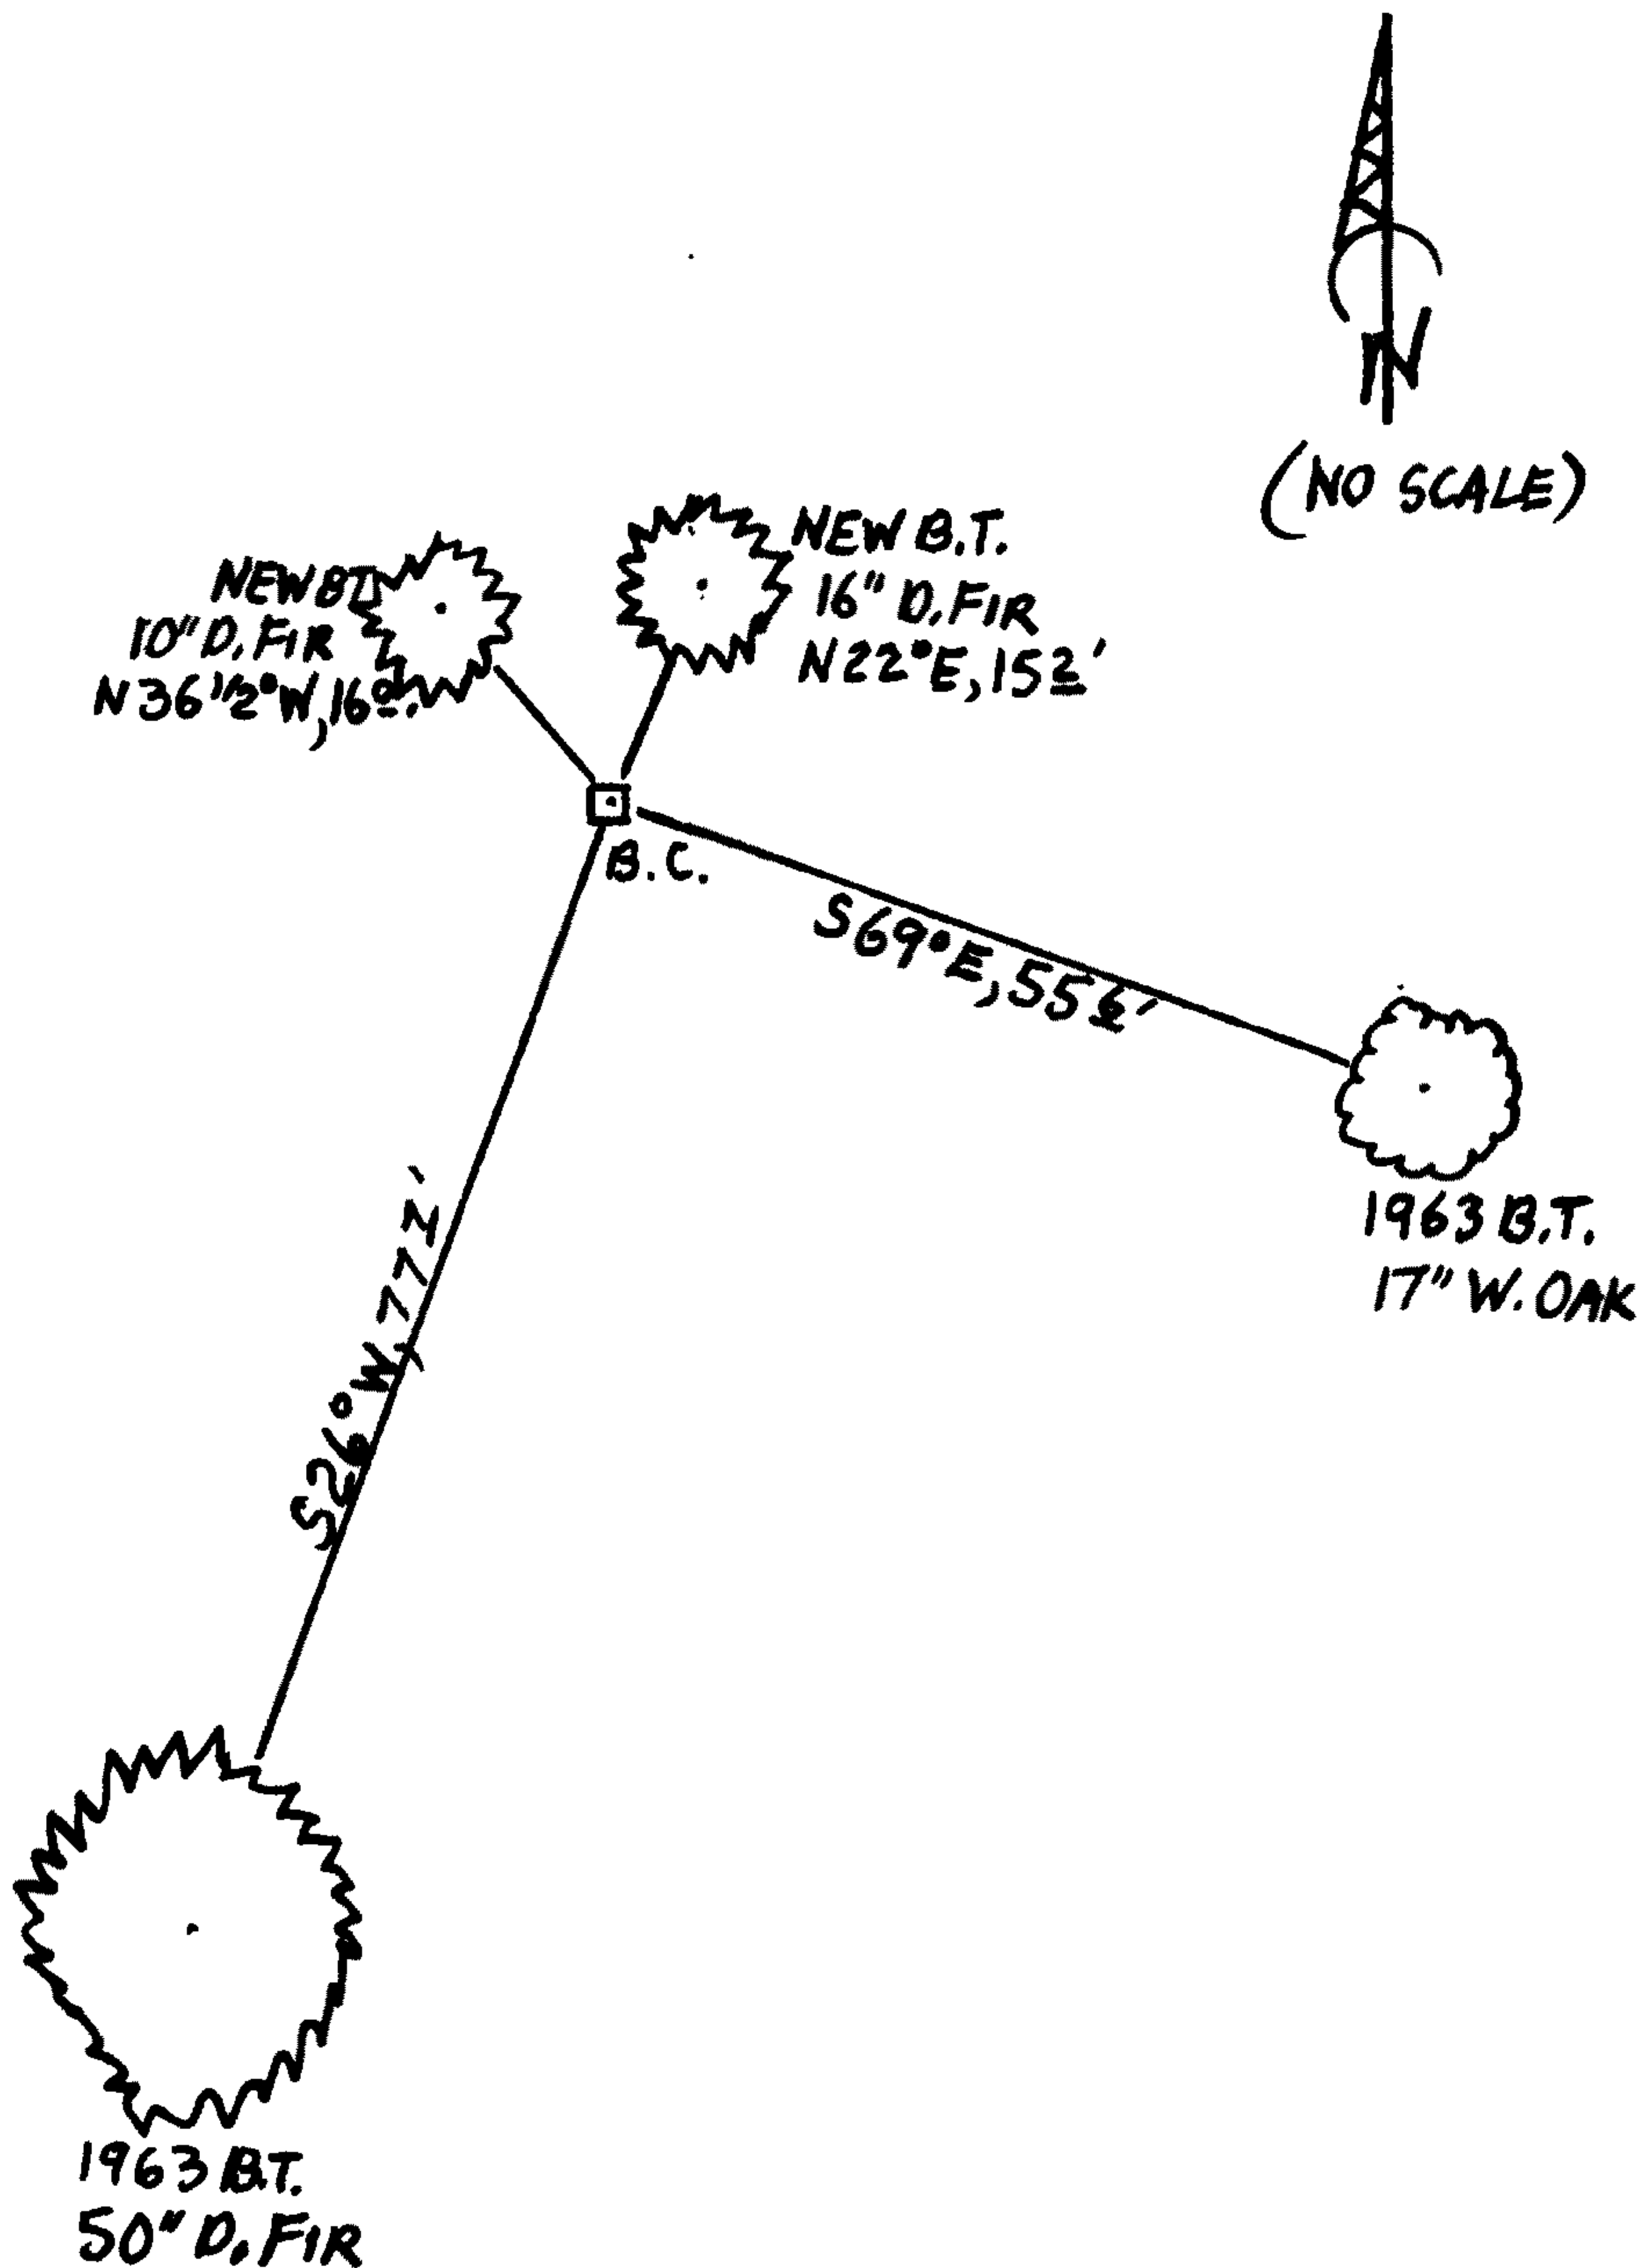

B.C. MONUMENT IS ON MODERATE NE SLOPE IN OLDER REPROD FIR FOREST WITH AN OAK AND HAWTHORN UNDERSTORY.

Comp. Decline. 15 1/2° E
Agency D.C.S.D.
Party Chief STEPHEN JOHN FLAUSE
Note keeper Stephen John Flause
Witnesses MIKE S. KOCH

Surveyor's Seal

REGISTERED PROFESSIONAL LAND SURVEYOR

Randall W. Smith

OREGON
JULY 25, 1990
RANDALL W. SMITH
2400

RENEWAL 6-30-2014